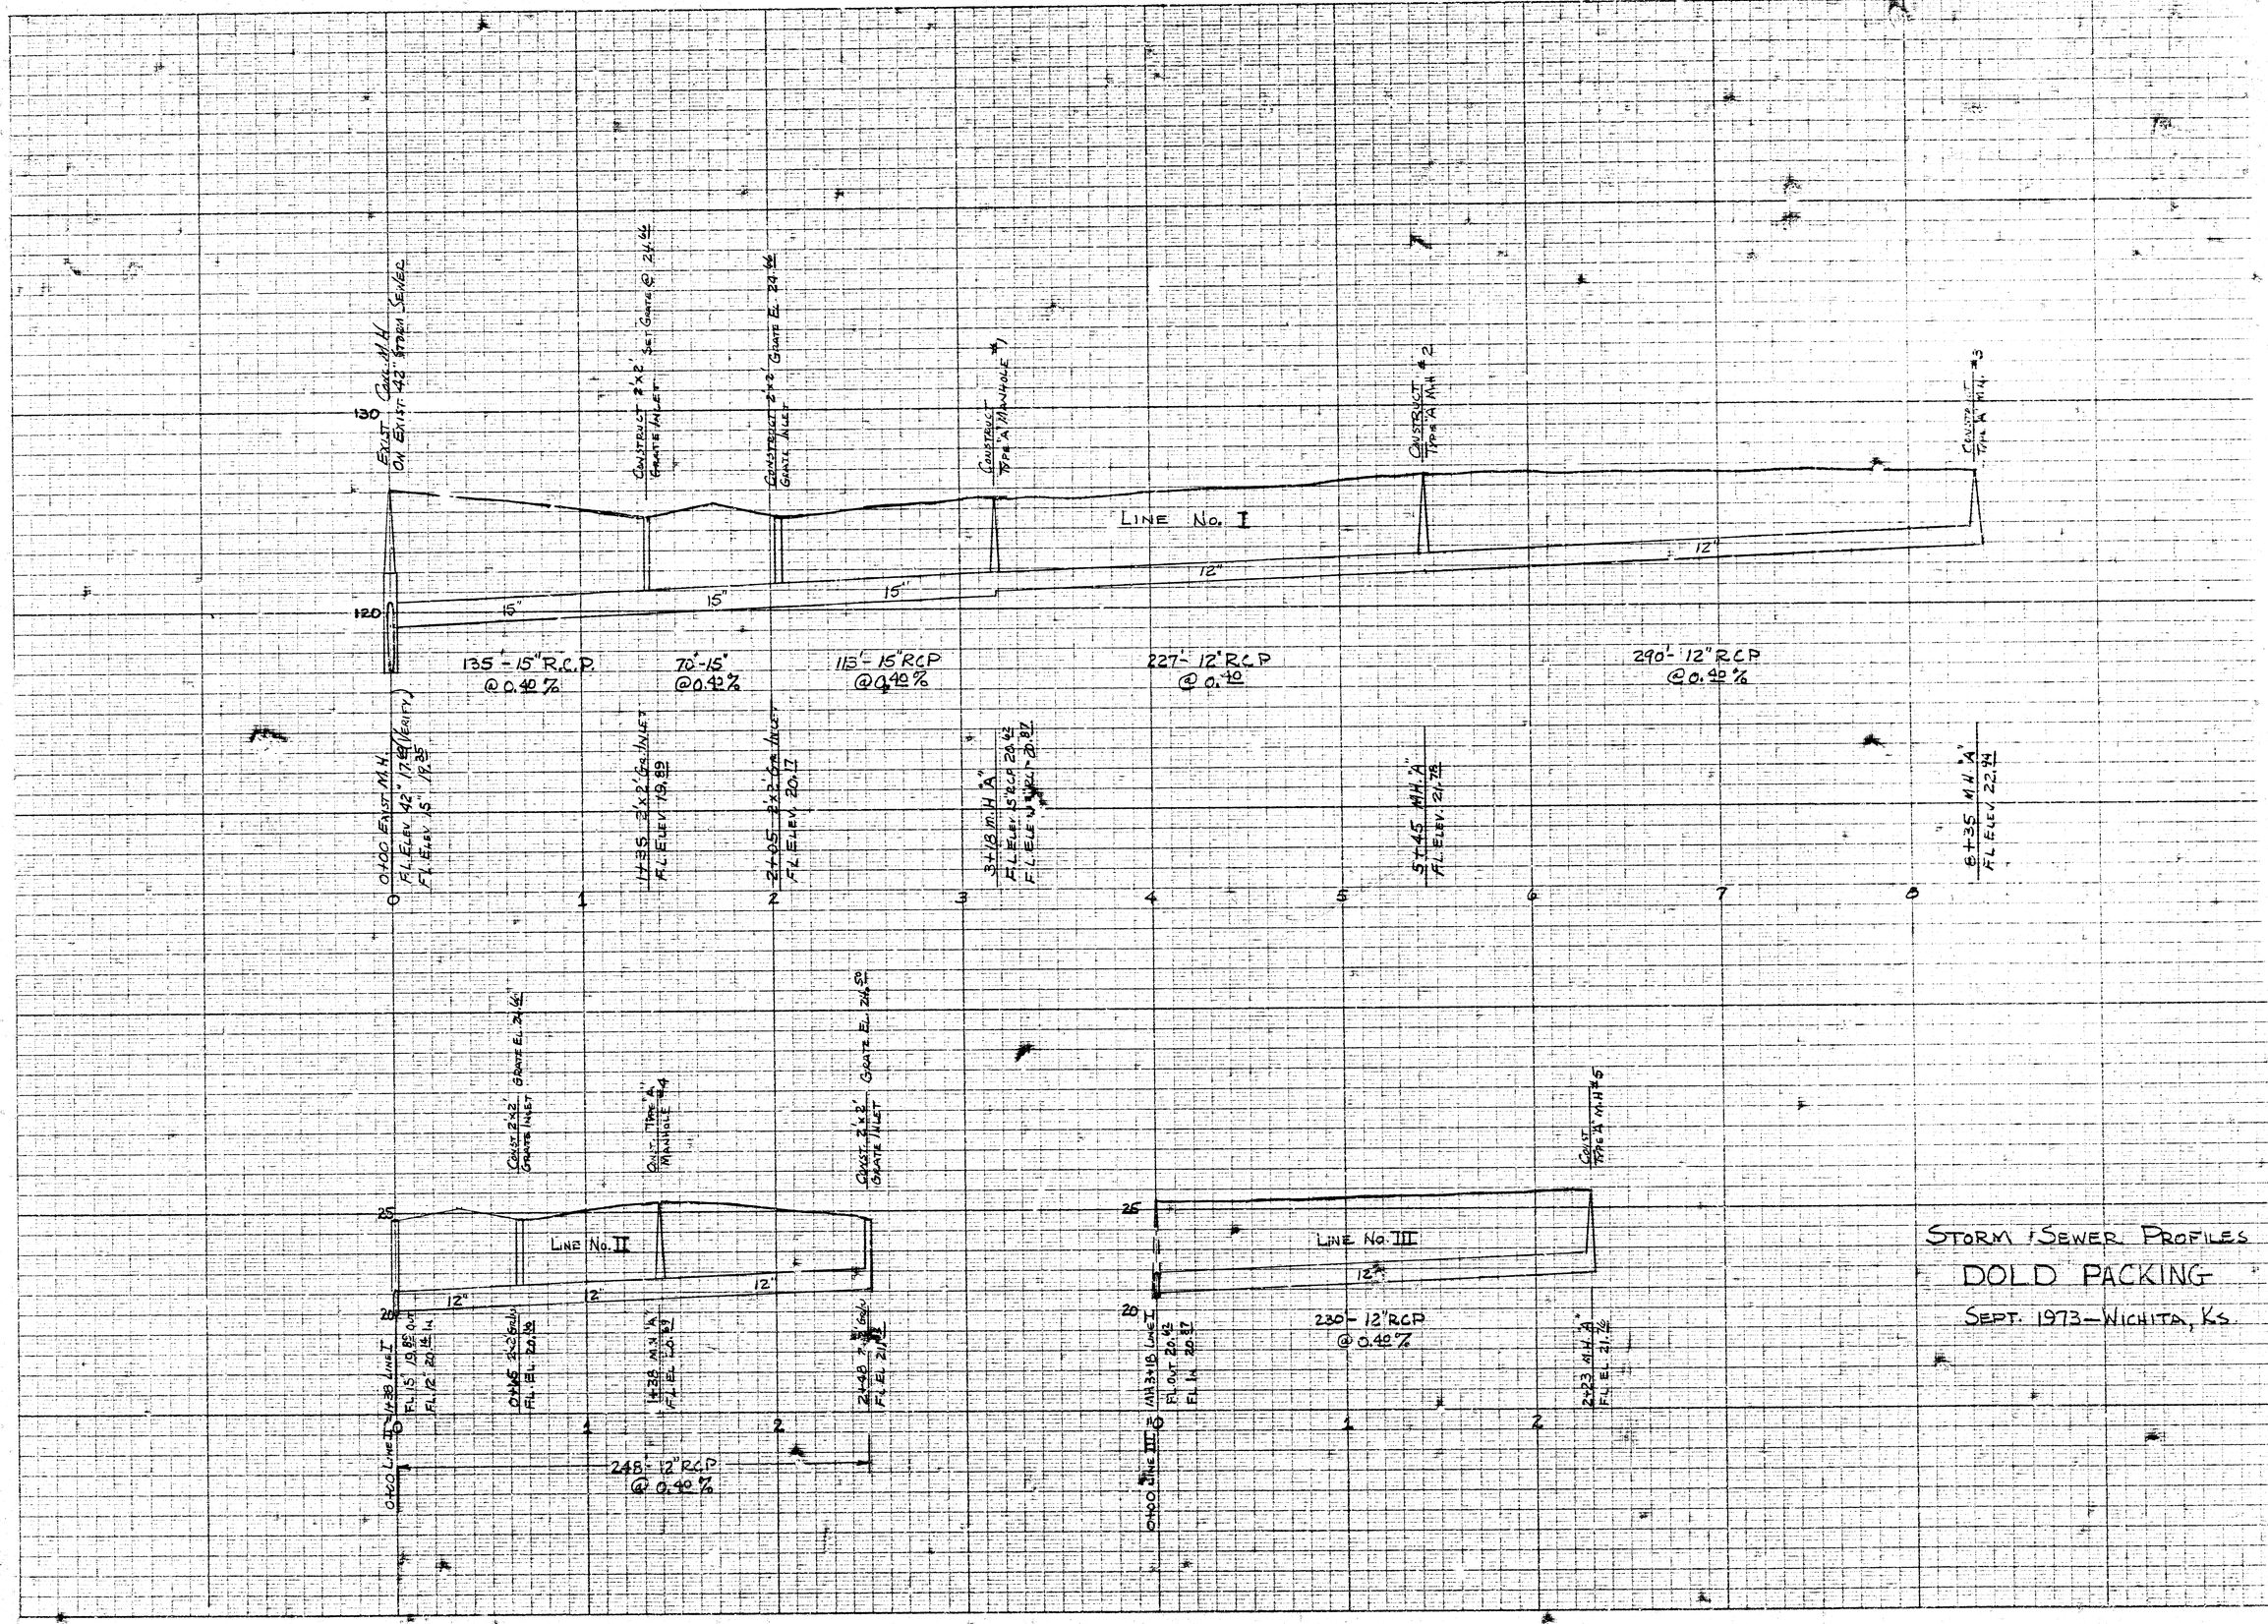

STORM SEWER PROFILES

DOLD PACKING

SEPT. 1973—WICHITA, KS.

"CLEARPRINT" PROFILE PLATE A
CLEARPRINT PAPER CO.

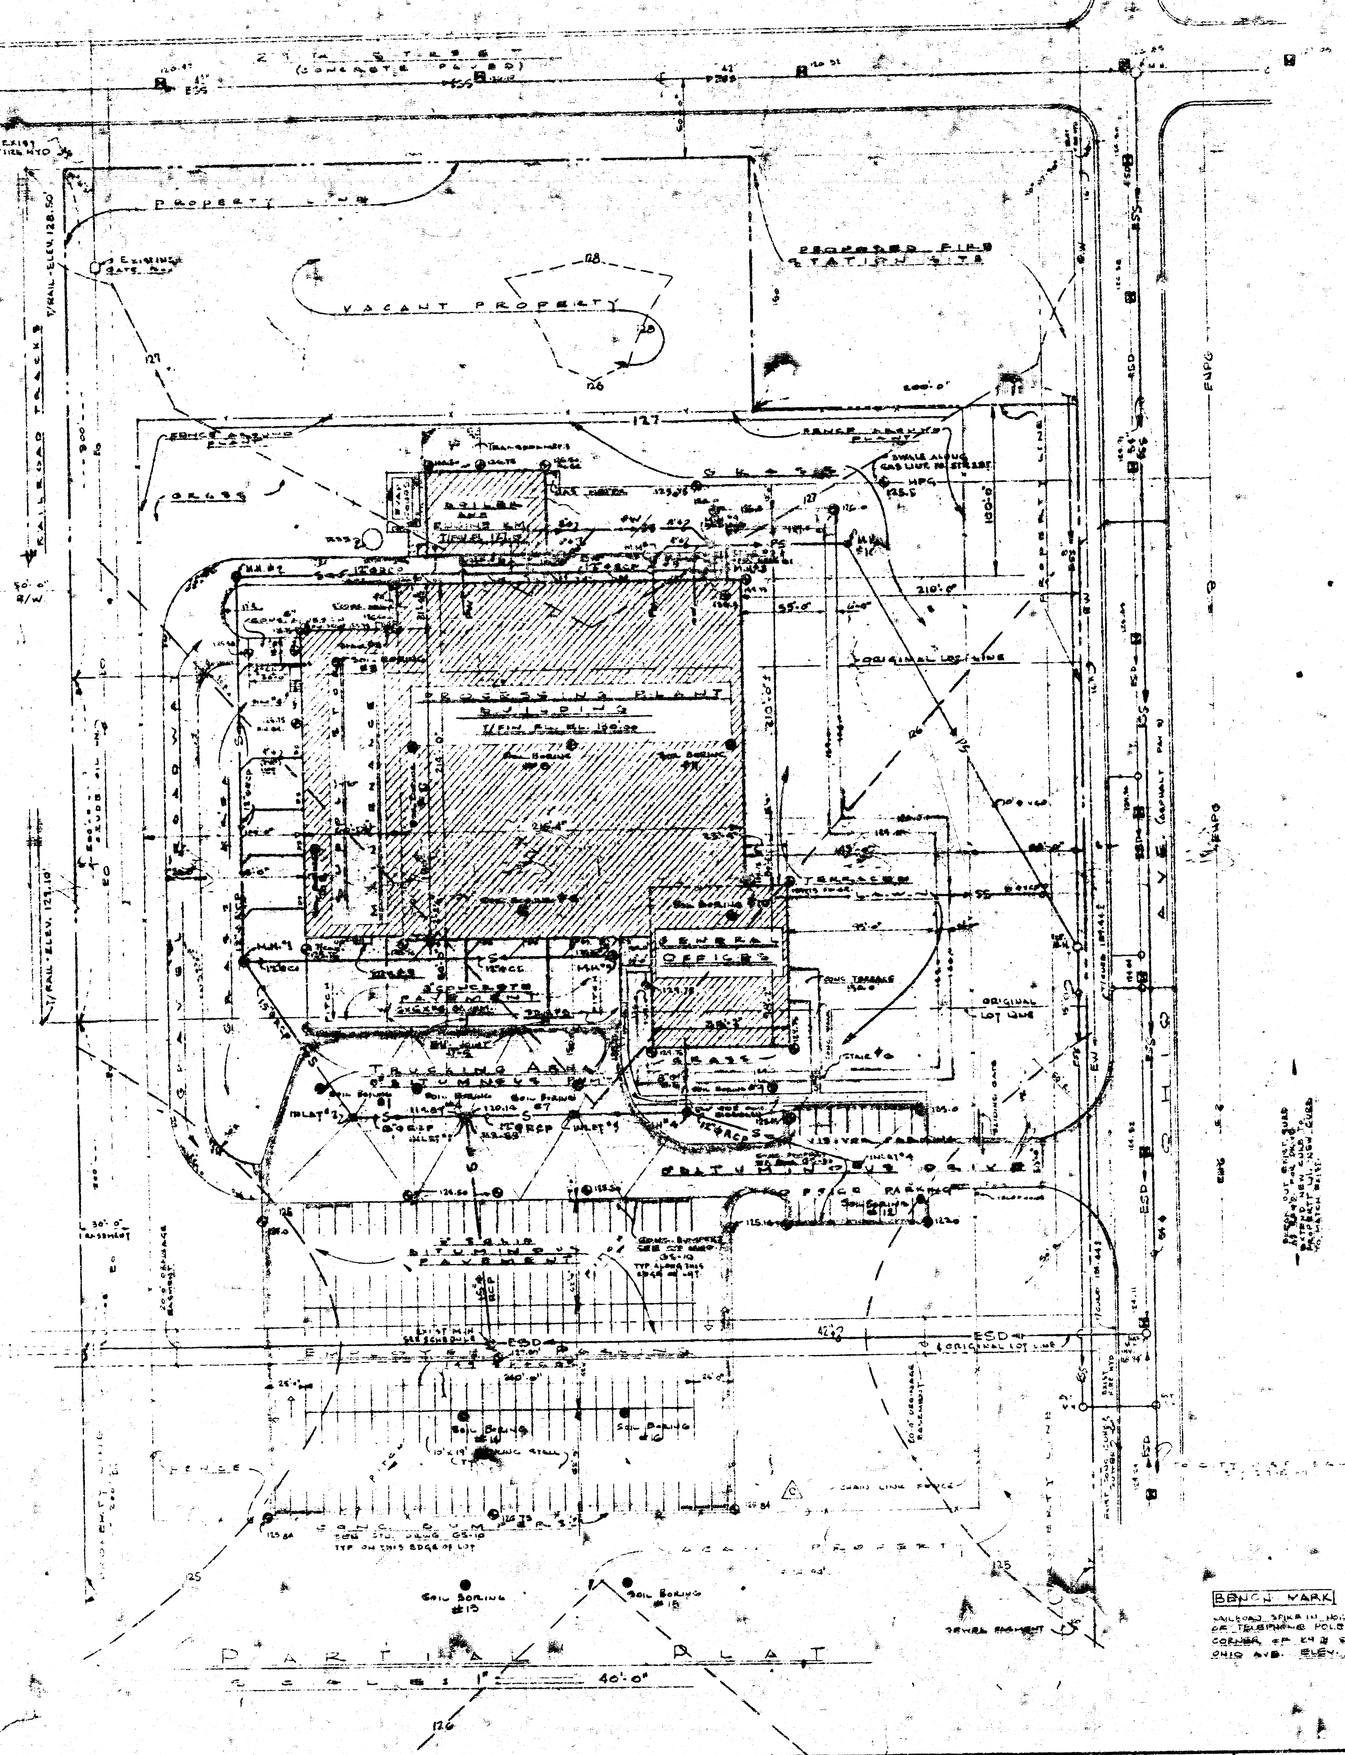

MK	INLET SIZE	INLET INVERT	OUTLET SIZE	OUTLET INVERT	OUTLET PITCH	TOP OF COVER ELEVATION	REMARKS
1	12"ø 12"ø	126.57'	15"ø	120.62'	0.40%	125.5'	See Notes 17, 18 & 19
2	12"ø	121.78'	12"ø	121.78'	"	126.5'	See Notes 17, 18 & 19 To MK 1
3	-	-	12"ø	122.34'	"	"	See Notes 17, 18 & 19 To MK 2
4	6"ø 12"ø	To Exit 120.69'	12"ø	120.63'	"	125.5'	See Notes 17, 18 & 19
5	12"ø	121.76'	12"ø	120.67'	"	125.75'	See Notes 17, 18 & 19 To MK 3
Exist. M.H.	15"ø	118.85'	42"ø	117.60' ±	-	Ground Elevation 126.15'	
6	6"ø	121.46'	6"ø	121.46'	1/8"/Ft	124.50'	Precast Conc. or Brick Std. Dwg. PB-3 or PB-4 with Solid Cover
7	4"ø	120.12'	4"ø	120.12'	"	"	"
8	6"ø	119.79'	6"ø	119.79'	"	"	"
9	6"ø 4"ø 6"ø	119.71' " "	13"ø	119.71'	"	126.75'	"
10	13"ø	118.88'	10"ø	118.88'	"	126.00'	"

INLET SCHEDULE

MK		INLET SIZE	INLET INVERT	OUTLET PITCH	TOP OF COVER ELEVATION	REMARKS
1		13"ø 15"ø	120.14' 119.89'	0.45%	124.60'	Precast Conc. or Brick Std. Dwg. PB-5 w/Grate Cover
2	"	15"ø	120.17'	"	"	"
3	"	12"ø	124.40'	"	"	"
4		12"ø	121.13'	"	124.50'	"

NOTE: All inlets shall have 2'x4' inlet grates. Inlets shall be similar to Std. Dwg. PB-5 (Detail "F"), except for grates.

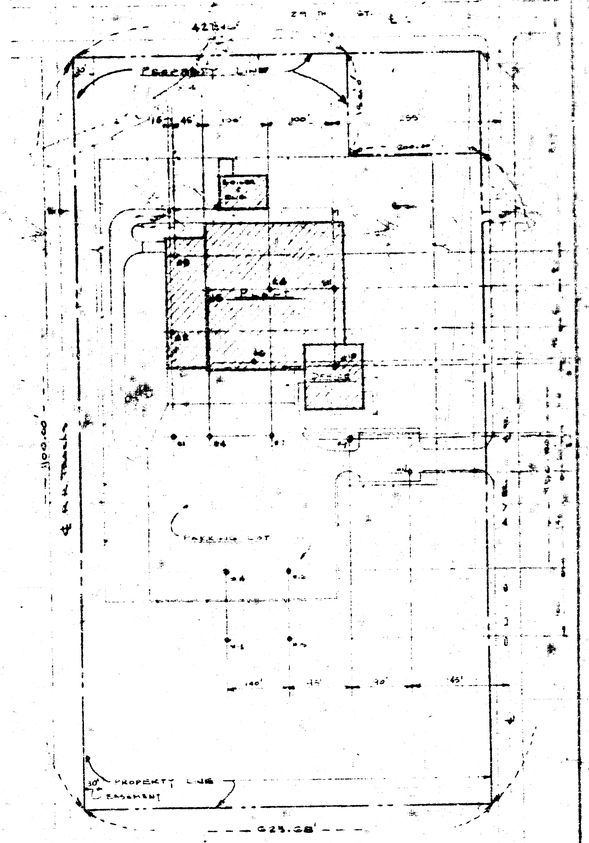

10-10-73

APPROVED AS NOTED
By CITY ENGINEER OF WICHITA
Sanitary Sewers
Storm Sewers D.E.F.
Driveway Approaches

NOTE TO CONTRACTOR

This project will be constructed under the supervision of the CITY ENGINEER and conforming to the SPECIFICATIONS of the CITY OF WICHITA. The CONTRACTOR will reimburse the City of Wichita for all cost of Engineering, Plans, and Inspection.

BENCH MARK
RAILROAD SPIKE IN NORTH SIDE OF TELEPHONE POLE S.E. CORNER OF 29TH ST & OHIO AVE. ELEV. 126.83'

Private Storm Sewer
Dold Packing Co.
Proj. No. BHKB503059

14 6 1 (7)

PLAT
SCALE: 1" = 100'-0"

17. RCP DENOTES REINF. CONC. SEWER PIPE
18. ALL INLETS SHALL HAVE 2'x2' GRATES
19. MANHOLES 1 THRU 5 SHALL CONFORM TO CITY TYPE 'A' MANHOLES WITH SOLID COVERS. INLETS SHALL [illegible] AS NOTED.