

BENCHMARK

"□" TOP OF INLET
8.5' N & 9' W.
OF N.W. PROP. COR.
ELEV. = 183.80
CITY DATUM

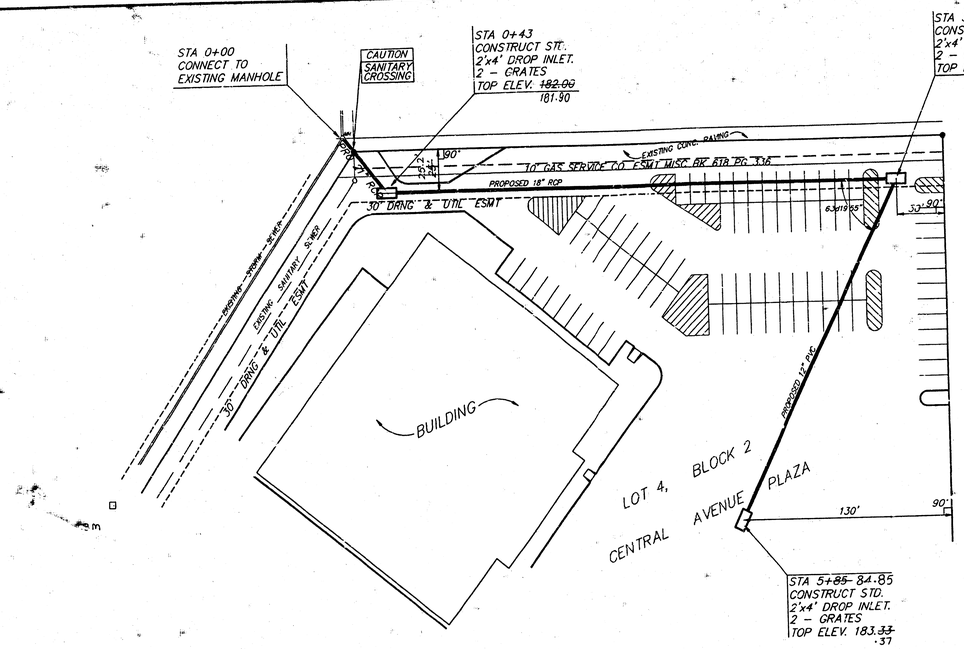

SCALE:
1" = 40' HORIZONTAL
1" = 5' VERTICAL
● : = IRON

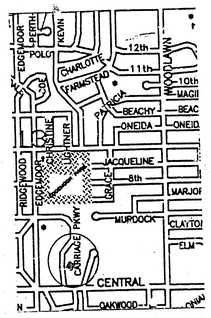

SITE LOCATION

APPROVED AS NOTED
BY CITY ENGINEER OF WICHITA

Sanitary Sewers _____

Storm Sewers VRH 1/27/94


Driveway Approaches _____

Water Mains _____

Paving _____

NOTE TO CONTRACTORS

Inspection and testing for this project is to be provided by a Licensed Consulting Engineering Firm under contract with the Owner/Developer. Said inspection to be in accordance with the City of Wichita standard construction engineering practices and certified by a Licensed Professional Engineer. No work shall be performed in dedicated easements or public right-of-way by the Contractor without such inspection nor shall any work be commenced without written authorization by the City Engineer.

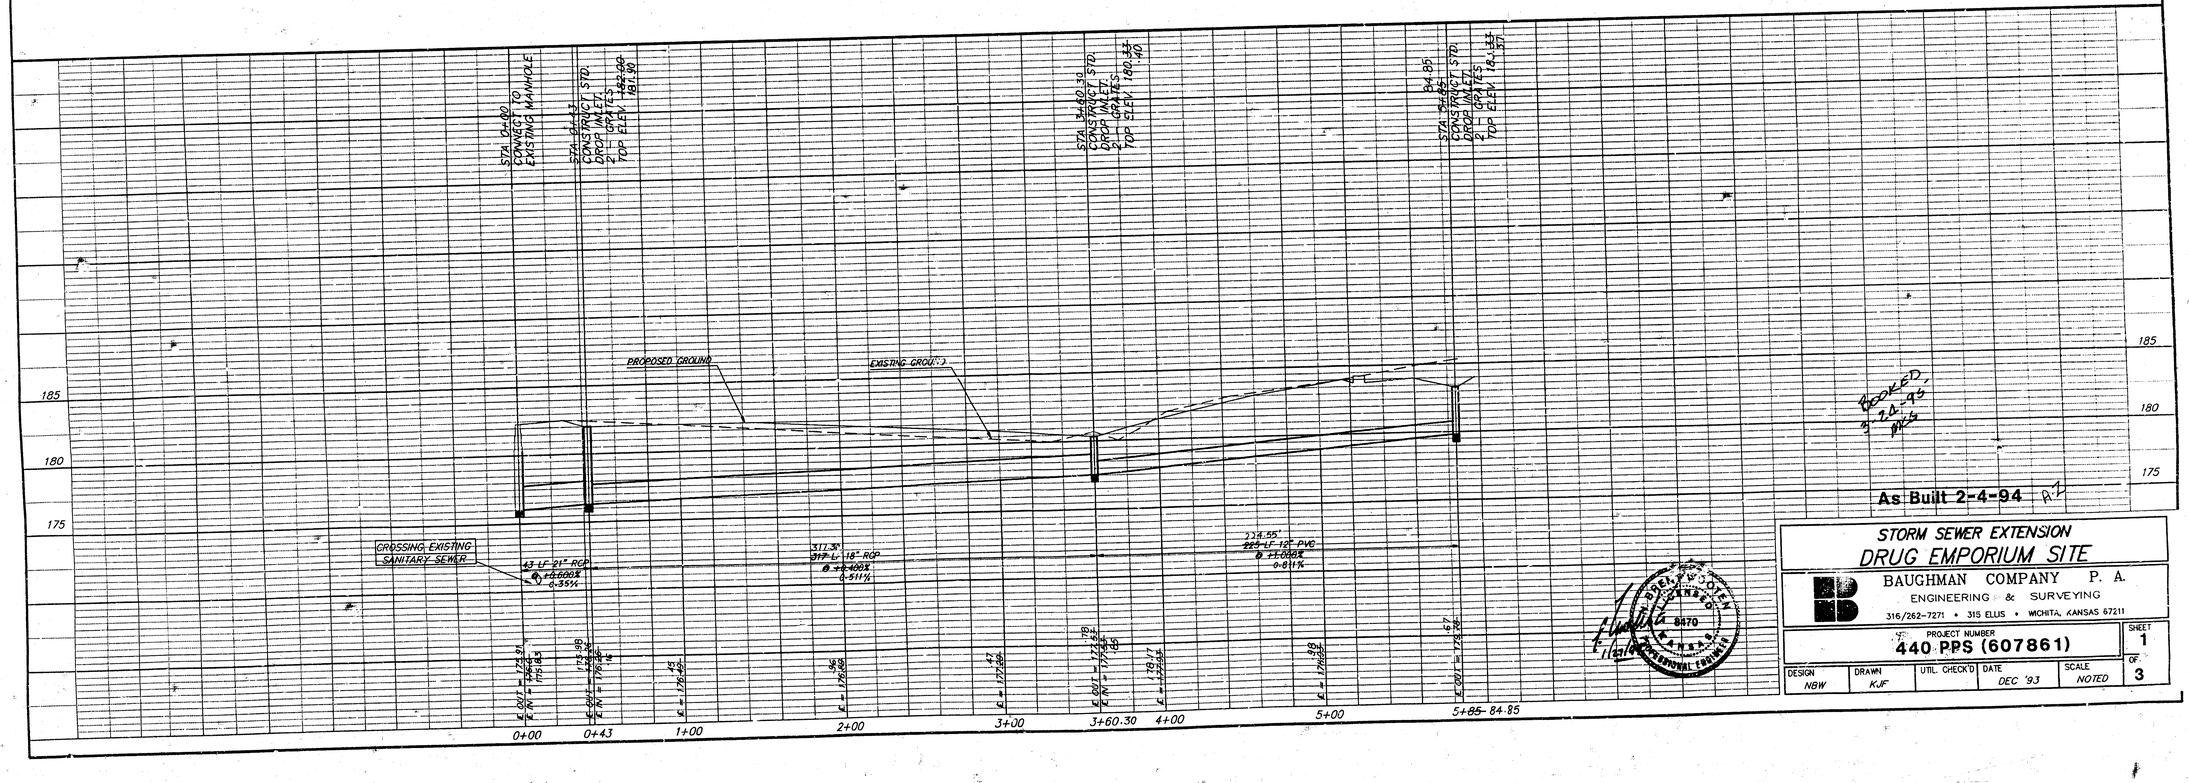

BOOKED,
2-24-95
PMS

As Built 2-4-94 AJ

STORM SEWER EXTENSION
DRUG EMPORIUM SITE

BAUGHMAN COMPANY P. A.
ENGINEERING & SURVEYING
316/262-7271 • 315 ELLIS • WICHITA, KANSAS 67211

PROJECT NUMBER
440 PPS (607861)

SHEET 1 OF 3

DESIGN	DRAWN	UTIL. CHECK'D	DATE	SCALE
NBW	KJF		DEC '93	NOTED

8470
KANSAS
1/27/94
PROFESSIONAL ENGINEER

ARCHITECTURE + INTERIOR DESIGN · PLANNING · SUITE 110 · 200 N. BROADWAY · WICHITA, KS 67202 · 316 267 0101 · FAX 316 267 0118

THE RESIDENTIAL PARTNERSHIP


DRUG EMPORIUM

WICHITA, KANSAS

CARRIAGE PARKWAY

A2


PROGRESS PRINT
ORIG. : 11-17-93
REVISED: 12-14-93
REVISED: 12-17-93

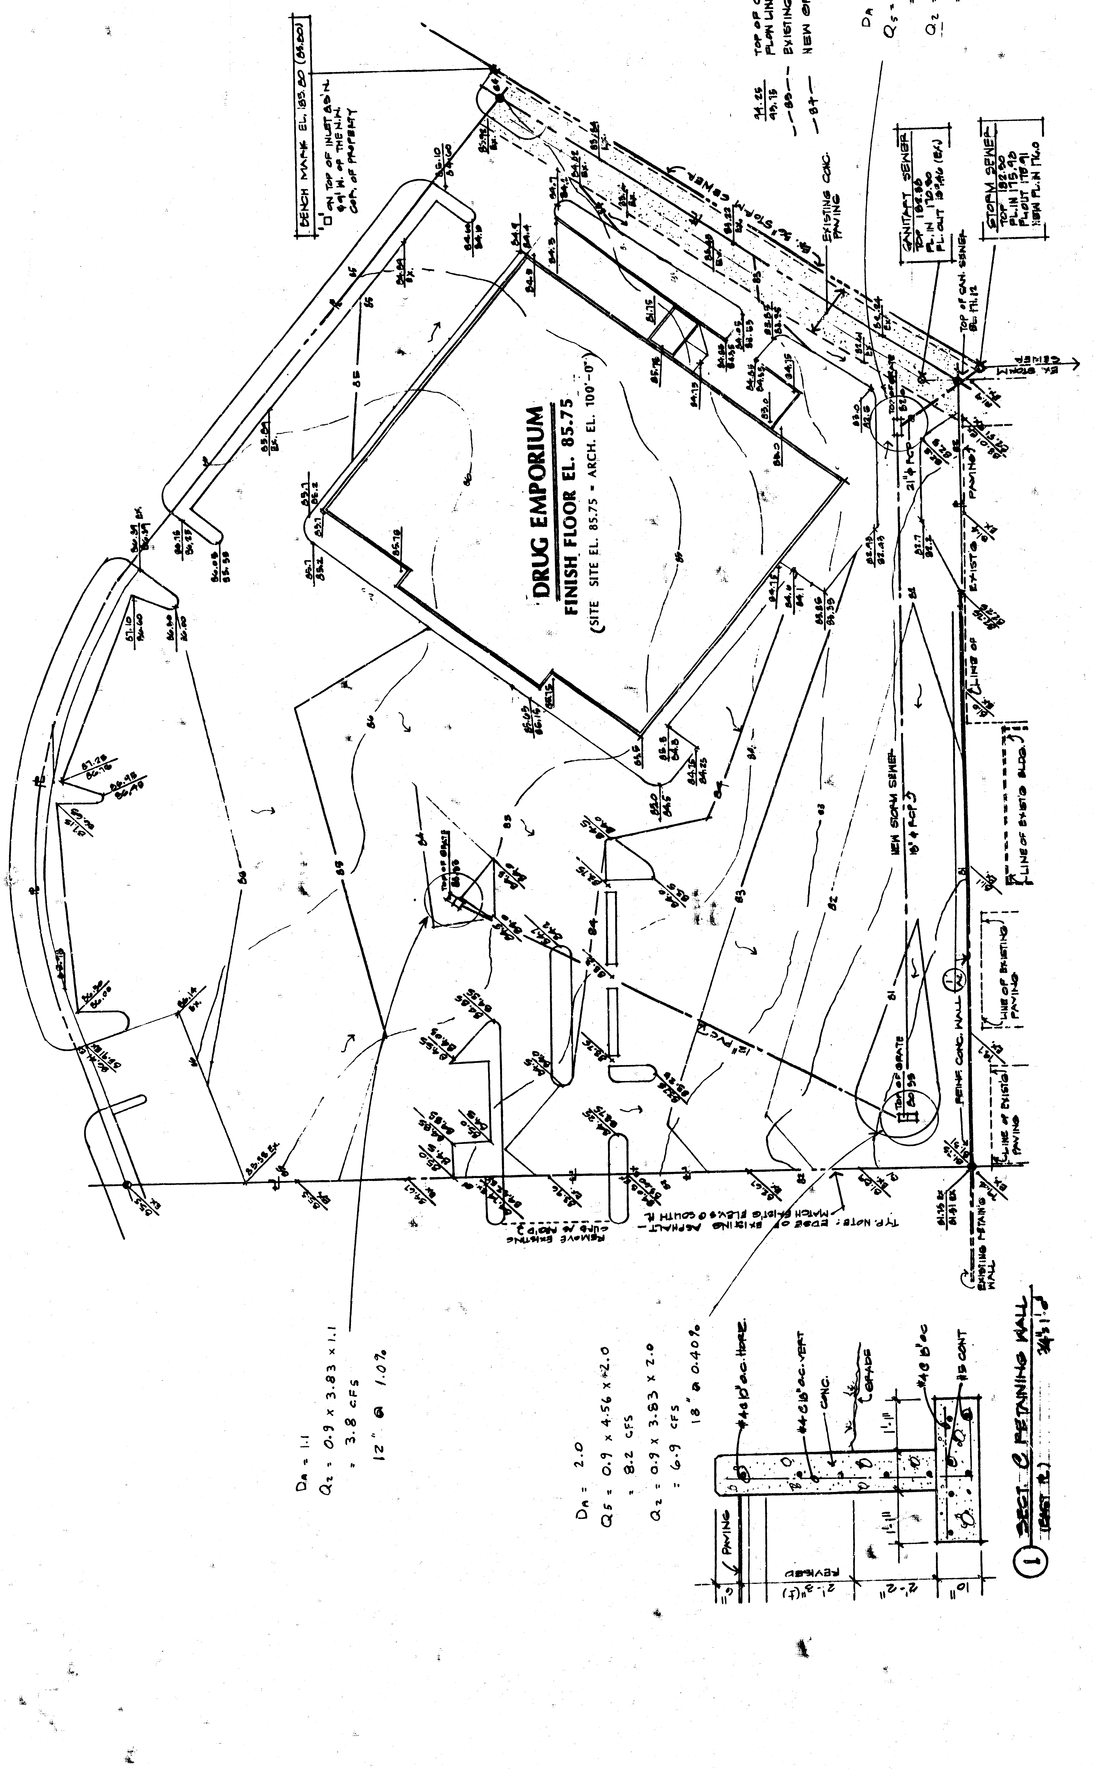


SITE GRADING PLAN


1" = 30'-0"

1 SECT. @ RETAINING WALL
SCALE: 1" = 1'-0"

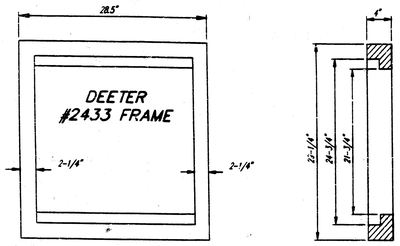

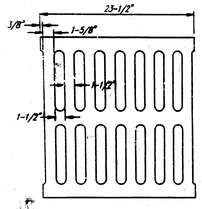



DEETER #2433 GRATE

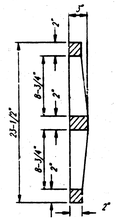


NOTE: Grates shall be imprinted on the top surface with "CITY OF WICHITA" using letters at least 1" in height. Other marking methods may be approved by the engineer.


24" x 24" Frame and Grate Detail

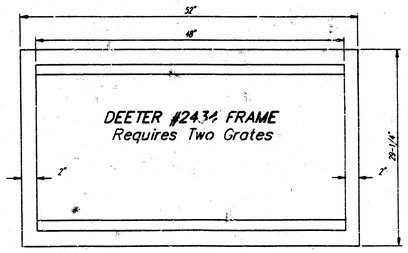


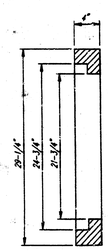

Double 24" x 24" Frame Detail

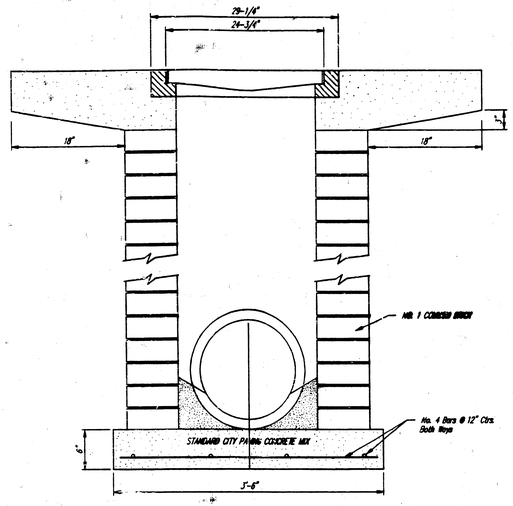

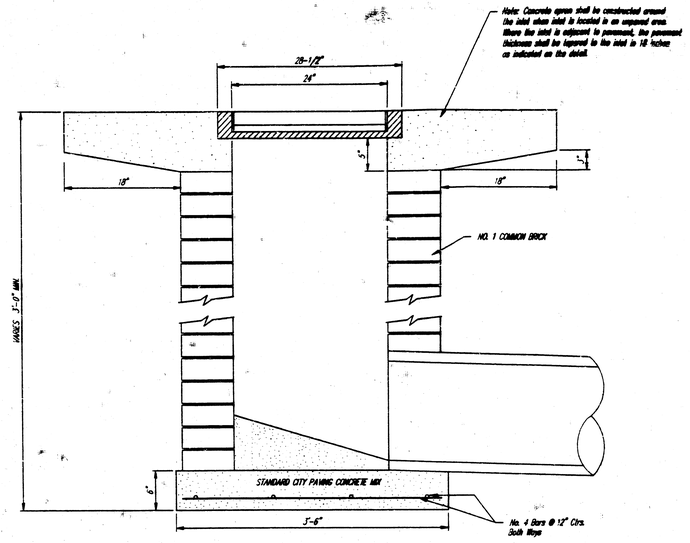

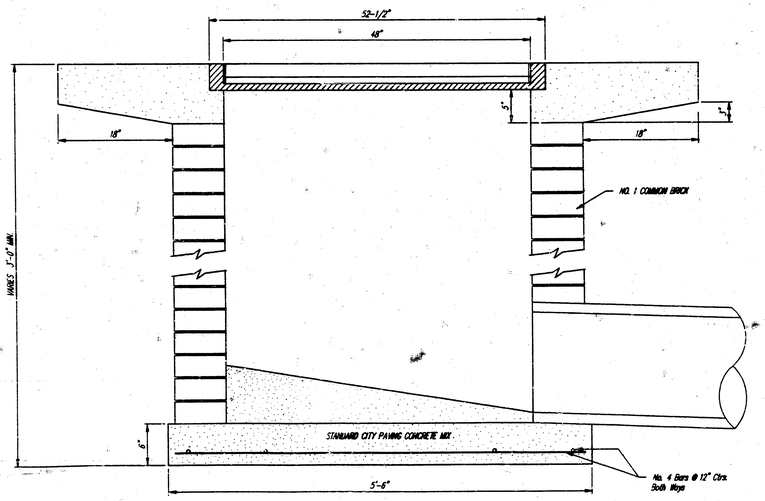

DROP INLET DETAILS

M.E. Lindebak, City Engineer
City of Wichita, Kansas

Project Number	
440 PPS (607861)	3

3

1e-1-3-6