


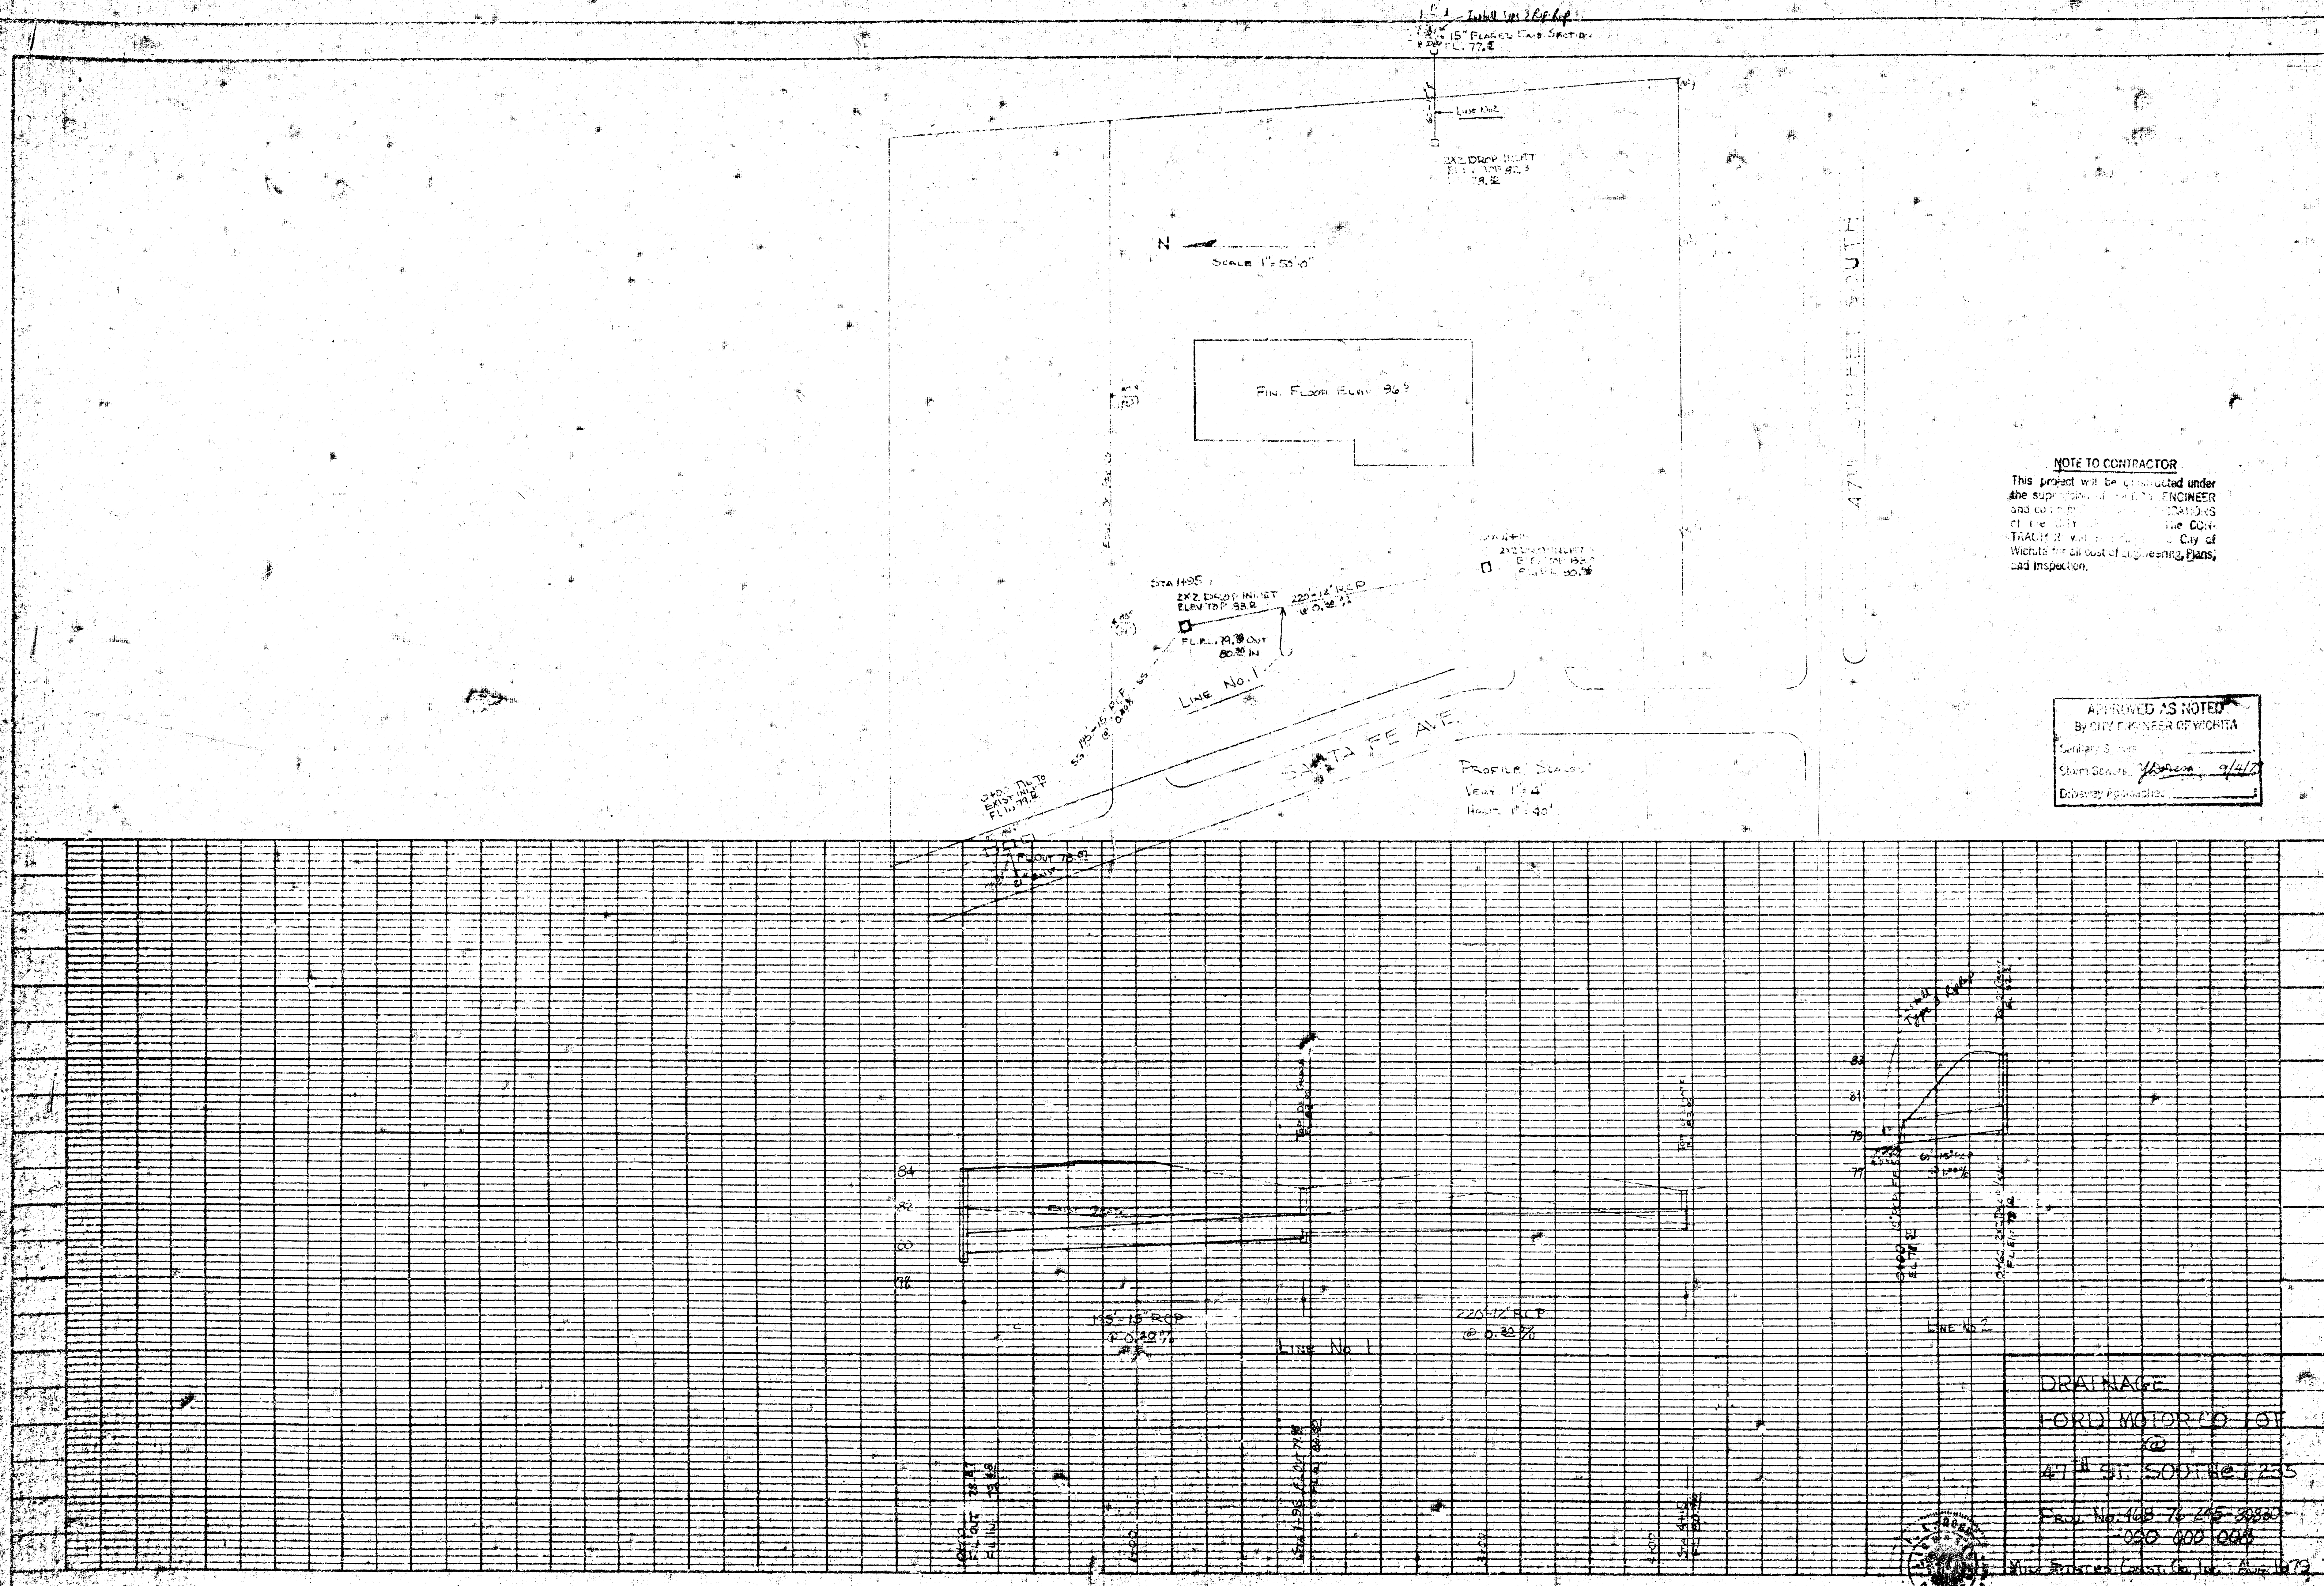

NOTE TO CONTRACTOR

This project will be constructed under the supervision of the CITY ENGINEER and the City Engineer shall be the CONTRACTOR'S representative. The CONTRACTOR shall be responsible for the City of Wichita for all cost of engineering, plans, and inspection.

APPROVED AS NOTED
By CITY ENGINEER OF WICHITA


DRAINAGE
FORD MOTOR CO LOT

