

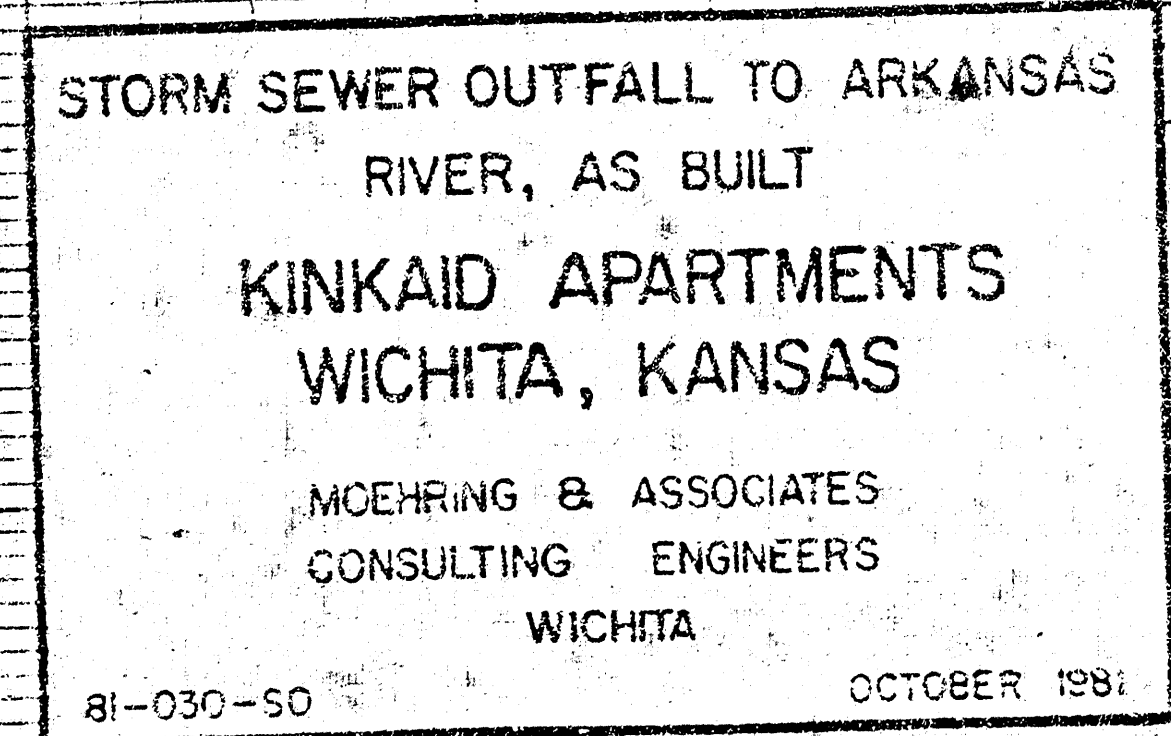


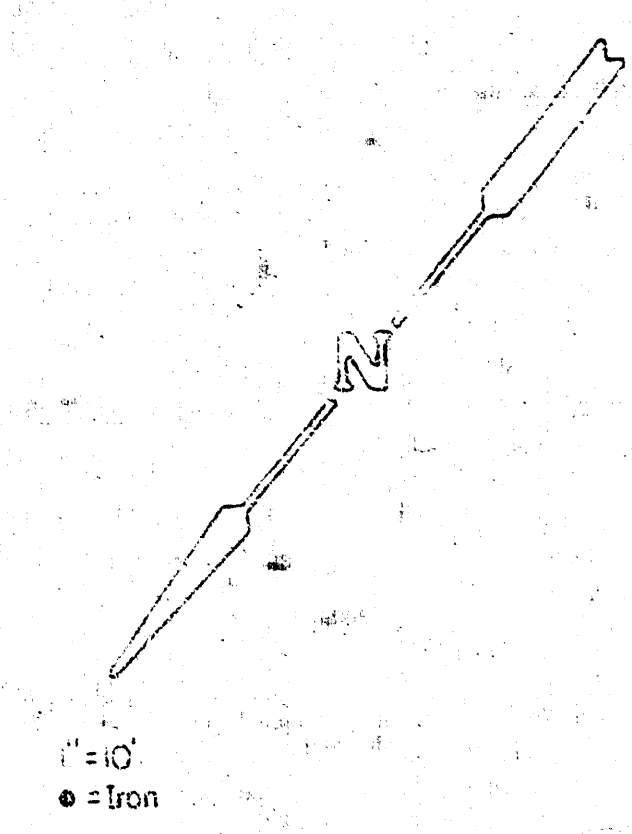

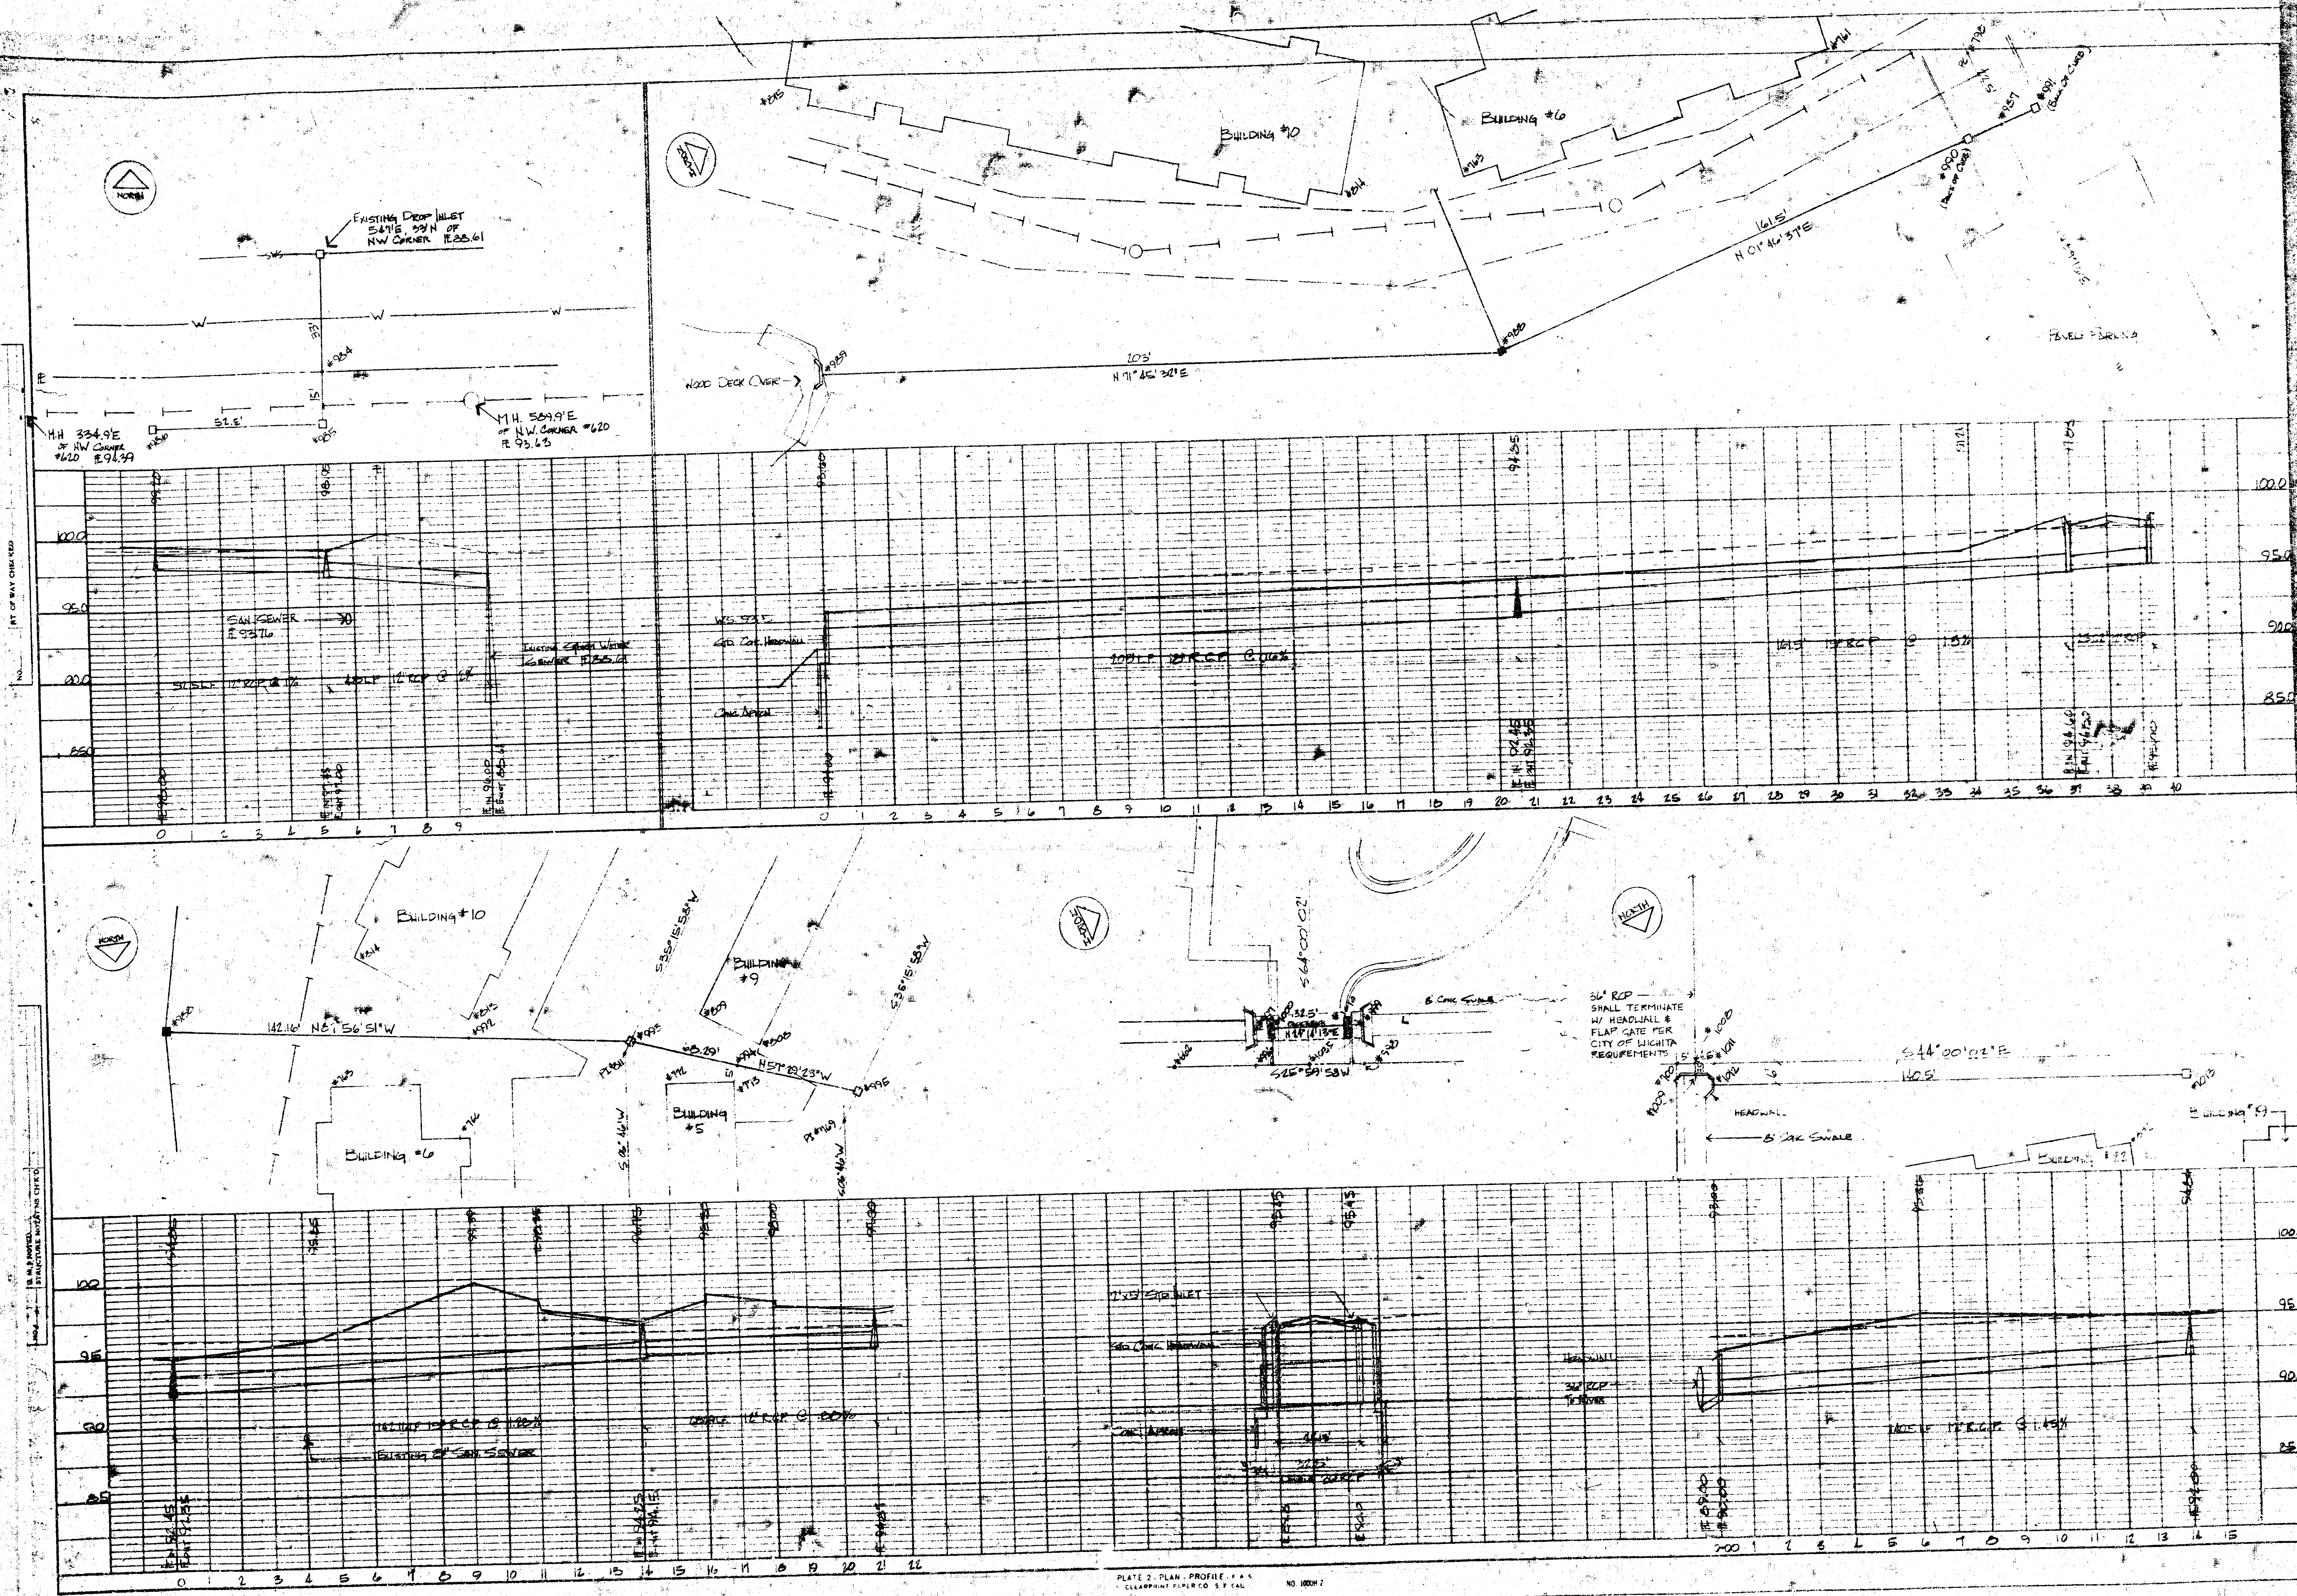

LAWRENCE E. WELLS

A R C H I T E C T

254 LAURA SUITE 205 WICHITA, KANSAS 67211

KINKAID PARK APTS.

FOR KINKAID, INC.

MARION and SOUTH TOPEKA WICHITA, KANSAS

PLAN NO. C-362 PROJECT 545

DATE 11-14-80

DRAWN [initials]

CHECKED [initials]

REVISED

SHEET 1 OF 2

2/3

