GENERAL NOTES

1. Contractor will be required to provide notice to utility companies a minimum of twenty-four (24) hours prior to any excavation, as follows:

   Kansas One-Call 687-2470

   The Contractor must notify the following in case of an emergency:

Cablevision	262-4270
or	263-2061
K.P.L. Gas Service Company	263-7511
Kansas Gas & Electric Company	264-1141
Arkla Gas Company	942-8350
Southwestern Bell Telephone Company	1-571-2611

2. Contractor shall not start work on the project until the project inspector is assigned to the project and is present on the site. Any work done without inspection will be required to be uncovered for inspection.
3. Exist. utilities and their locations, as shown on the plans, represent the best information obtainable for design. Location information has been obtained from the various utility companies and is either from company record drawings or company-provided field locations. The Contractor will be required to work around existing utilities which do not conflict with proposed construction.
4. Traffic affected by the construction on this project shall be handled in accordance with the latest edition of the Manual on Uniform Traffic Control Devices.
5. The Contractor to verify utility locations prior to construction of this project.
6. All disturbed areas shall be seeded with Rebel II fescue at the rate of 340 lbs. per acre. Fertilizer (13-13-13) shall be applied at the rate of 100 lbs. per acre.
7. Storm sewer shown herein is to be privately maintained. The contractor shall obtain approval for Line 2 and Line 1 Sta. 0+43.8 to 2+35.2 from the Office of Central Inspection.
8. Storm sewer may be constructed with either RCP, CMP, or PVC pipe at the election of the Contractor.

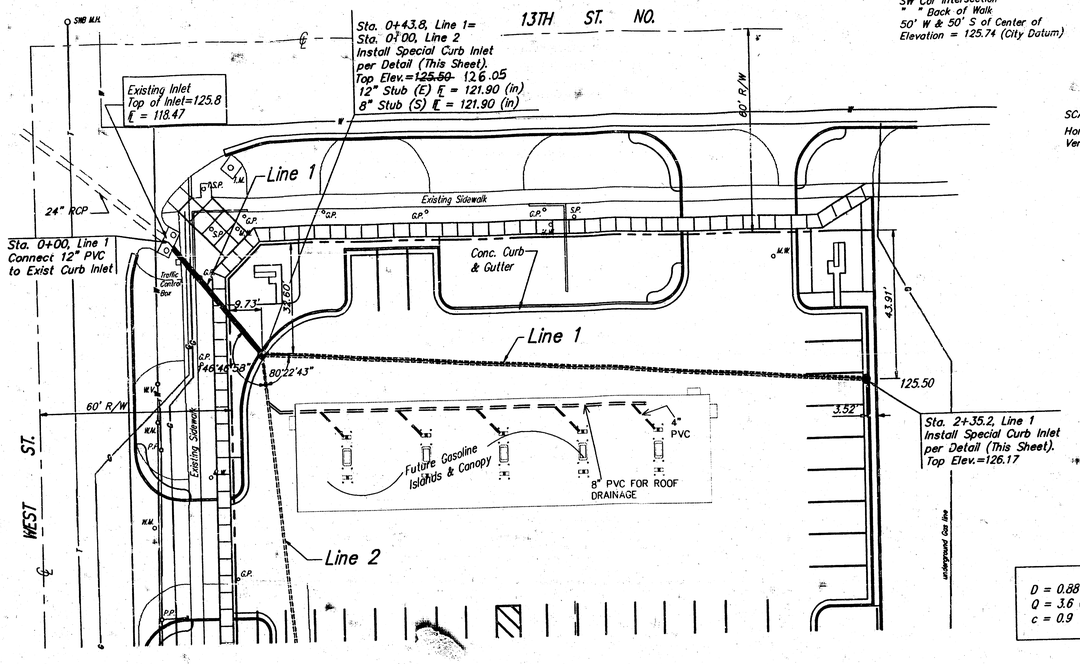

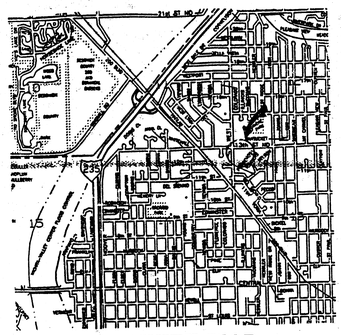

VICINITY MAP

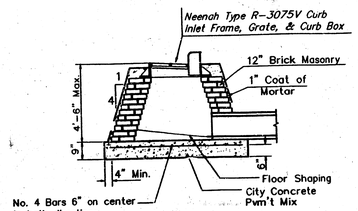

MODIFIED SPECIAL SHALLOW TYPE "B" MANHOLE

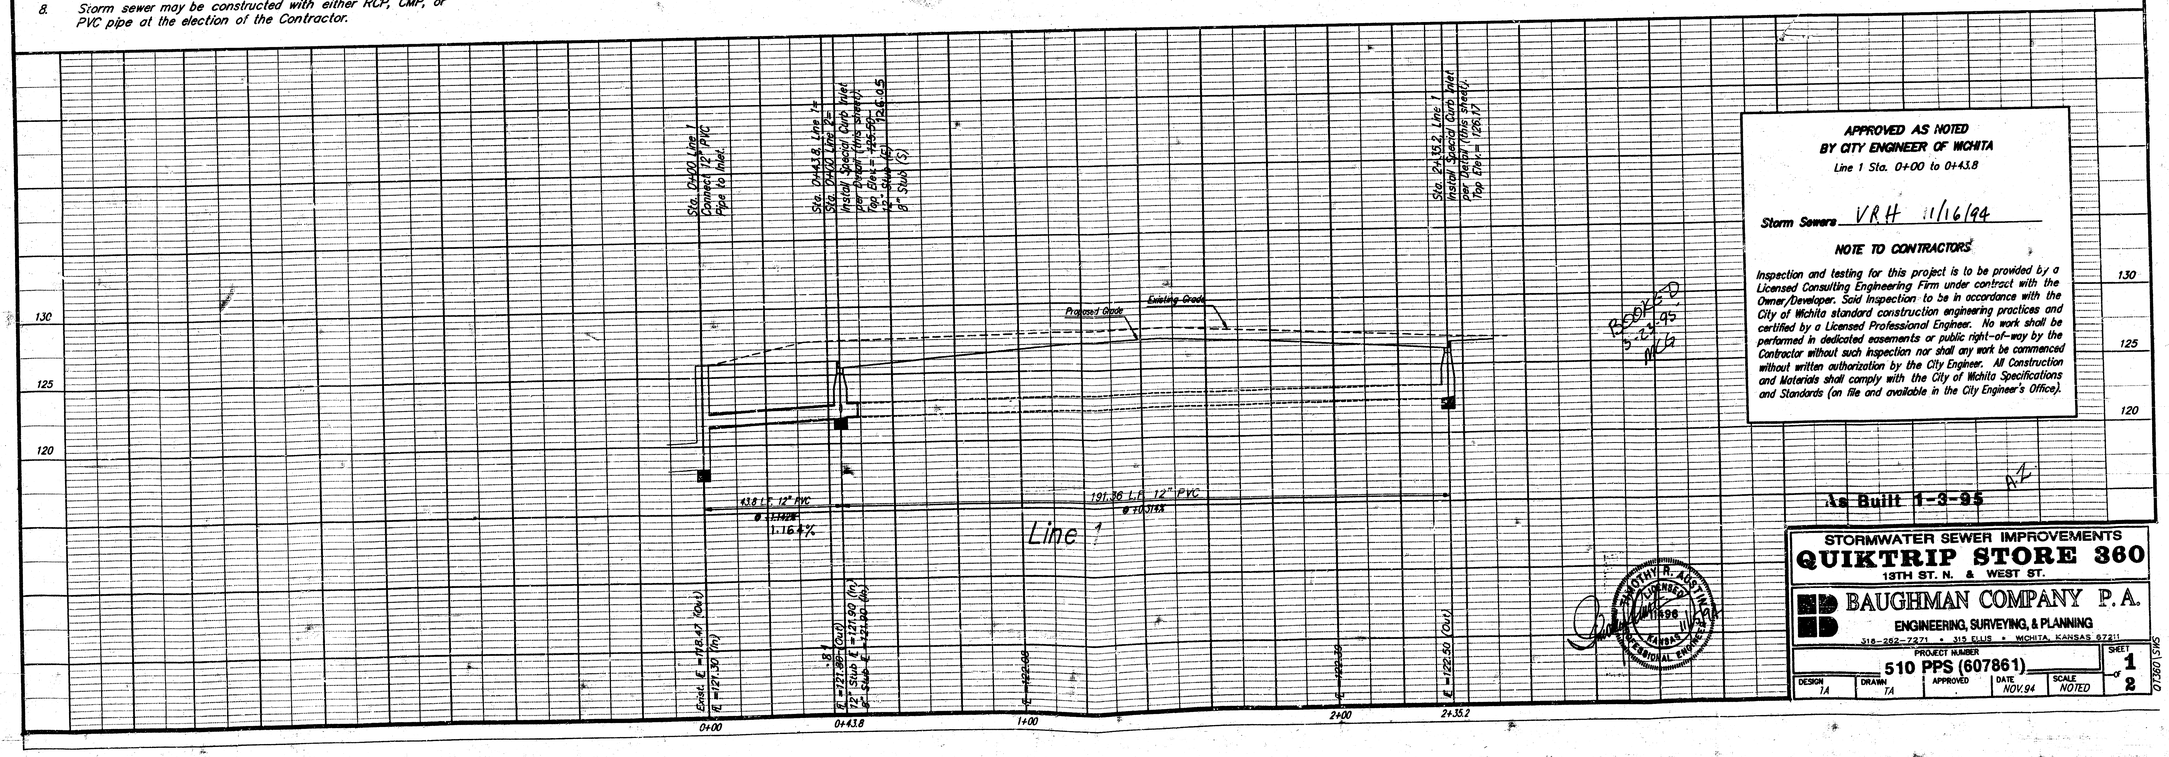

APPROVED AS NOTED
BY CITY ENGINEER OF WICHITA
Line 1 Sta. 0+00 to 0+43.8

Storm Sewers VRH 11/16/94

NOTE TO CONTRACTORS

Inspection and testing for this project is to be provided by a Licensed Consulting Engineering Firm under contract with the Owner/Developer. Said inspection to be in accordance with the City of Wichita standard construction engineering practices and certified by a Licensed Professional Engineer. No work shall be performed in dedicated easements or public right-of-way by the Contractor without such inspection nor shall any work be commenced without written authorization by the City Engineer. All Construction and Materials shall comply with the City of Wichita Specifications and Standards (on file and available in the City Engineer's Office).

BOOKED 5-23-95 MH

As Built 1-3-95 MH

TIMOTHY R. AUSTIN LICENSED 1998 KANSAS PROFESSIONAL ENGINEER

STORMWATER SEWER IMPROVEMENTS
QUIKTRIP STORE 360
13TH ST. N. & WEST ST.

BAUGHMAN COMPANY P.A.
ENGINEERING, SURVEYING, & PLANNING
316-262-2771 • 313 ELLIS • WICHITA, KANSAS 67211

PROJECT NUMBER 510 PPS (607861)

DESIGN	DRAWN	APPROVED	DATE	SCALE	SHEET
TA	TA		NOV.94	NOTED	1 of 2

D7861SW1

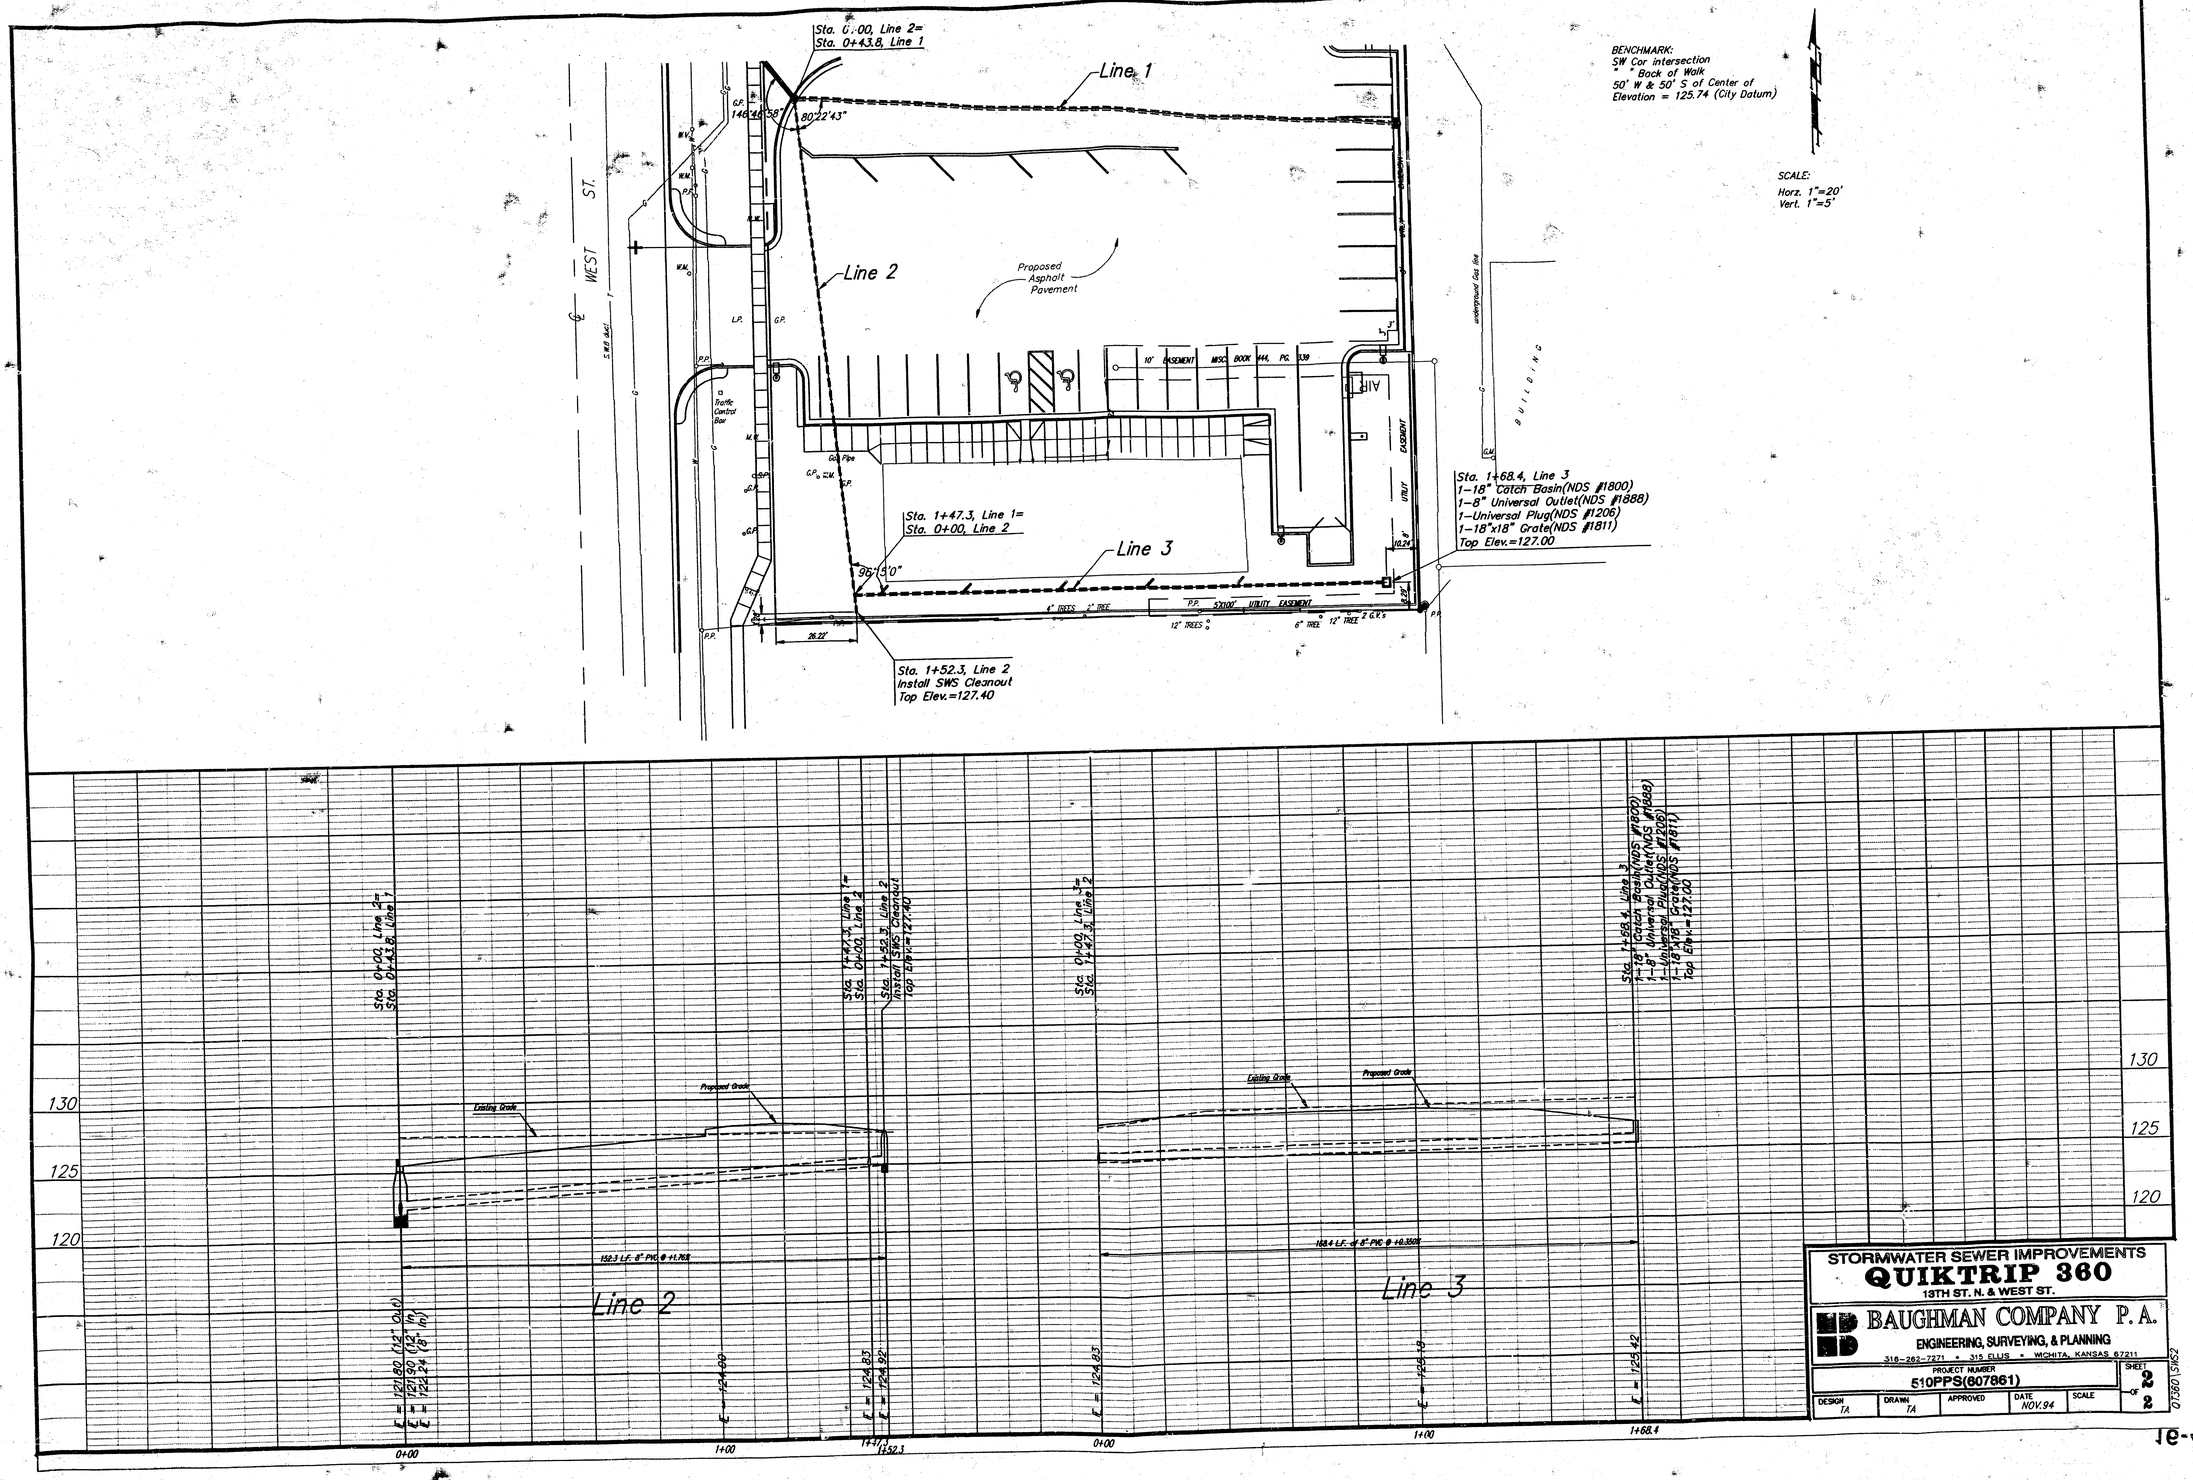

STORMWATER SEWER IMPROVEMENTS
QUIKTRIP 360
13TH ST. N. & WEST ST.

BAUGHMAN COMPANY P.A.
ENGINEERING, SURVEYING, & PLANNING
316-262-7271 • 315 ELLIS • WICHITA, KANSAS 67211

PROJECT NUMBER					SHEET
510PPS(607861)					2 OF 2
DESIGN TA	DRAWN TA	APPROVED	DATE NOV.94	SCALE	

OT360\SWS2