2-6-76

APPROVED AS NOTED
By CITY ENGINEER OF WICHITA
Sanitary Sewers _____
Storm Sewers O.E.S.
Driveway Approaches _____

Note: Approval of this plan does not indicate that construction of a building over an existing 30"X18" storm sewer has been approved.

NOTE TO CONTRACTOR

This project will be constructed under the supervision of the CITY ENGINEER and conforming to the SPECIFICATIONS of the CITY OF WICHITA. The CONTRACTOR will reimburse the City of Wichita for all cost of Engineering, Plans, and Inspection.

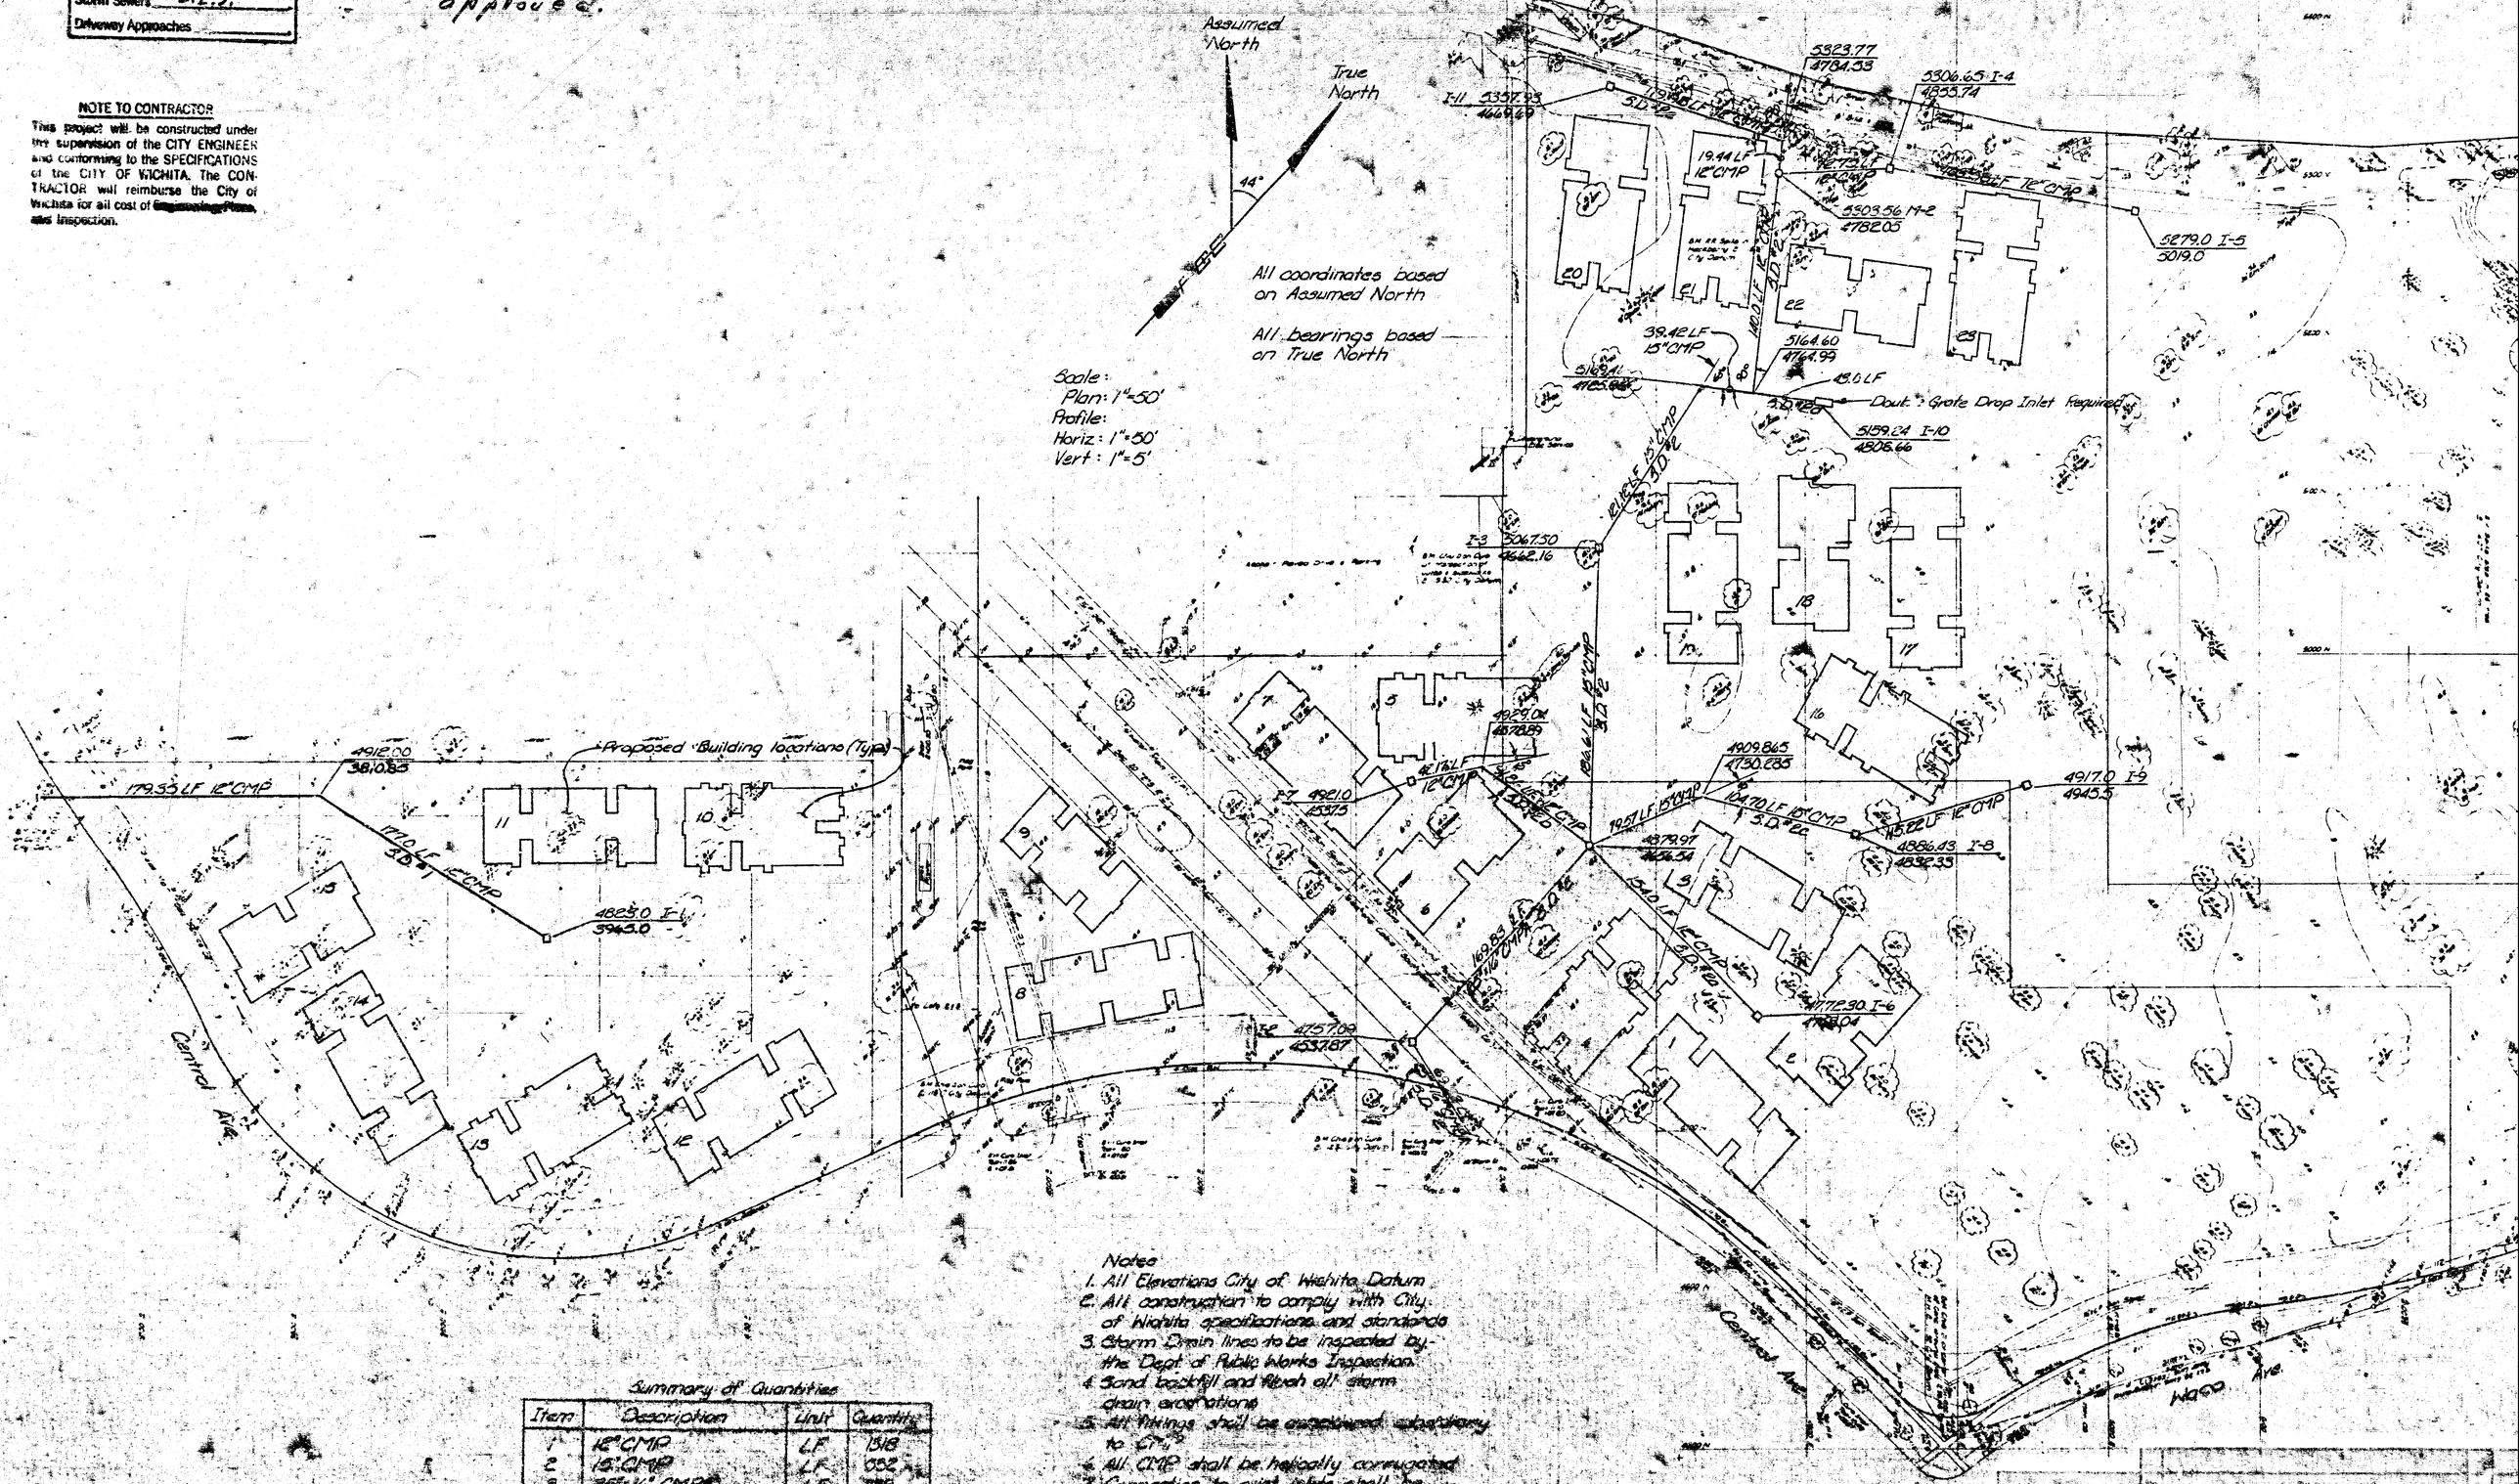

Summary of Quantities

Item	Description	Unit	Quantity
1	12" CMP	LF	1518
2	15" CMP	LF	882
3	25"x16" CMPA	LF	799
4	Manhole, Std	Ea	2
5	Inlet (Single Grate)	Ea	11
6	Inlet (Double Grate)	Ea	1
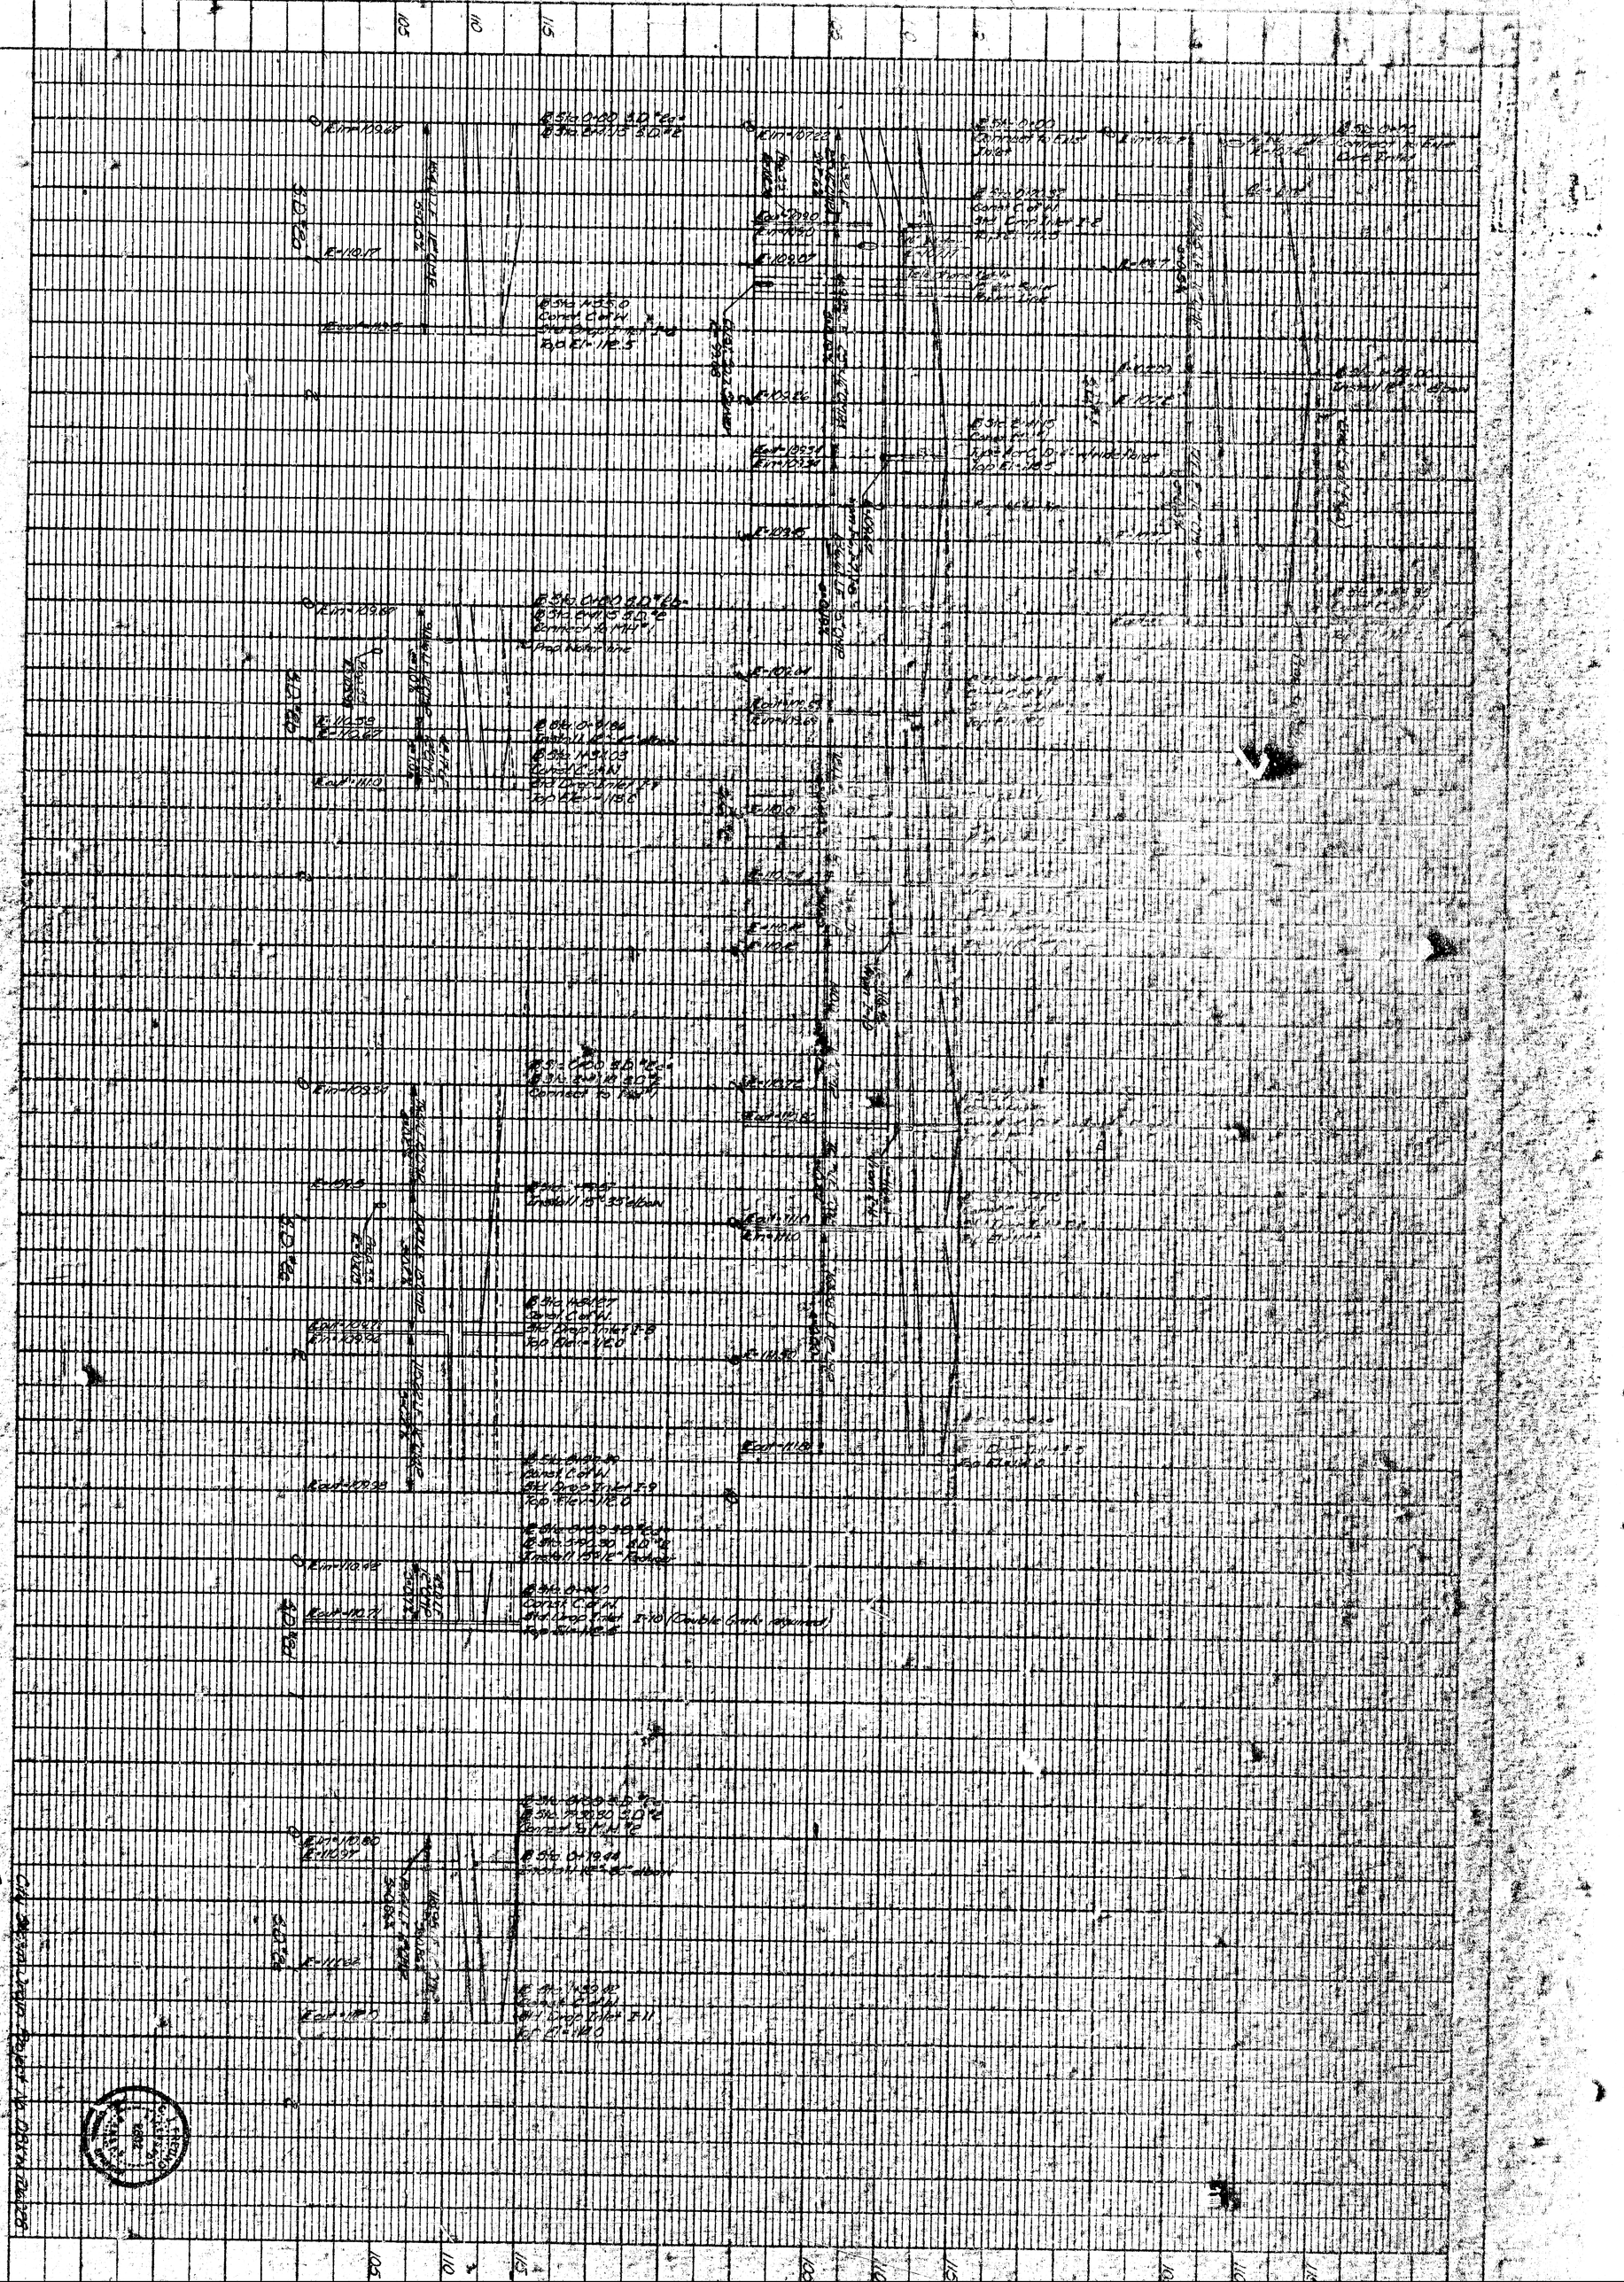
RIVERPARK APARTMENTS