


FOR CONSTRUCTION

REVISIONS











SEARS ROEBUCK WAREHOUSE REMODEL WICHITA, KANSAS

PROJECT NUMBER 74

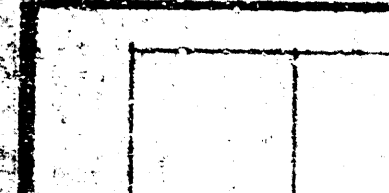

KEY

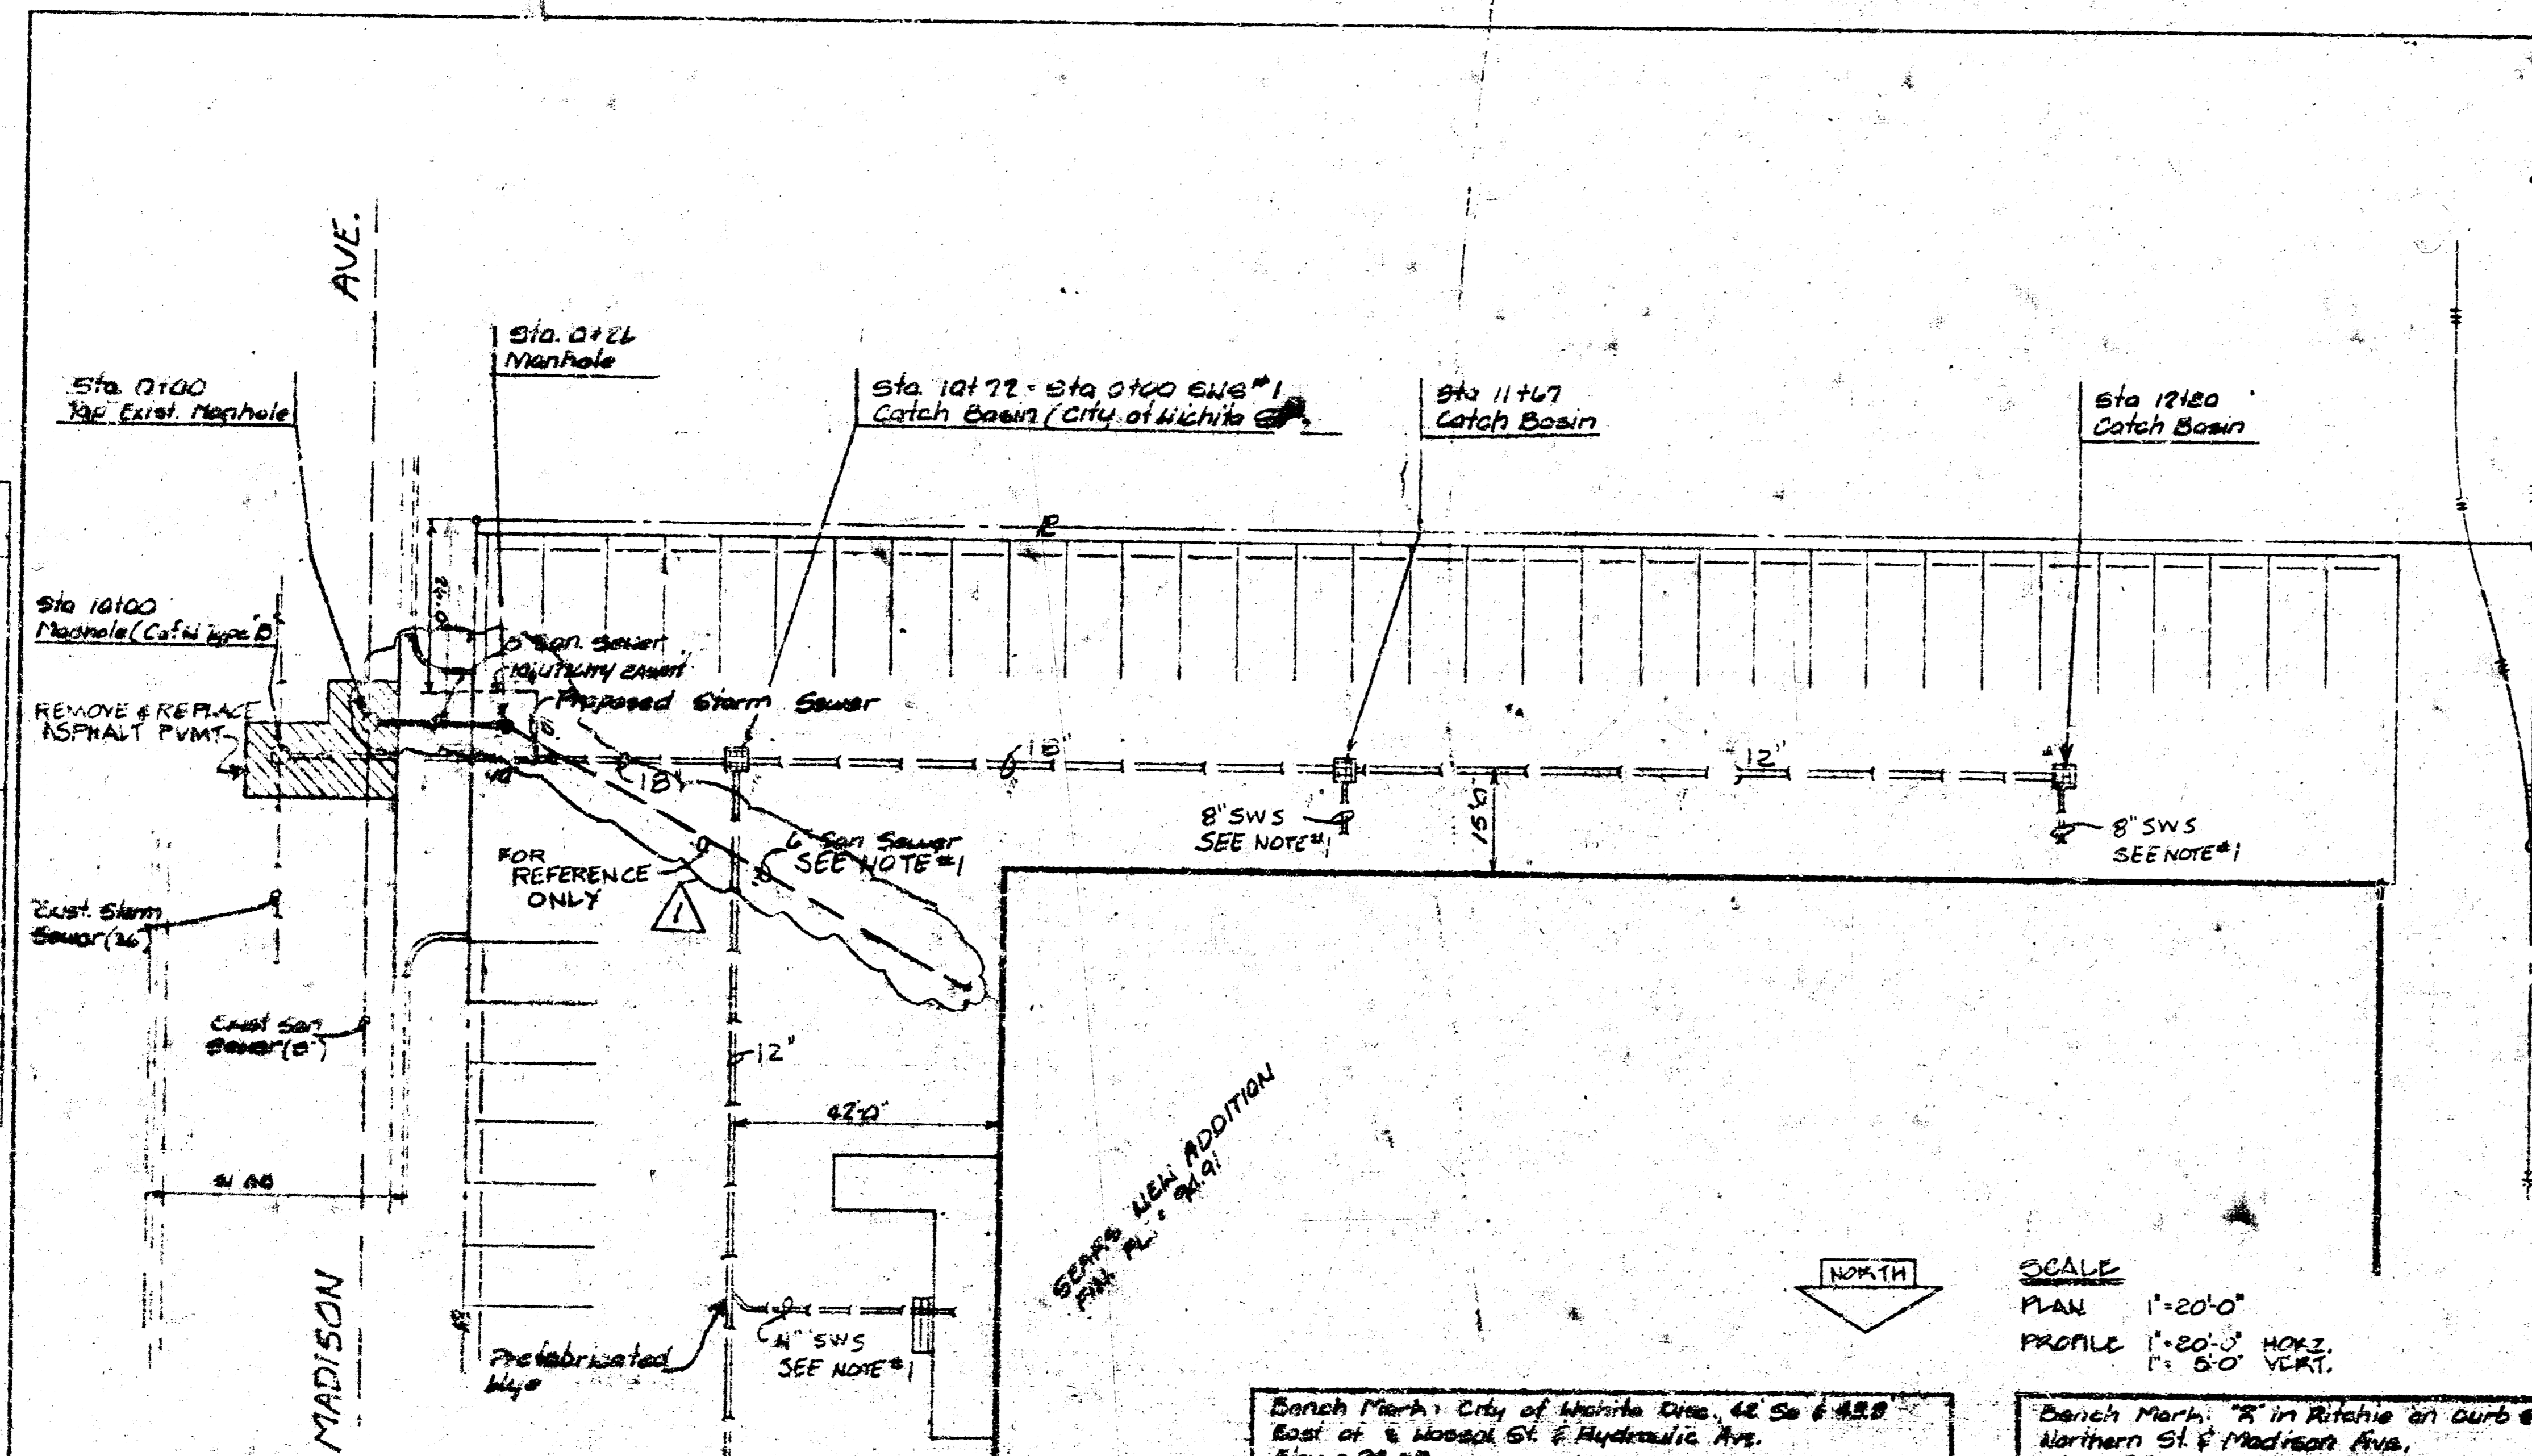


NOT TO SCALE


10-7-74
APPROVED AS NOTED
By CITY ENGINEER

NOTED:
1. REFER TO SHEET SG-1 FOR
SANITARY SEWER AND
STORM WATER SEWERS.

Proj. No. DBKW 704059

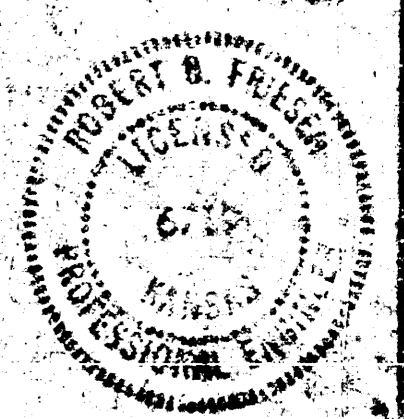


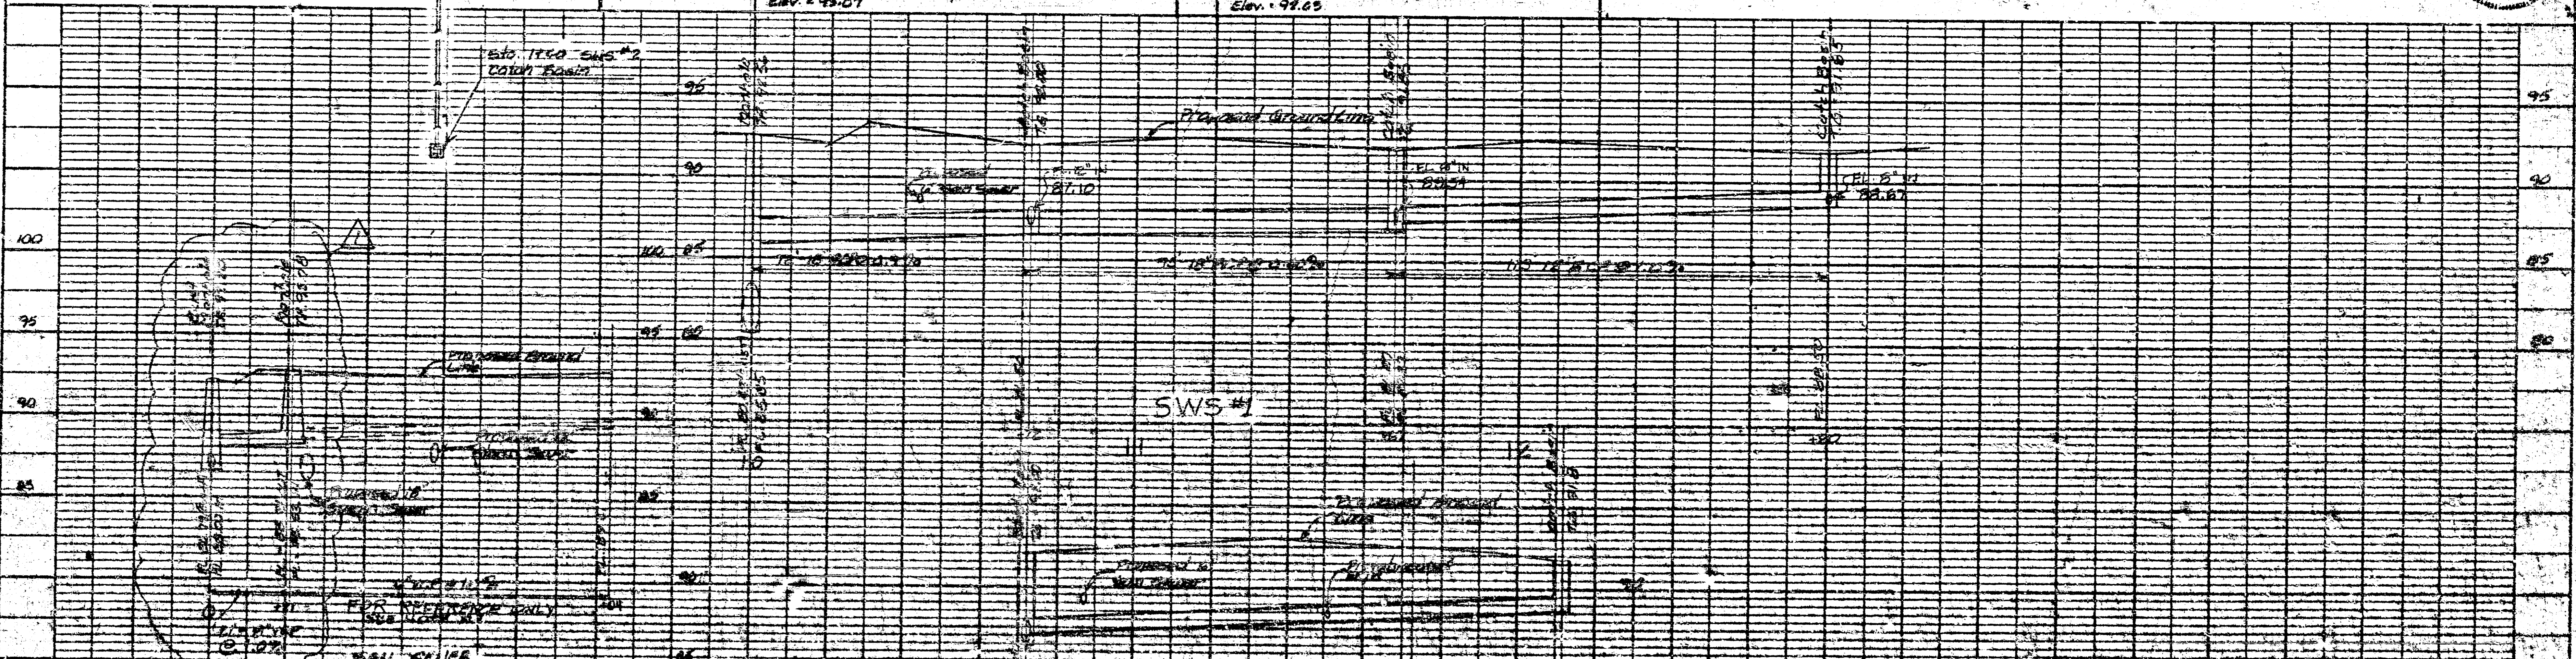


Benchmark, City of Wichita Div. 42 So 6-43.8
East of & North of E. Hydraulic Ave.
Elev. = 98.07

Benchmark, "R" in Ritchie on curb @ SW Cor.
Northern St. & Madison Ave.
Elev. = 98.05



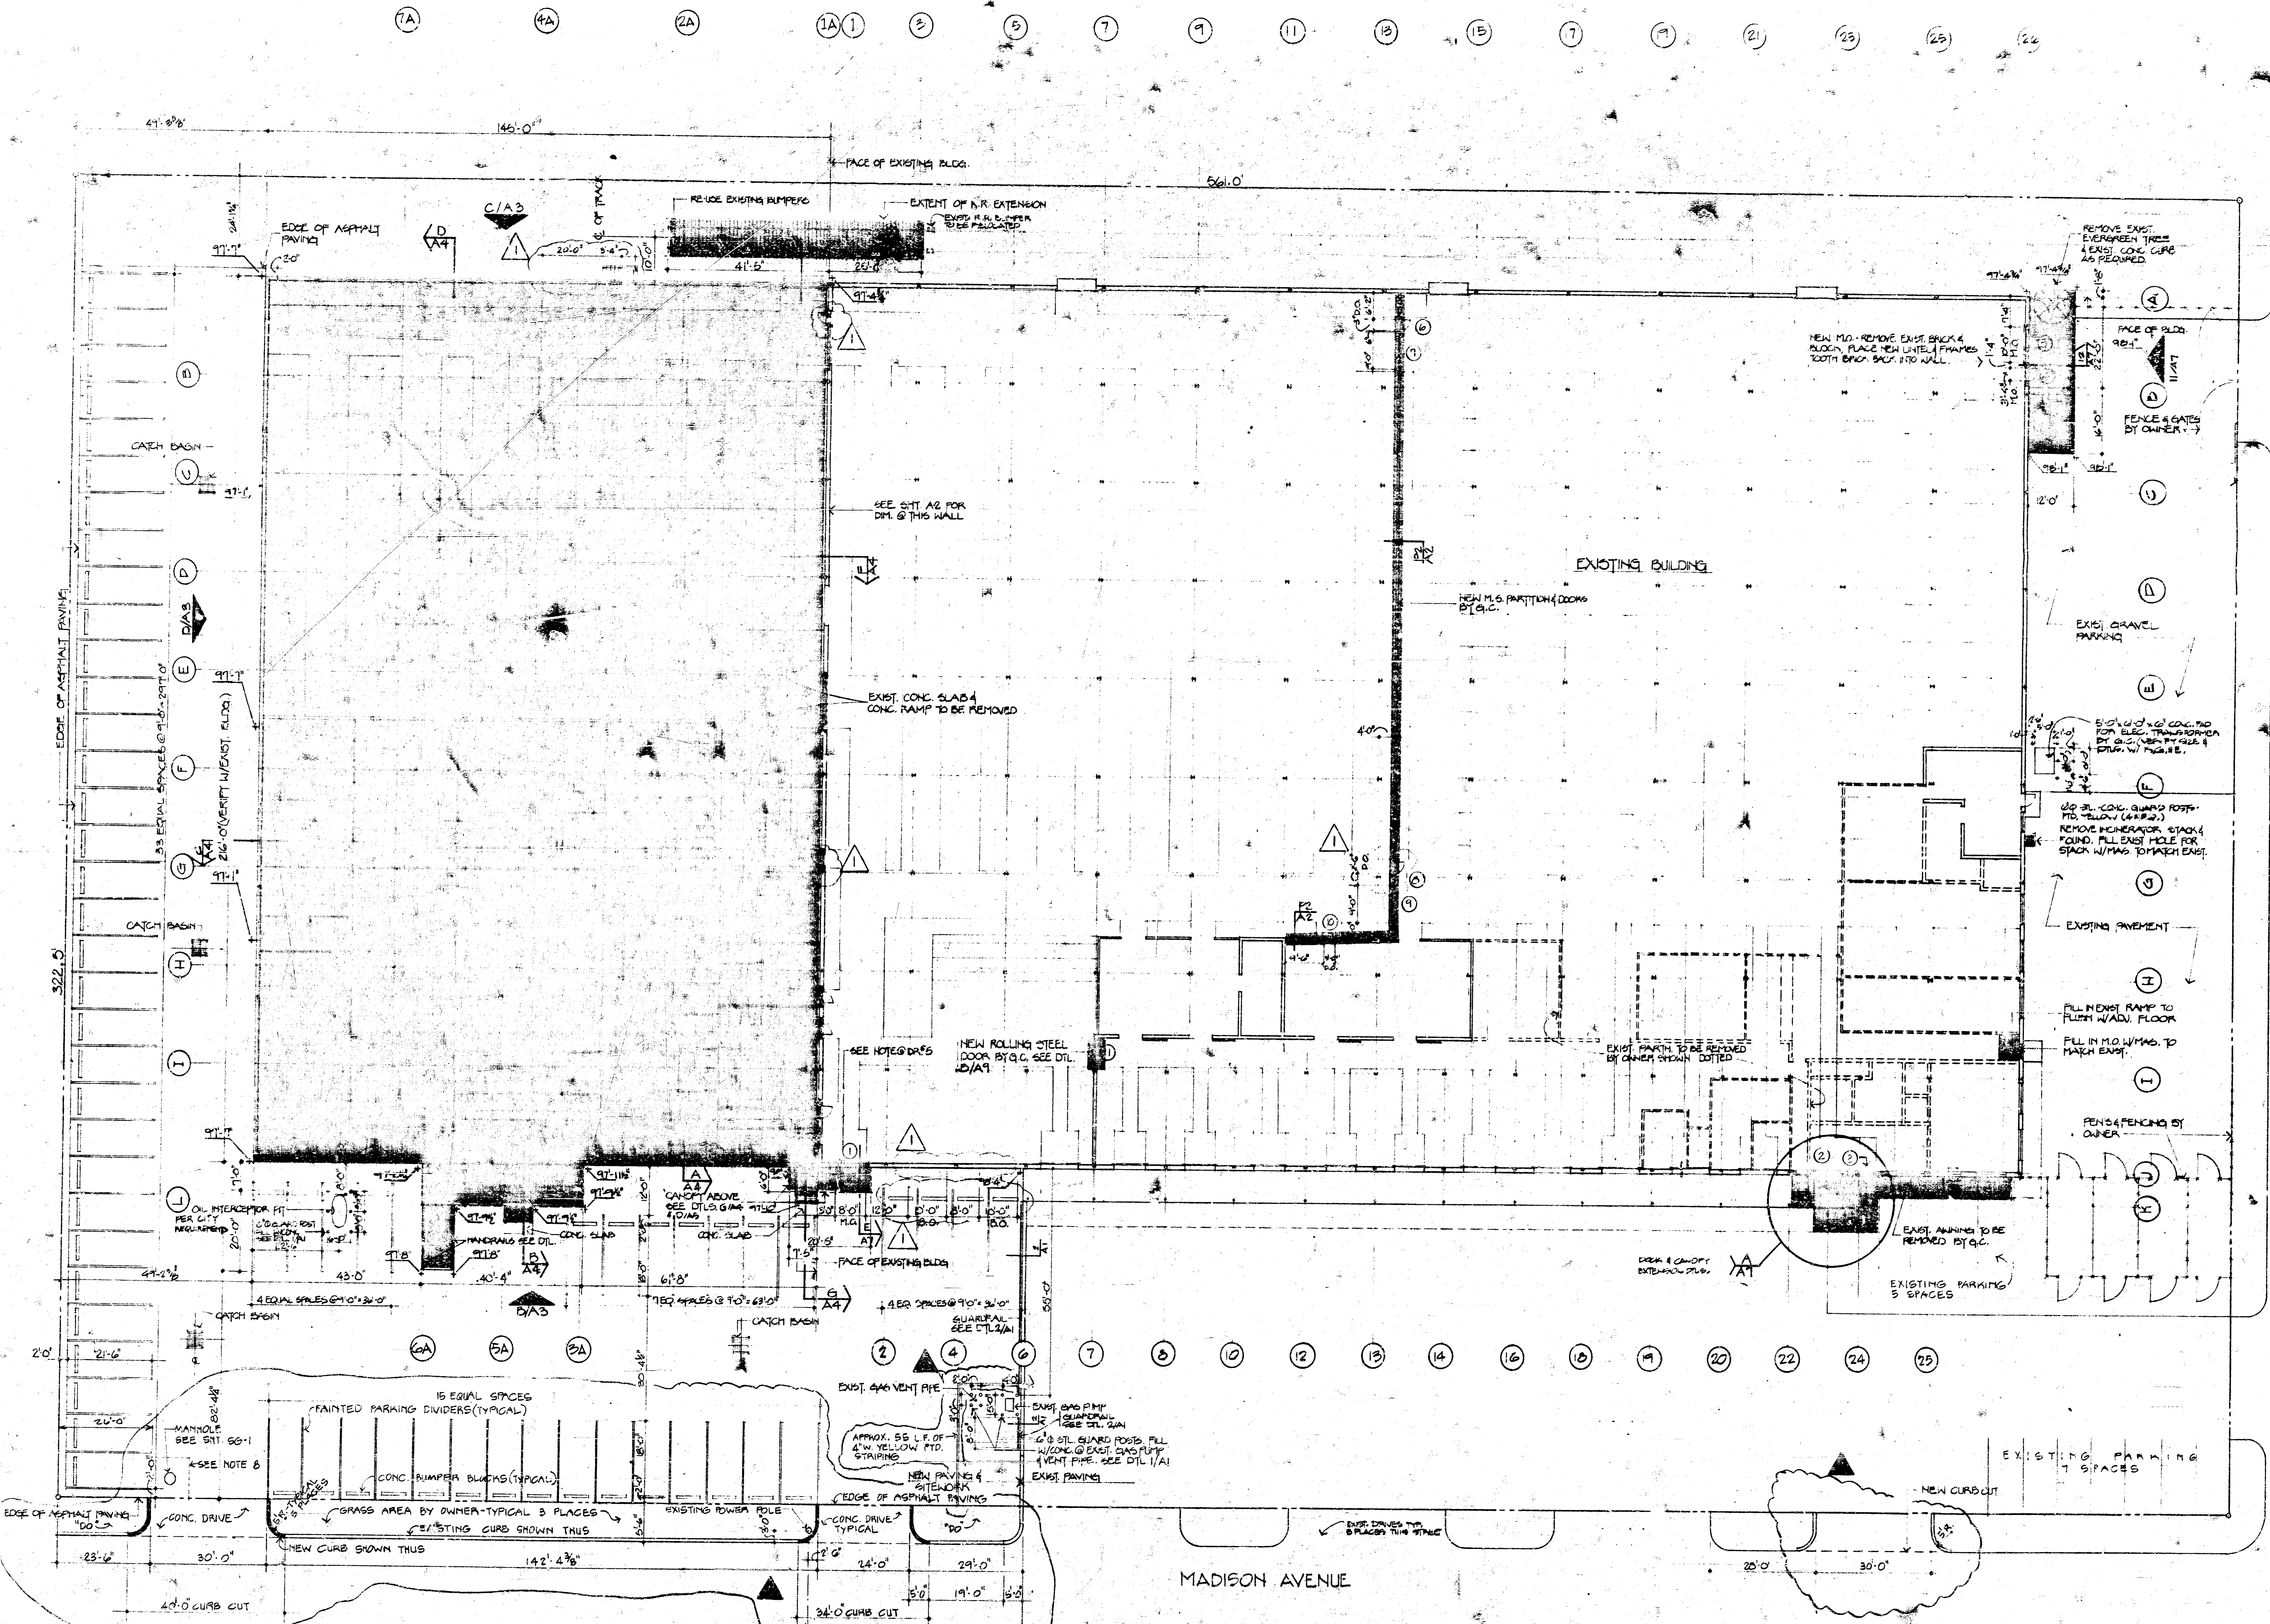


GENERAL NOTES


1. SHADED AREA INDICATES EXTENT OF NEW BLDG. CONST. & REMOVAL OF EXIST. BLDG. BY O.C.
2. EXIST. FENCE TO BE REMOVED & RELOCATED BY OWNER.

FOR CONSTRUCTION:

REVISIONS	
DATE	ITEM
7-10-74	PER O.C. & ARCH. REVISED DRAWING
10-1-74	PER O.C. & ARCH. REVISED DRAWING

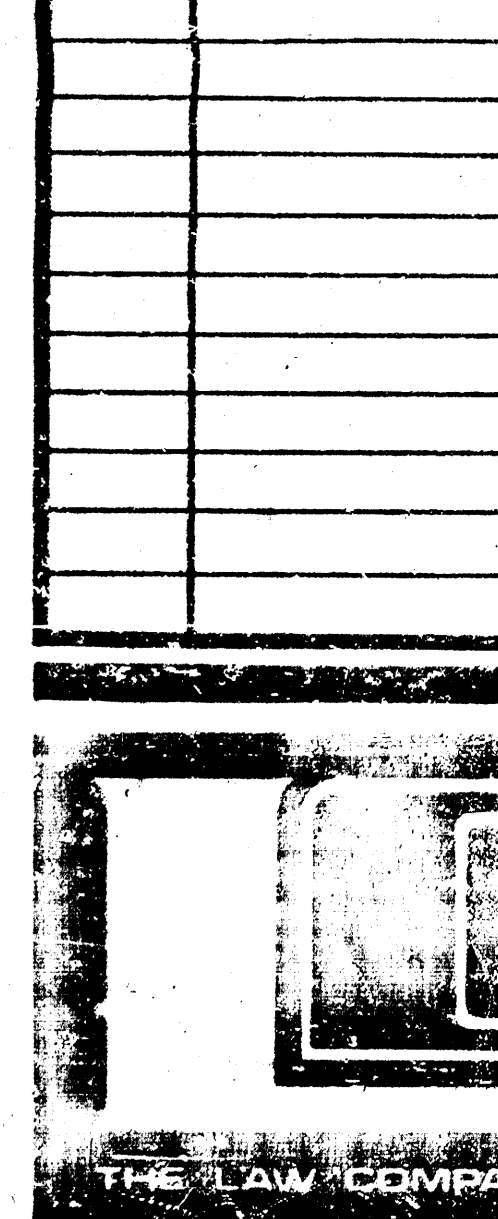

B. J. KINGDON
Architect
312 S. MARKS ST.
WICHITA, KANSAS
352-2222

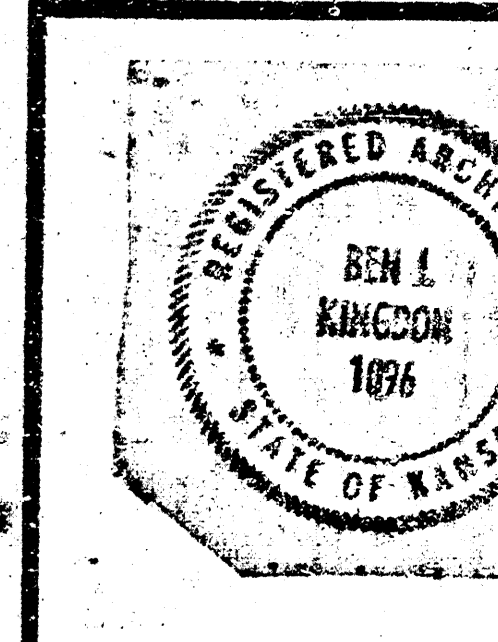

DRAWN	CHKD
AW	REB

RELATED DRAWING

SHELL	DETAILS	STRUCTURE	MCHANICAL	ELECTRICAL	OTHER

SEQUENCE NUMBER

OF

SEARS ROEBUCK WAREHOUSE ADD. REMODEL WICHITA, KANSAS

PROJECT NUMBER 74-2

KEY PLAN

TITLE

