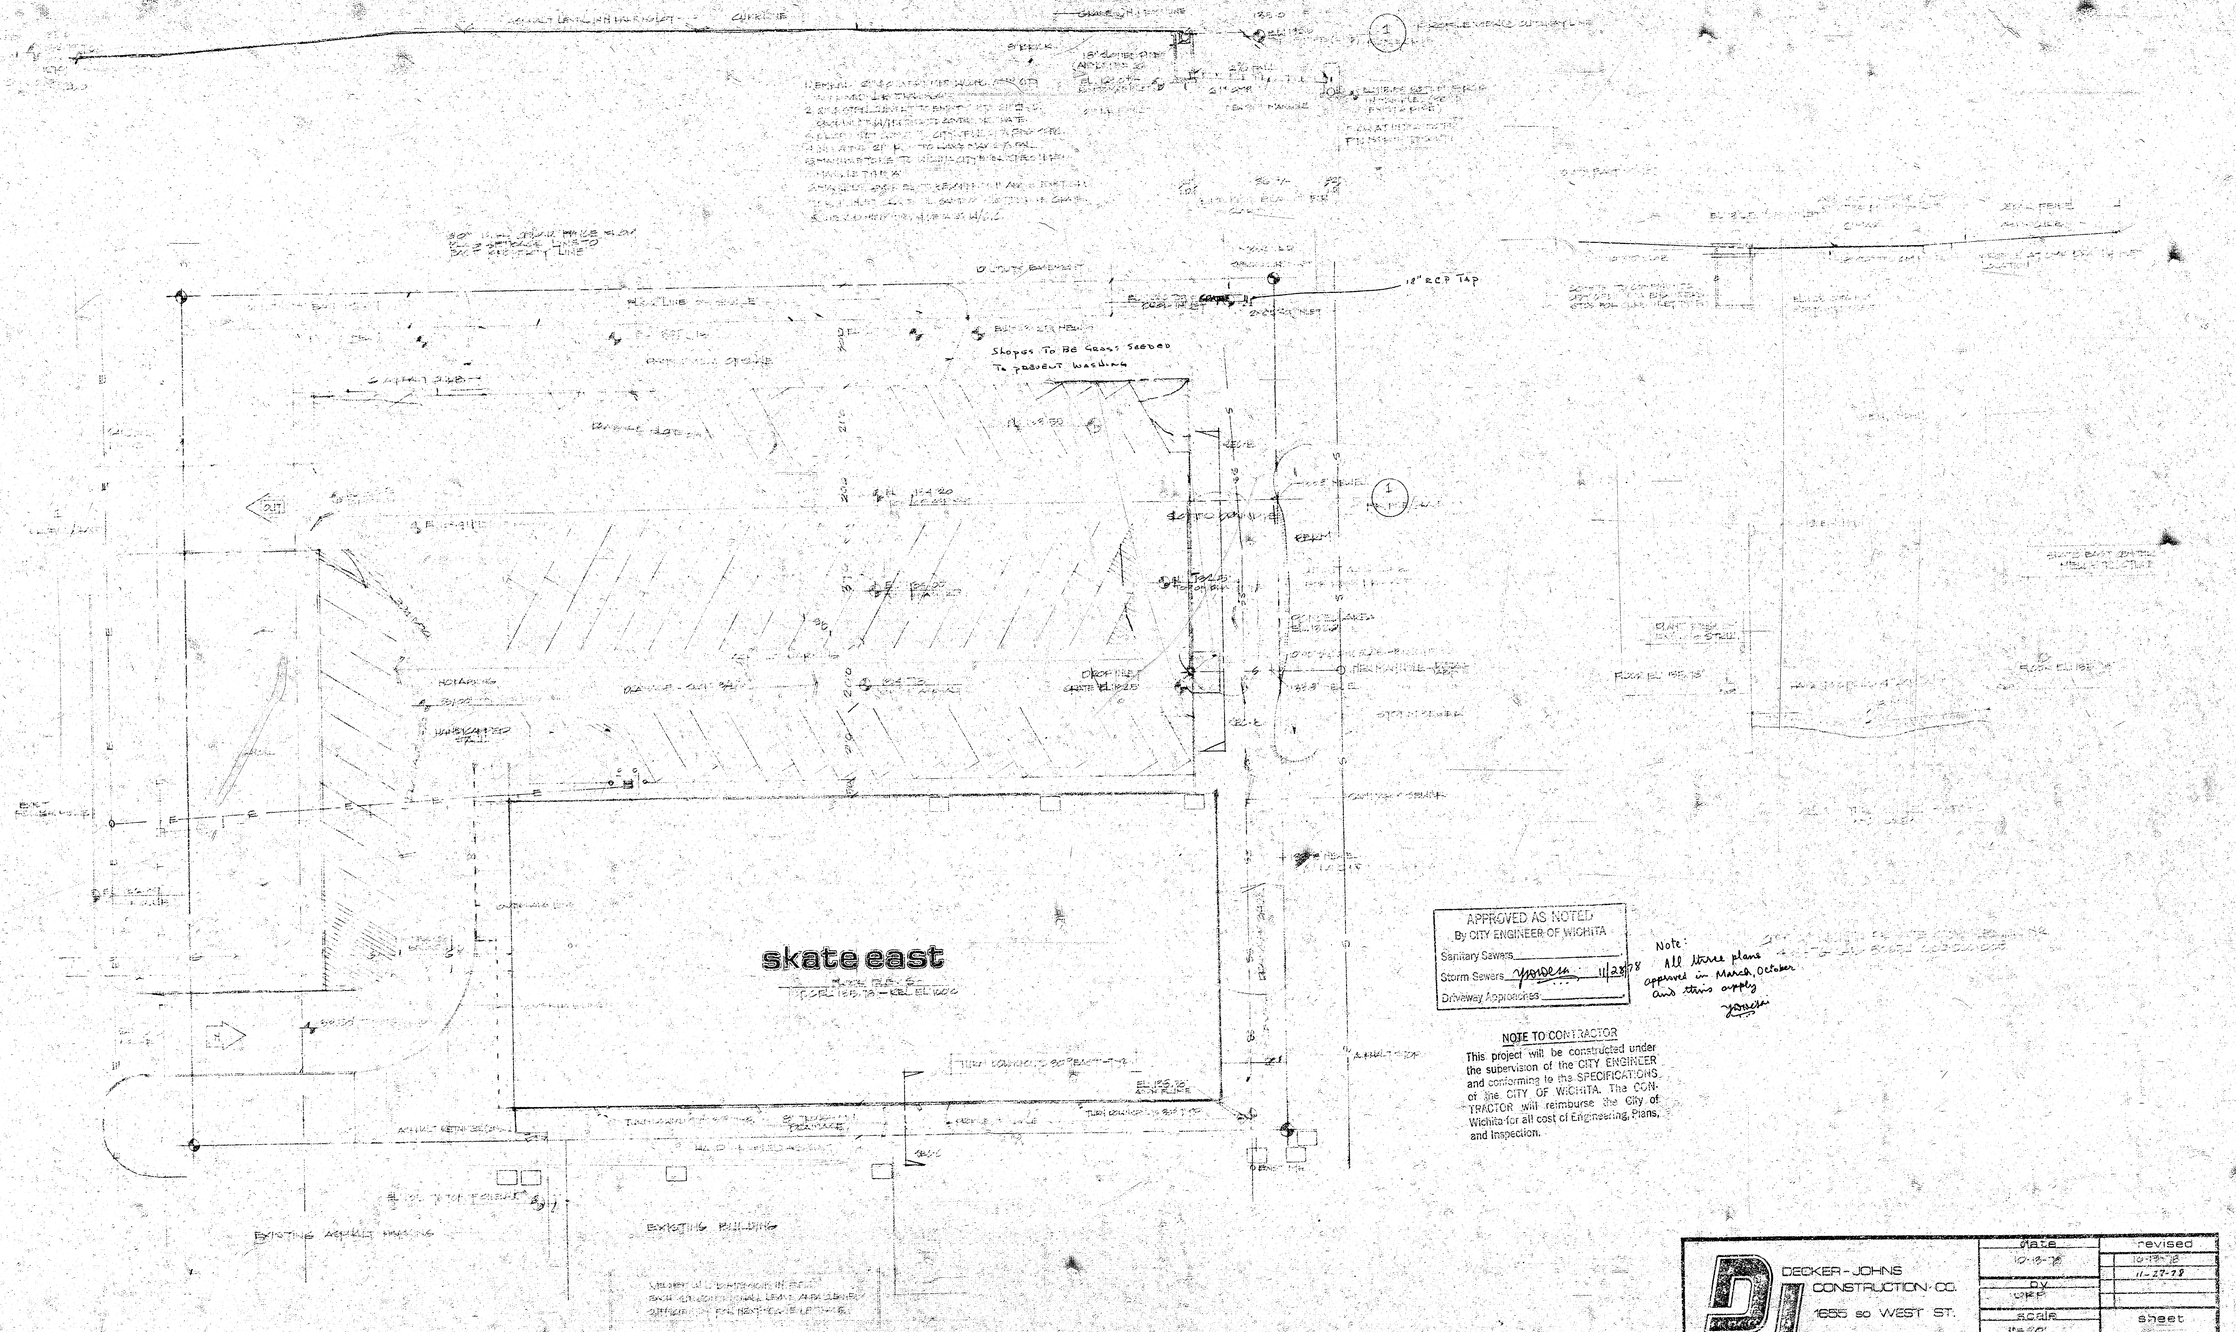


drainage

APPROVED AS NOTED
By CITY ENGINEER OF WICHITA
Sanitary Sewers _____
Storm Sewers [signature] 11/27/78
Driveway Approaches _____

Note:
All three plans approved in March, October and this supply
[signature]


NOTE TO CONTRACTOR
This project will be constructed under the supervision of the CITY ENGINEER and conforming to the SPECIFICATIONS of the CITY OF WICHITA. The CONTRACTOR will reimburse the City of Wichita for all cost of Engineering, Plans, and Inspection.

DECKER - JOHNS CONSTRUCTION CO.
1655 so WEST ST.
WICHITA, KS. 67213
9439347

date	revised
10-18-78	10-19-78
D.Y.	11-27-78
DRB	
scale	sheet
1"=20'	1/2
approved	
DM RA	

for: JIM WELLS - SKATE EAST - WICHITA

FILMED FROM THE BEST

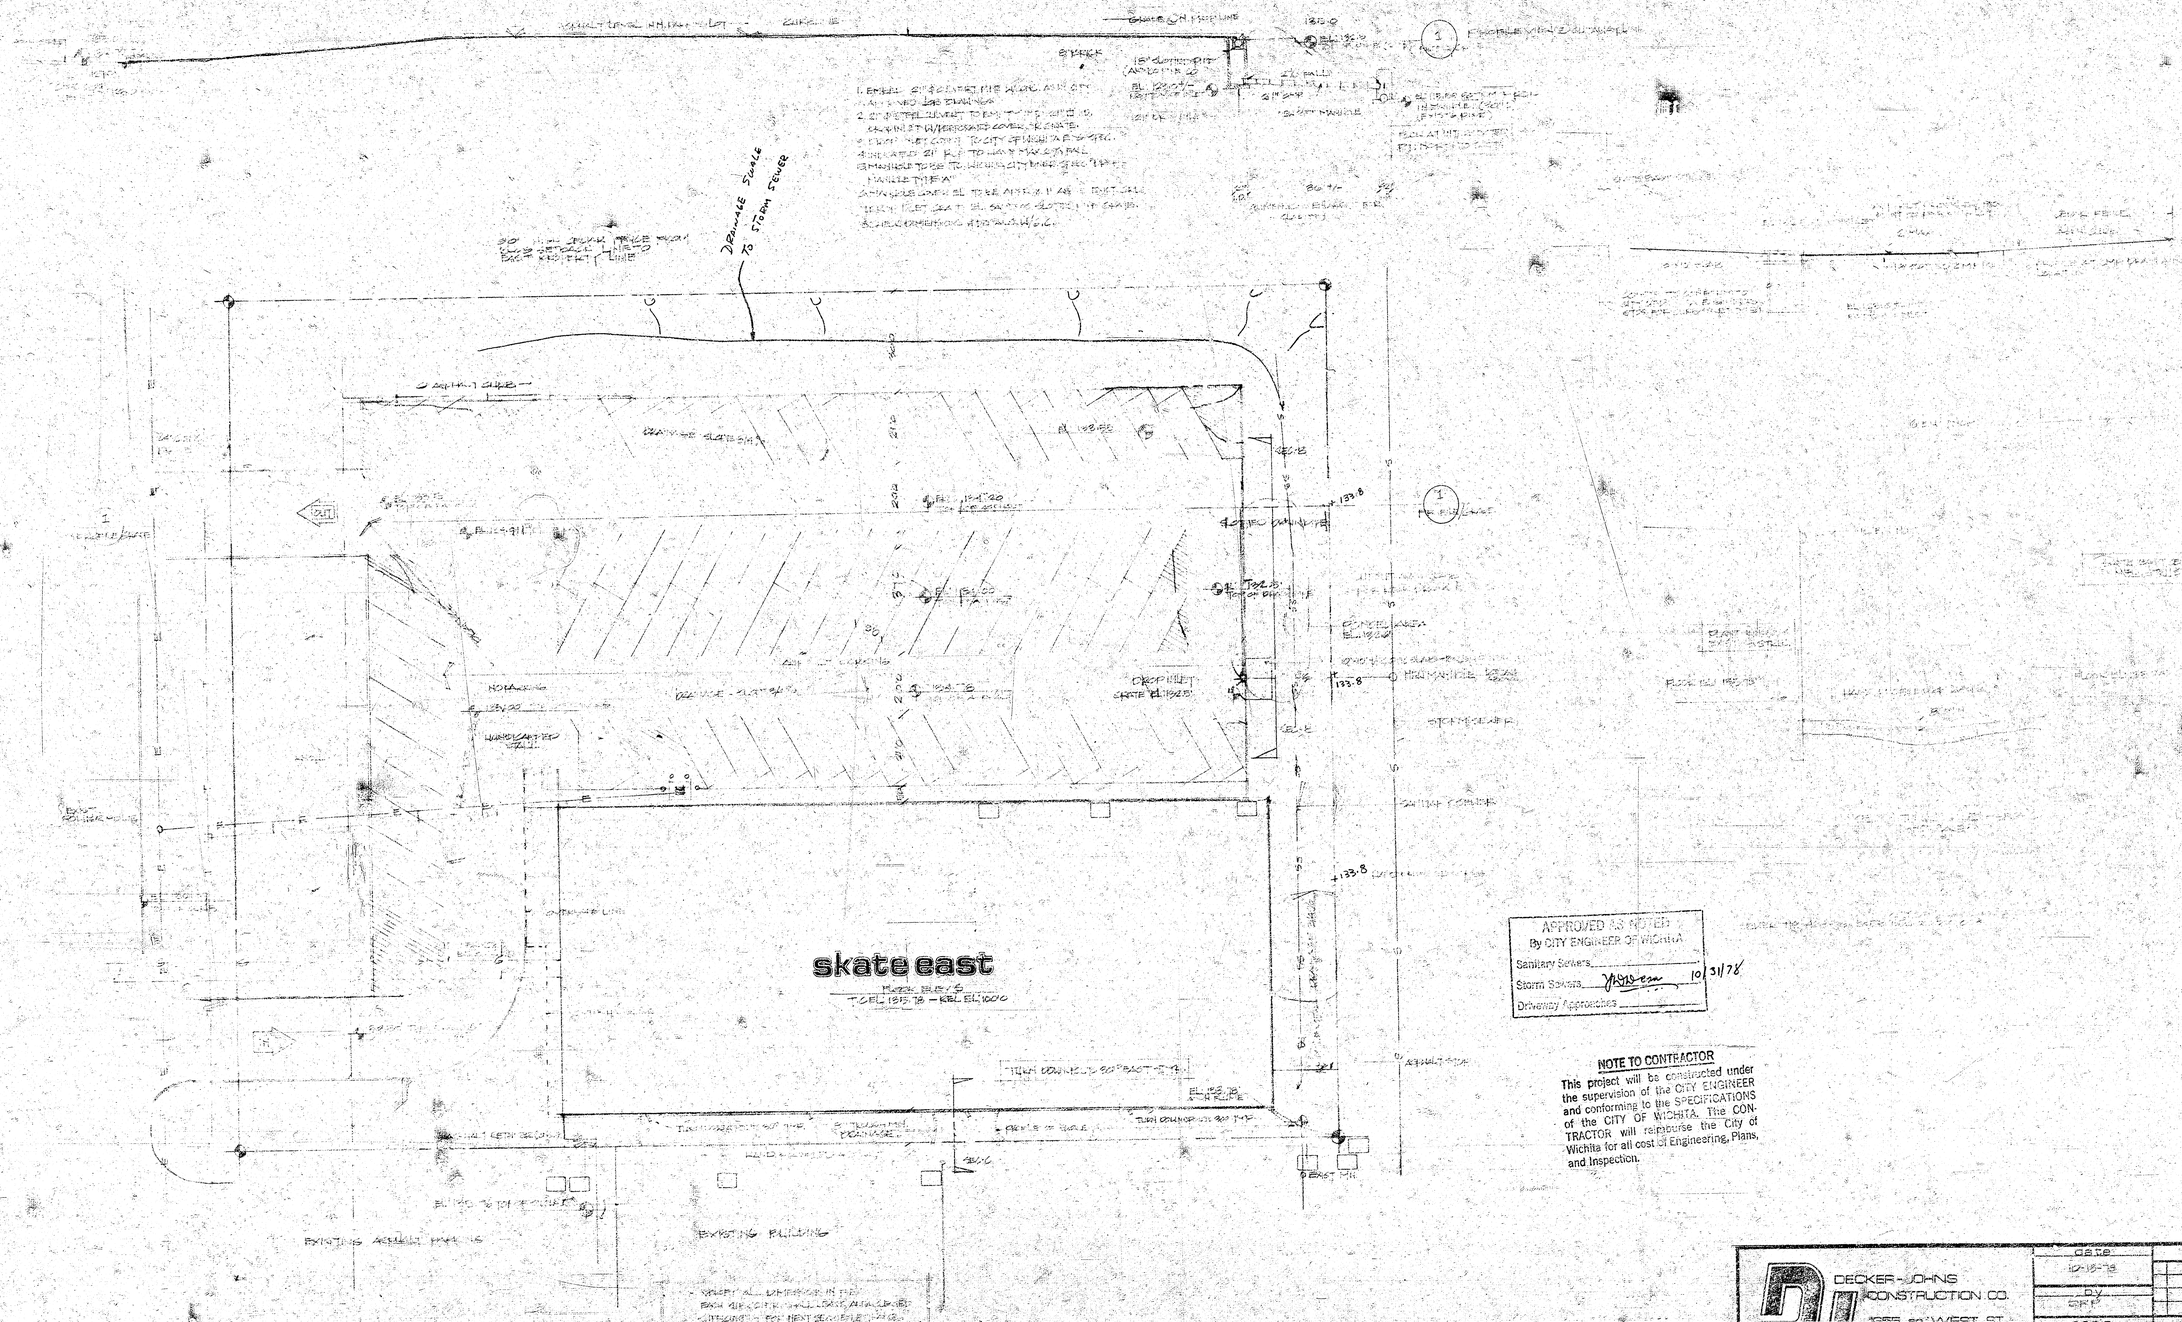

APPROVED AS NOTED
By CITY ENGINEER OF WICHITA
Sanitary Sewers _____
Storm Sewers _____ 10/31/78
Driveway Approaches _____

NOTE TO CONTRACTOR

This project will be constructed under the supervision of the CITY ENGINEER and conforming to the SPECIFICATIONS of the CITY OF WICHITA. The CONTRACTOR will reimburse the City of Wichita for all cost of Engineering, Plans, and Inspection.

DECKER-JOHNS CONSTRUCTION CO.
1655 so. WEST ST.
WICHITA, KS. 67213
9439347

date	revised
10-18-78	10-25-78
by	
DRF	
scale	sheet
1"=20'	2/2
approved	

for: JIM WELLS - EASTBAST - WICHITA

FILMED FROM THE BEST AVAILABLE COPY