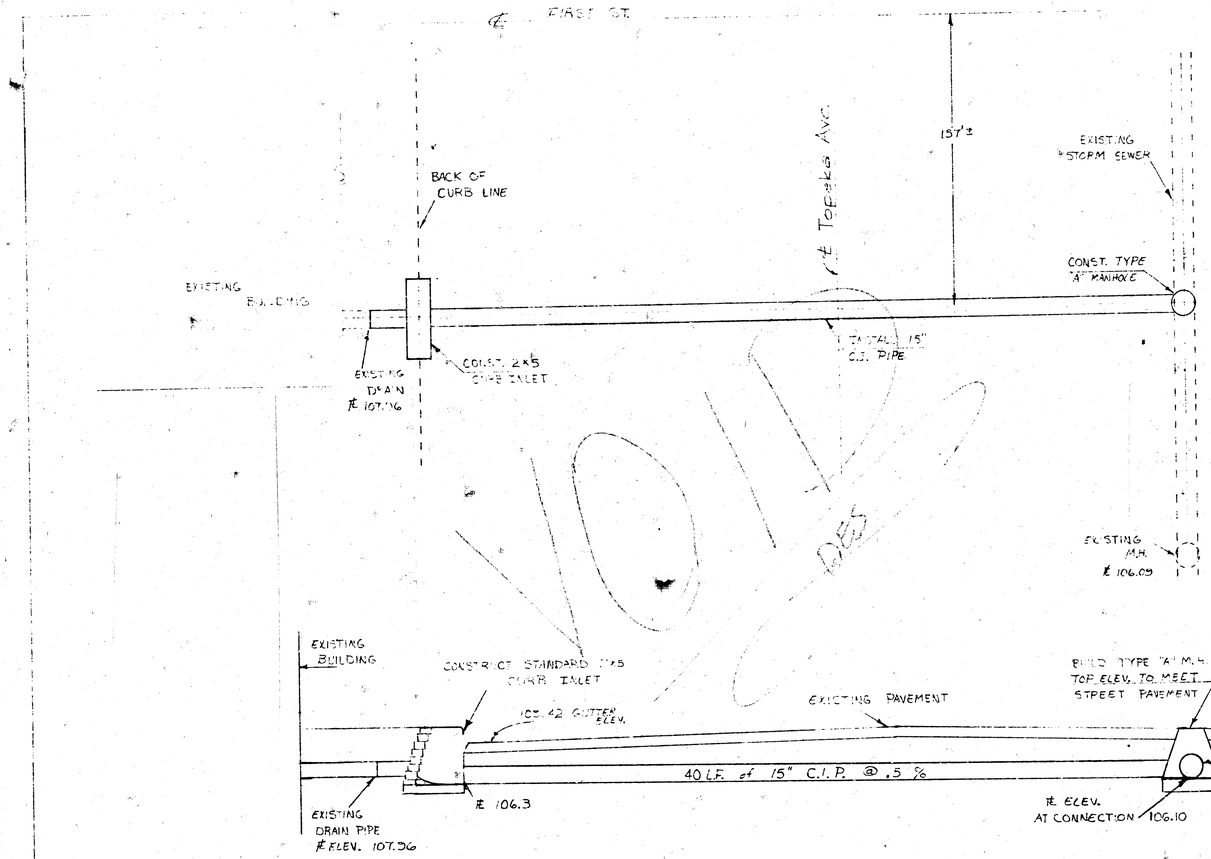

NOTE: TOP OF PIPE TO BE 1'-10" BELOW TOP OF PAVEMENT.

SCALE 1"=5'

E. 39. 24

APPROVED AS NOTED
By CITY ENGINEER OF WICHITA
Sanitary Sewers _____
Storm Sewers N. F. _____
Driveway Approaches _____

NOTE TO CONTRACTOR:
This project will be constructed under the supervision of the CITY ENGINEER and conforming to the SPECIFICATIONS of the CITY OF WICHITA. The CONTRACTOR will notify the City of Wichita for all construction staking, plans, and inspection.

City Proj. No. DBKW706039

ROOF DRAIN SYS. BELL TELE.
1ST & TOPEKA
6-25-76
UTILITY CONTRACTOR'S RICH

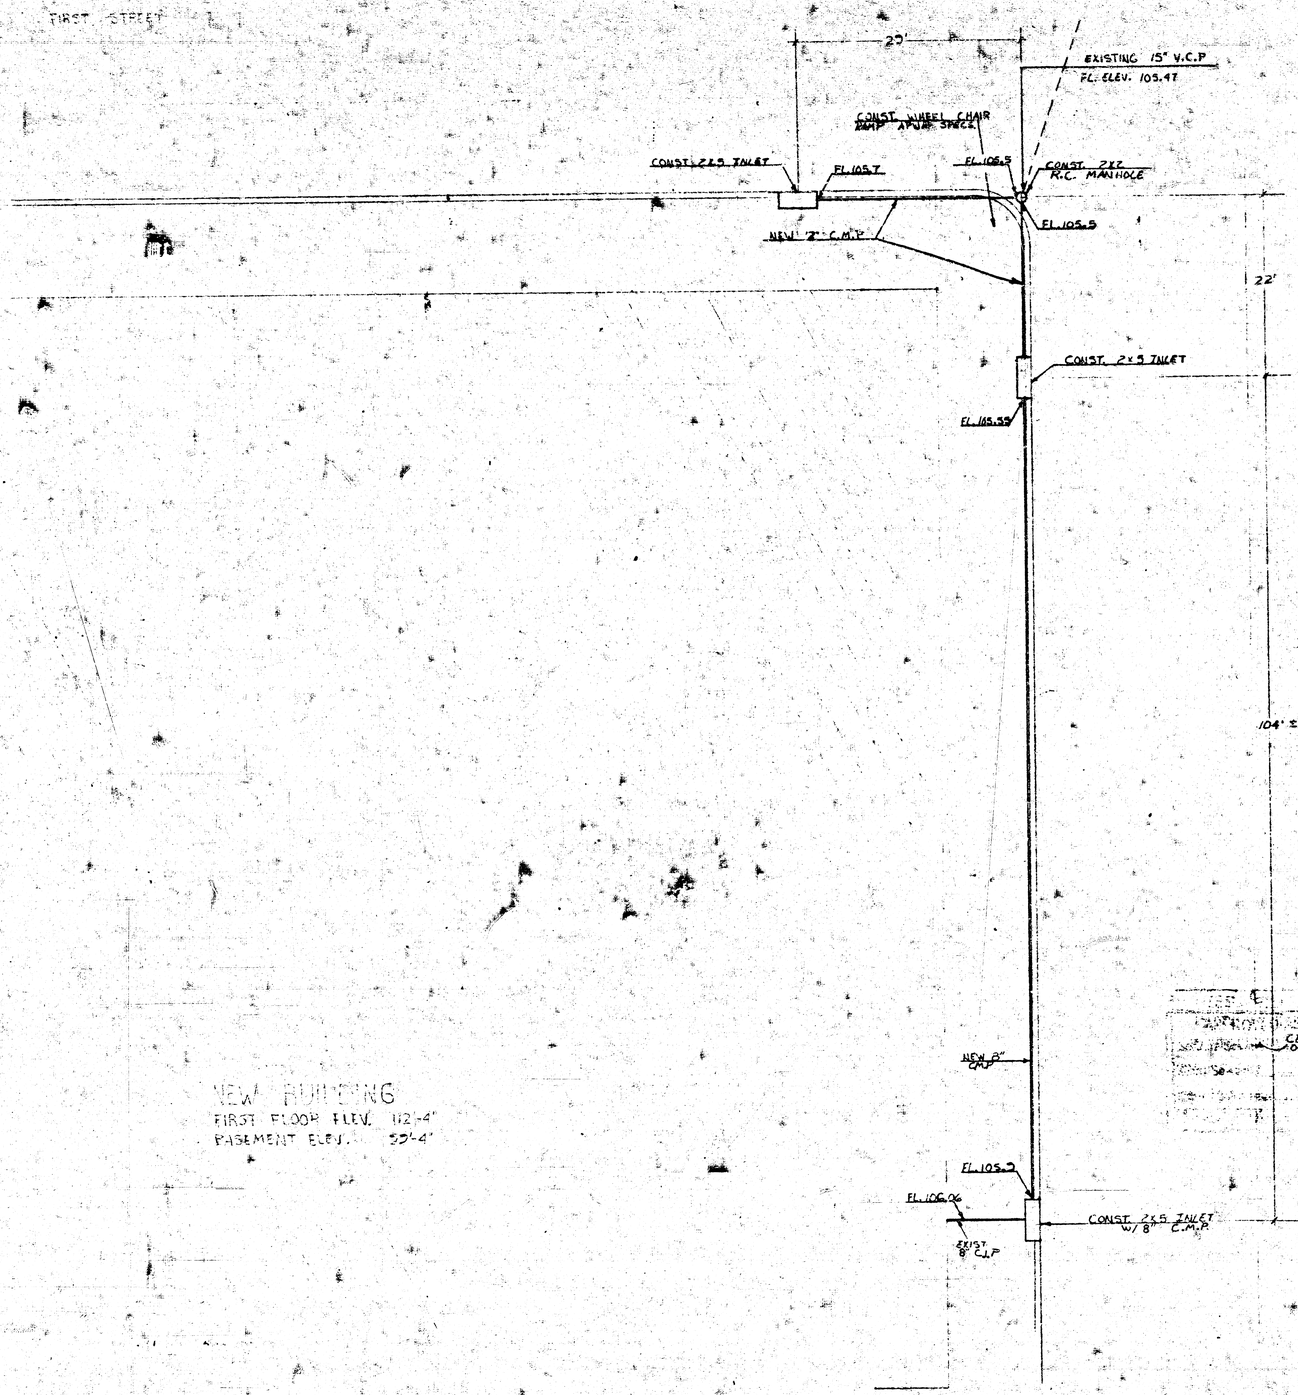

7-12-76

APPROVED AS NOTED
By CITY ENGINEER OF WICHITA
Sanitary Sewers
Storm Sewers O.E.S.
Driveway Approaches

1" = 10'

DBKW706039

STORM SEWER RECONSTRUCTION
SOUTHWEST CORNER FIRST & TOPEKA