

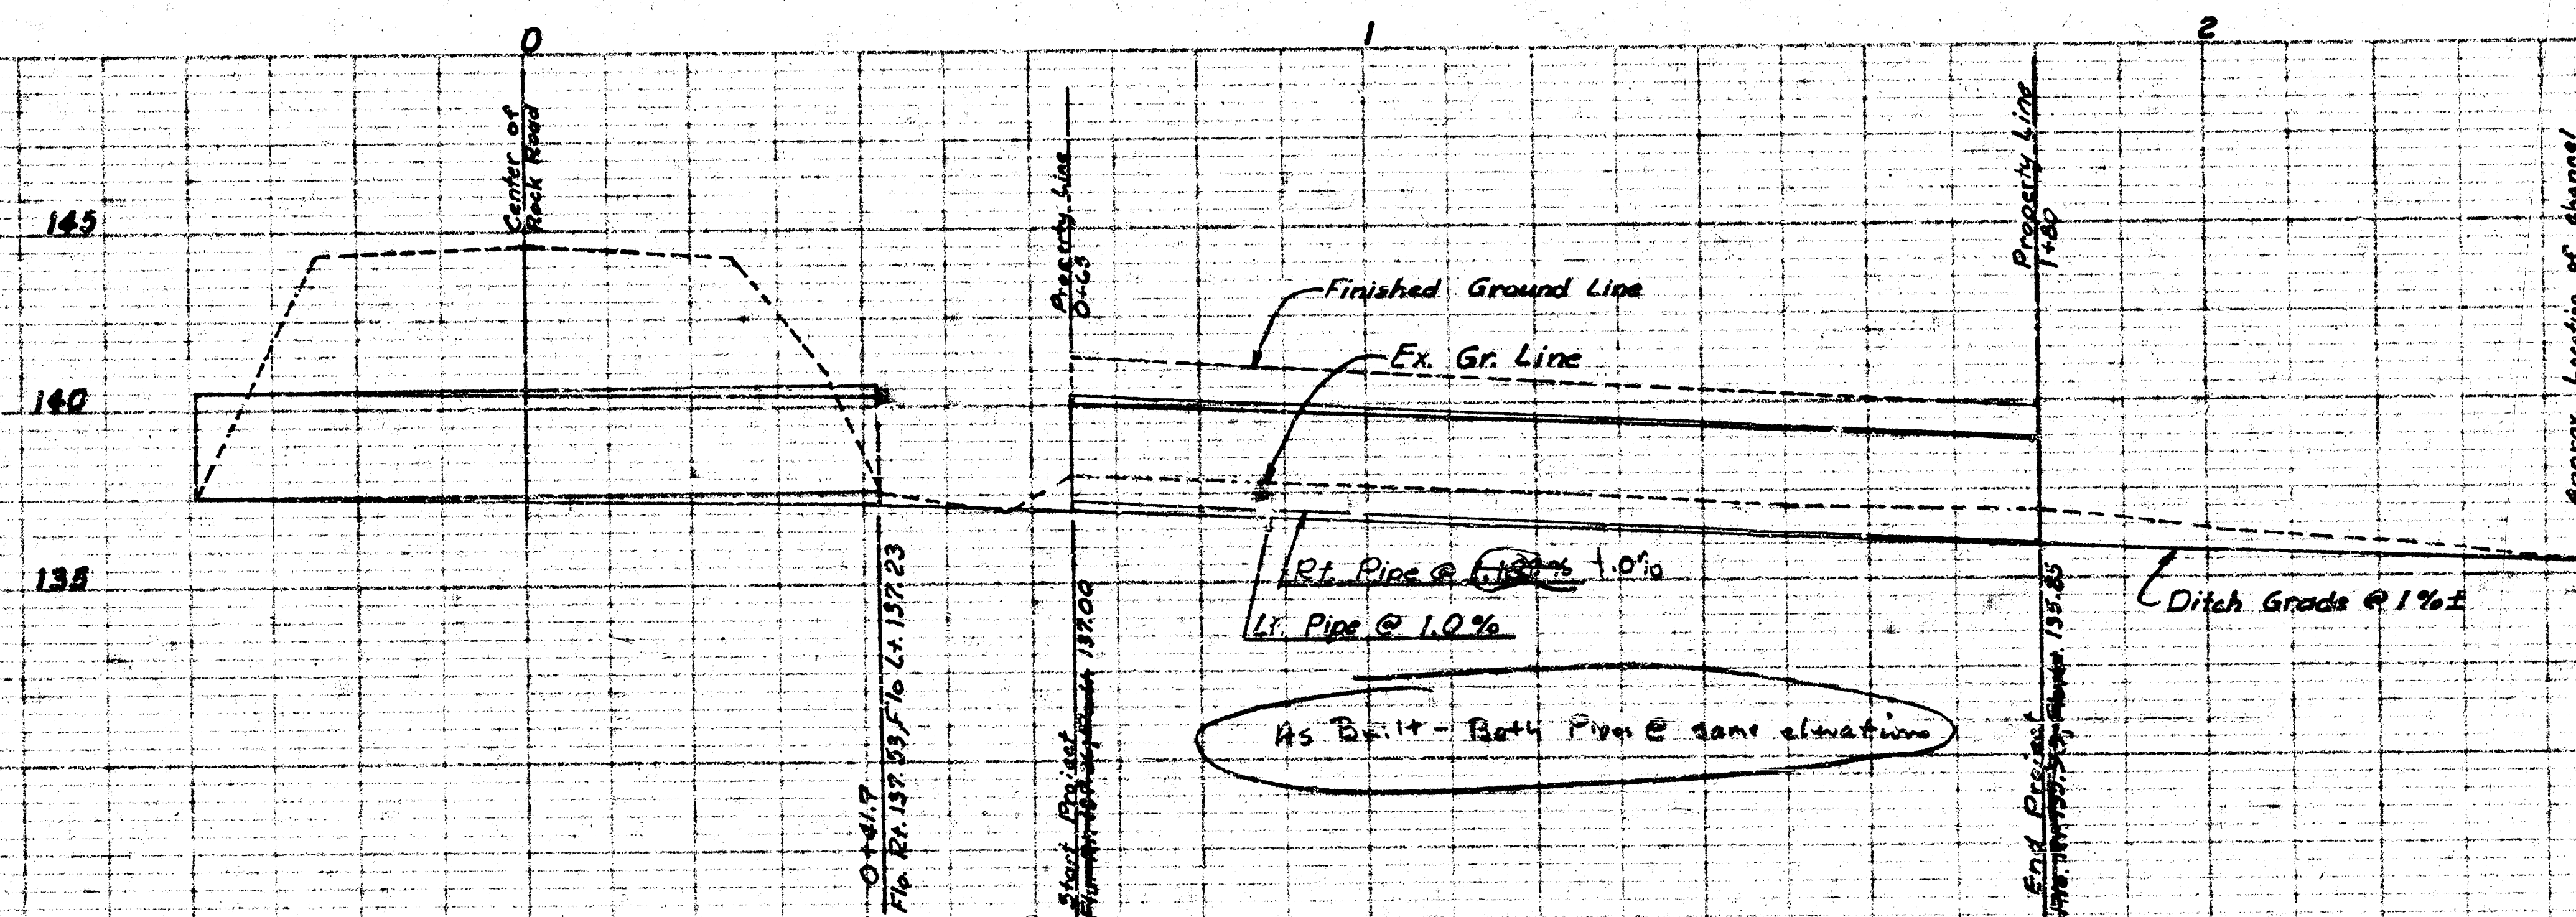
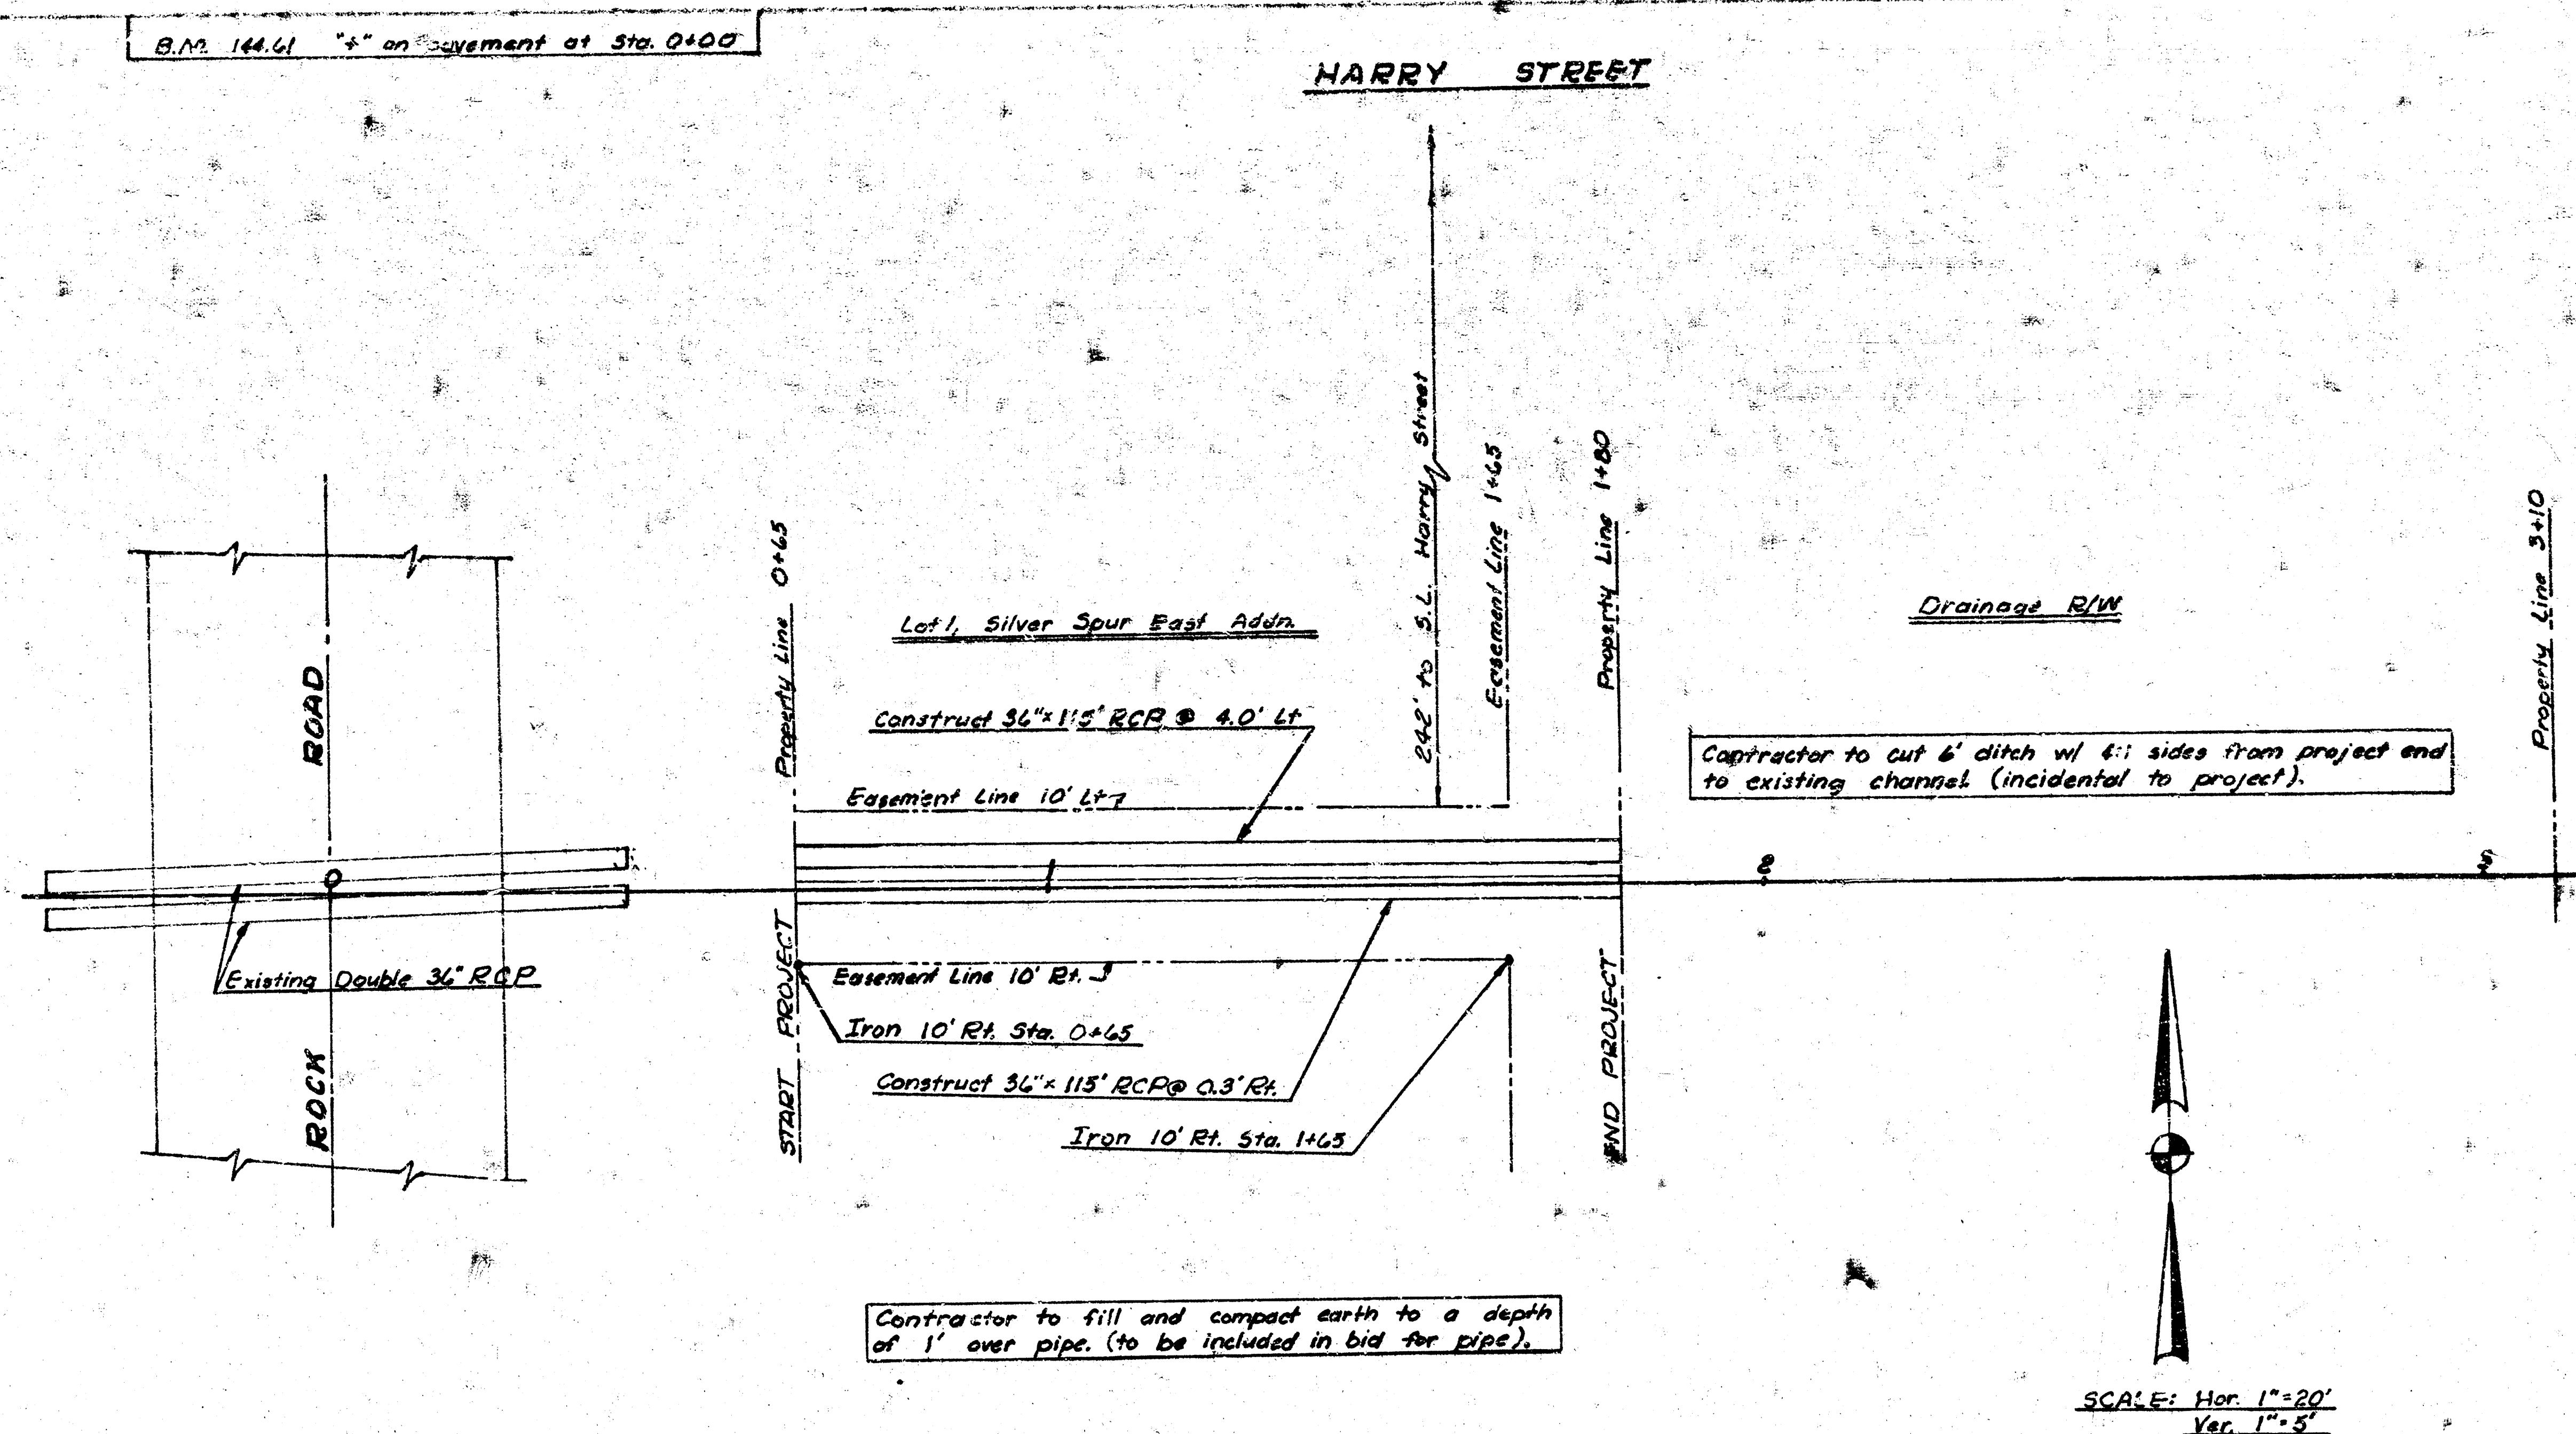


NOTE TO CONTRACTOR

This project will be constructed under the supervision of the CITY ENGINEER and conforming to the SPECIFICATIONS of the CITY OF WICHITA. The CONTRACTOR will reimburse the City of Wichita for all cost of Engineering, Plans, and Inspection.

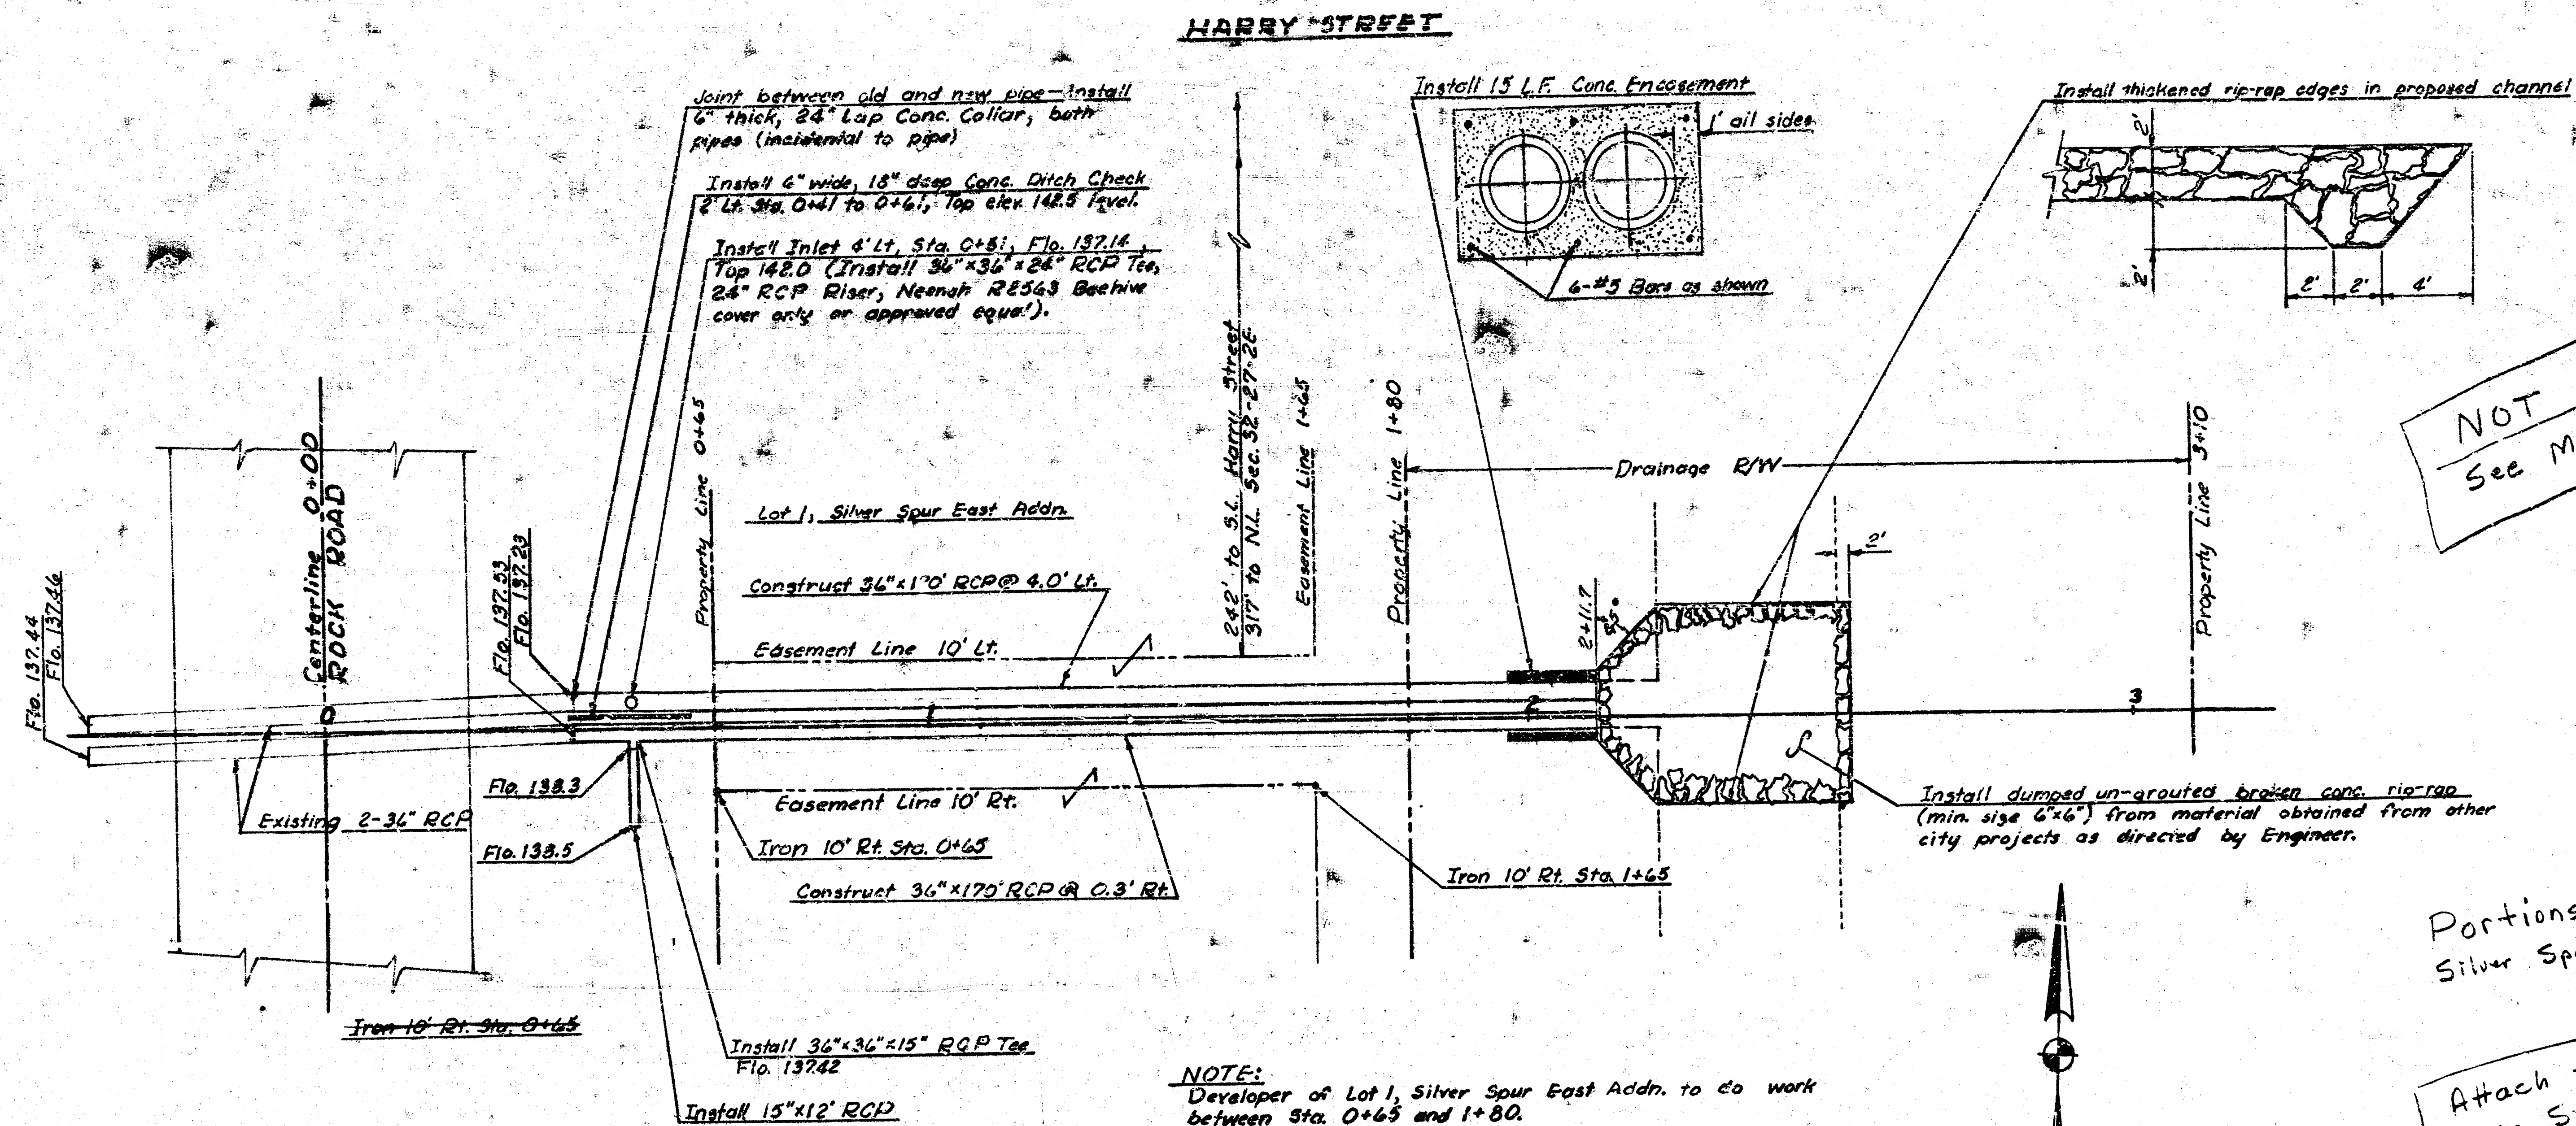

**MAIN STORM DRAIN
LOT 1, SILVER SPUR E.
ADDITION**
R.W. Linn, City Engineer
City of Wichita
Date: June, 1972
Project No. AAKB 502023
Private Project

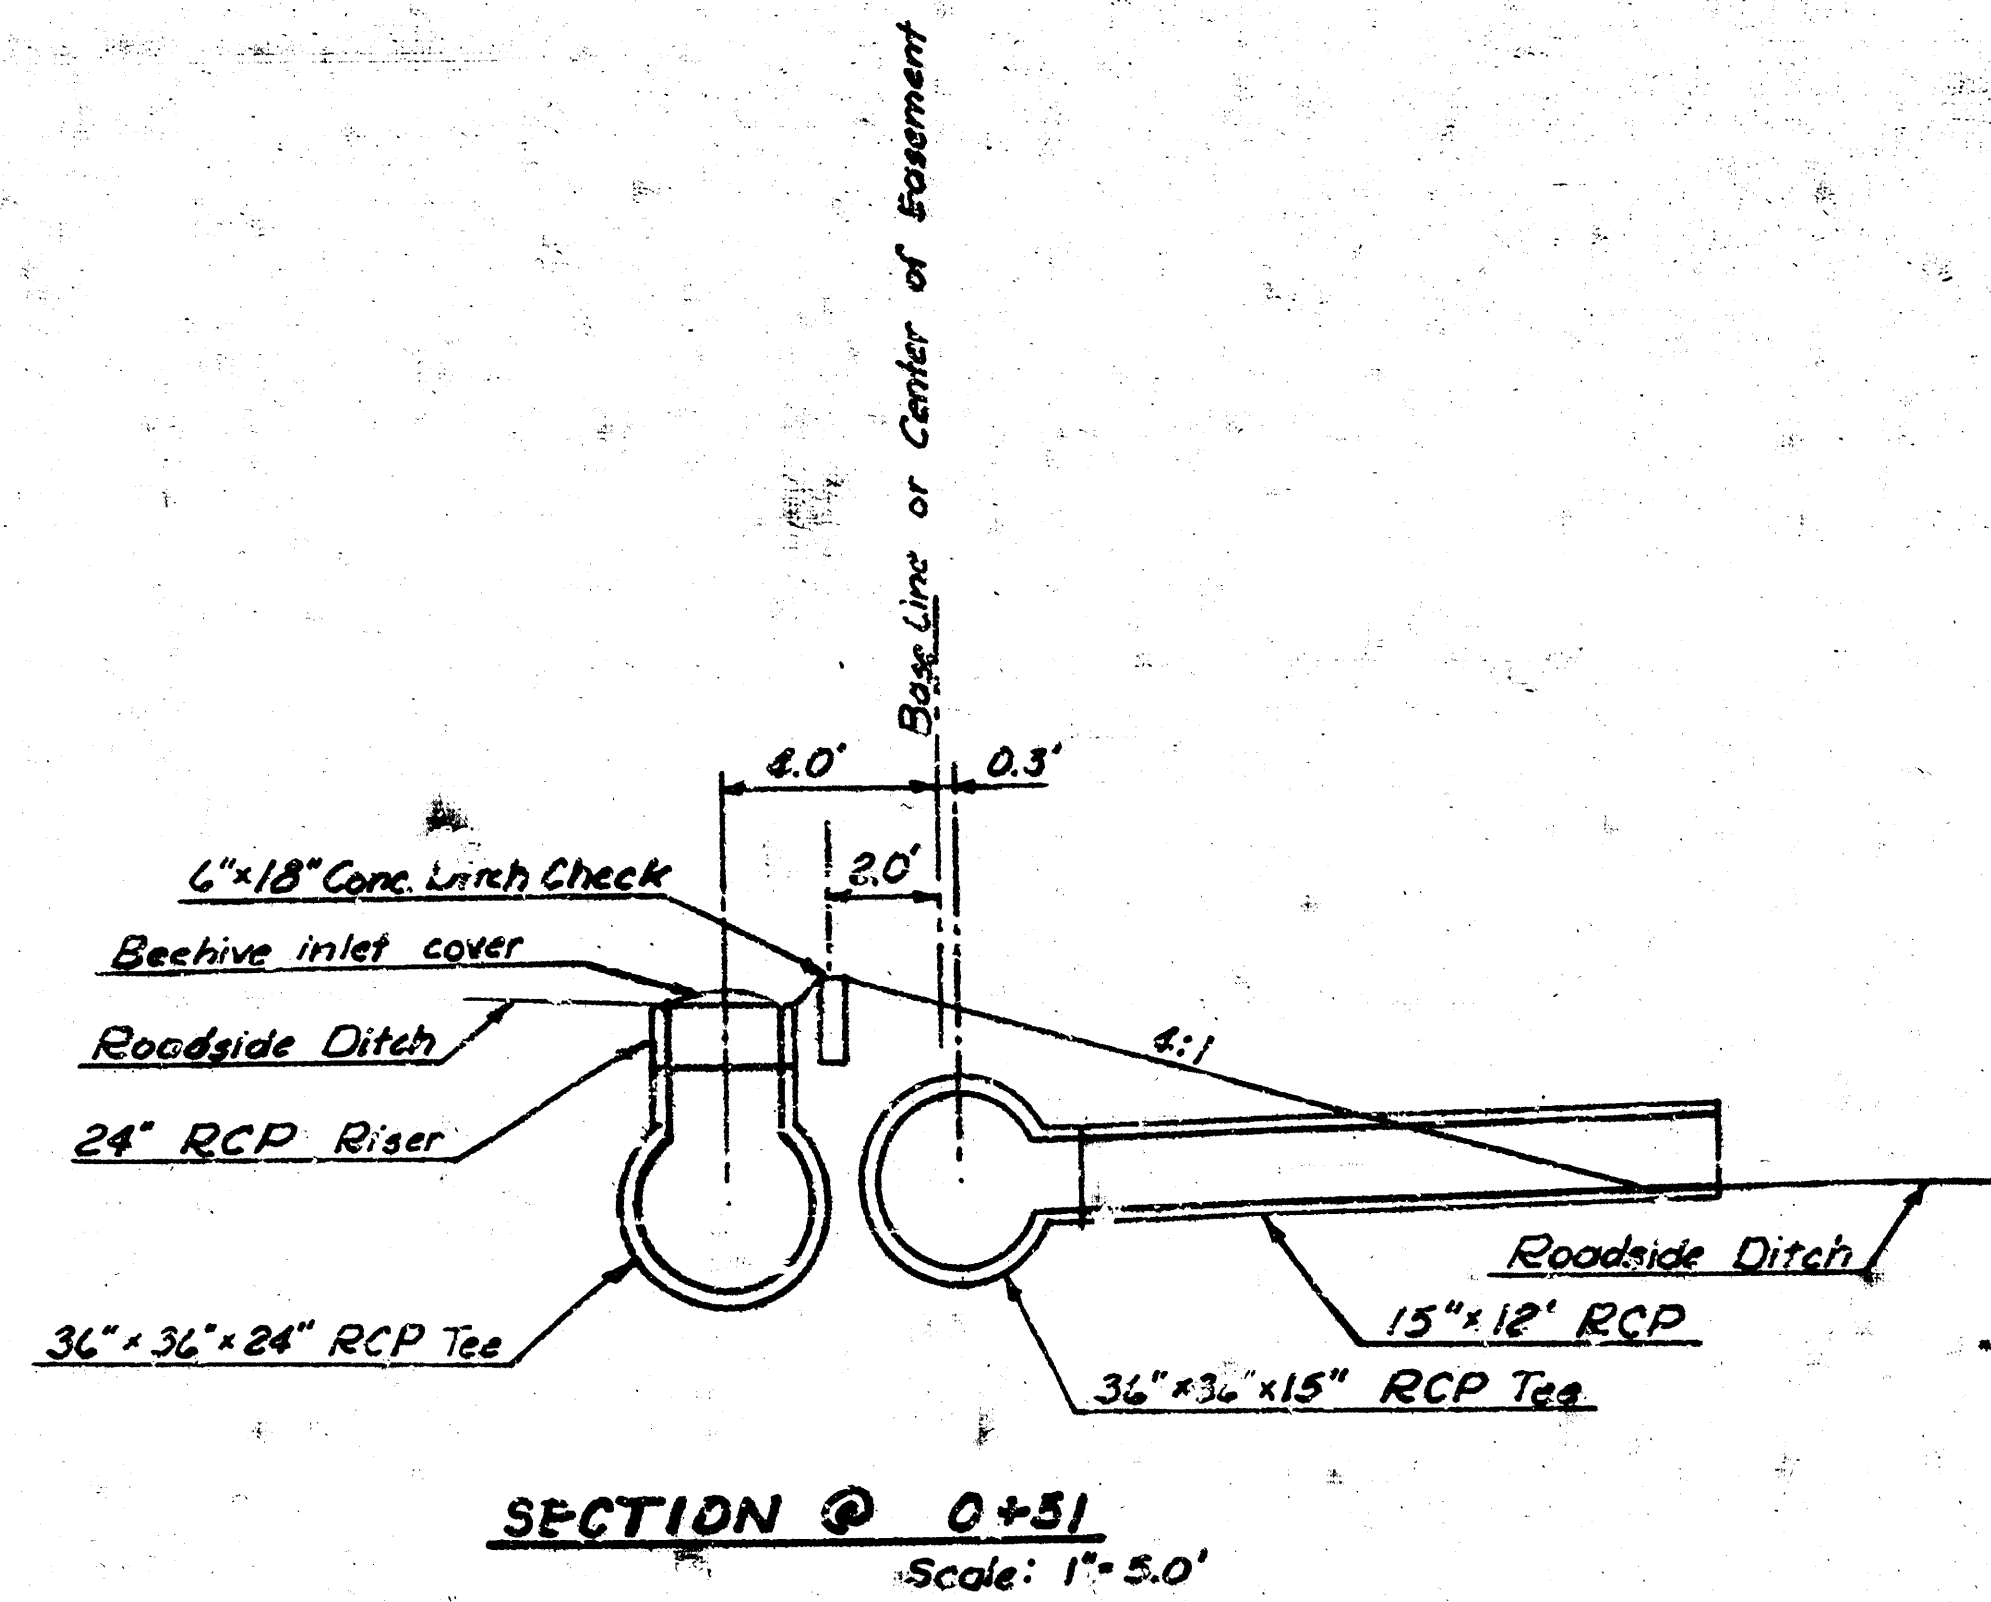

NOT BUILT
See MAIN STORM

Portions east & west
Silver Spur East Addn. not

Attach to and file with
Main Storm Drain #15
for future reference

