

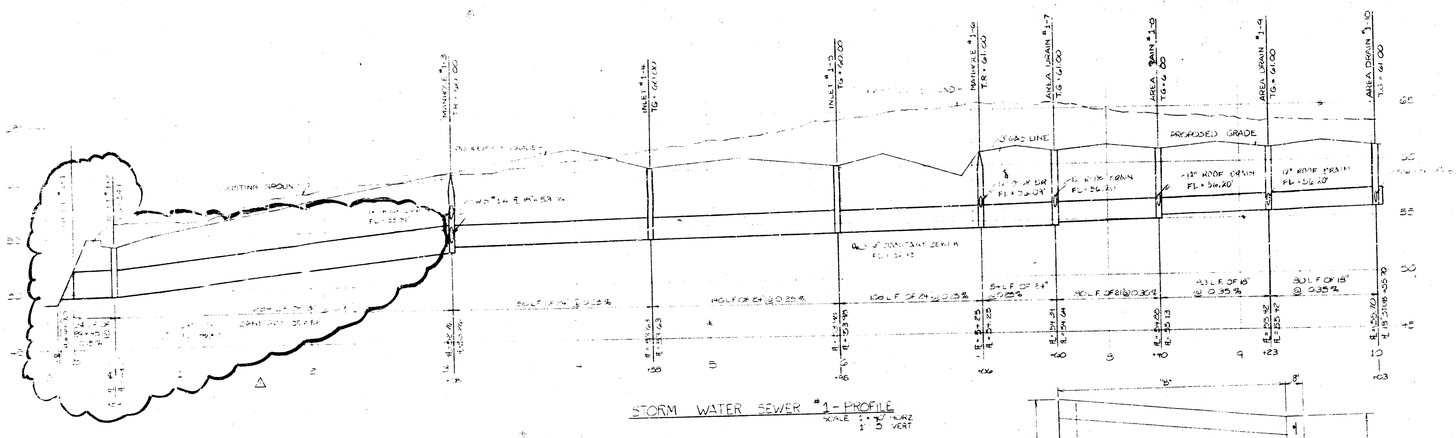



STORM WATER SEWER #1 - PROFILE
SCALE 1" = 10' HORZ
1" = 5' VERT

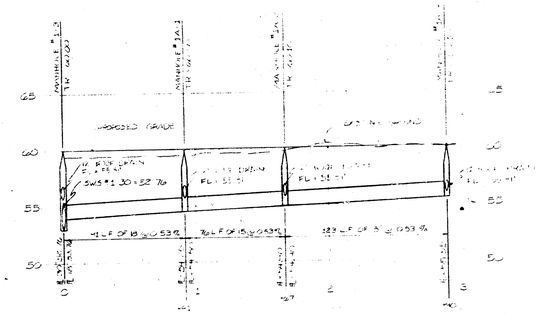


STORM WATER SEWER #1A - PROFILE
SCALE 1" = 10' HORZ
1" = 5' VERT

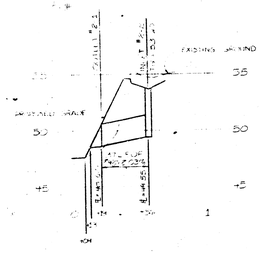


STORM WATER SEWER #2 - PROFILE
SCALE 1" = 10' HORZ
1" = 5' VERT

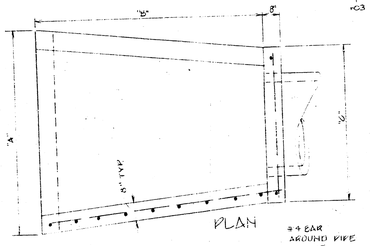


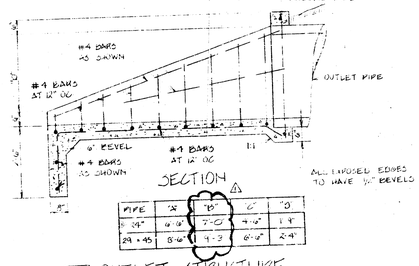

5 OUTLET STRUCTURE
(N.T.S.)

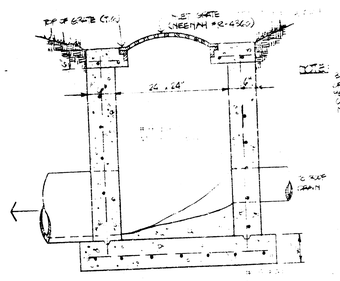


AREA DRAIN
(N.T.S.)

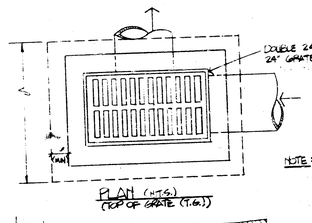


PLAN (N.T.S.)
(TOP OF GRATE (T.G.))


NOTE: BRICK WALLS SHALL BE CITY OF WICHITA STANDARD MAY BE USED IN LIEU OF REINFORCED CONCRETE WALLS ON "A" INLETS

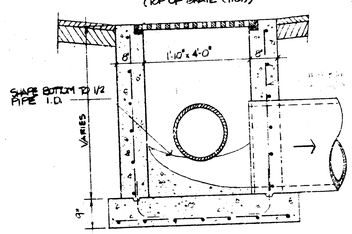


2 TYPE 'A' DRAIN INLET
(N.T.S.)

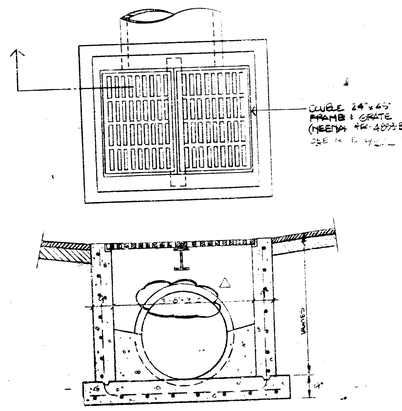


3 TYPE 'B' DRAIN INLET
(N.T.S.)

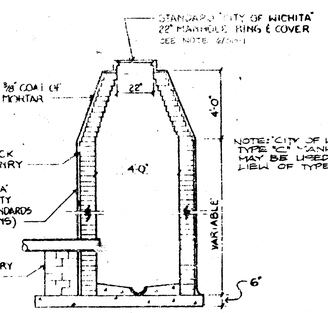

6 MANHOLE DETAIL

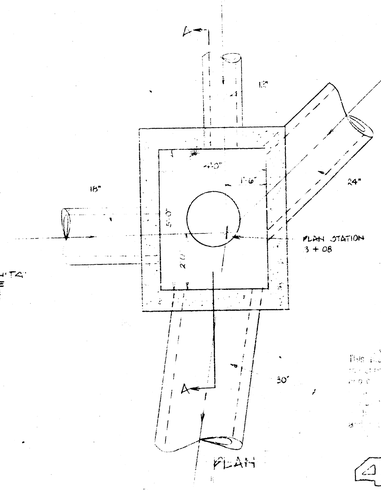

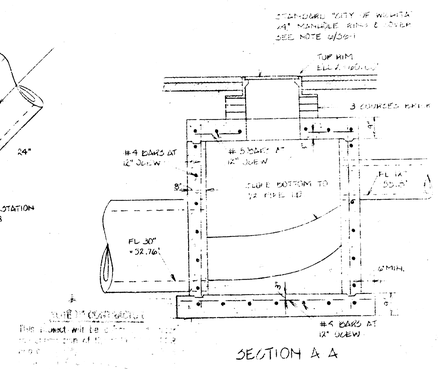

4 MANHOLE # 1-3
1/2" = 1'

PRINTS ISSUED

DATE	PURPOSE	NO.

FOR CONSTRUCTION: [illegible] 79

REVISIONS

DATE	ITEM	NO.

LAW/KINGDON, P.A.
313 E. MARKET WICHITA, KANSAS 67202
PHONE (316) 262-2684
ARCHITECTS & ENGINEERS

REGISTERED ARCHITECT
BEN J. KINGDON
1976
STATE OF KANSAS

ROBERT E. FRIESEN
LICENSED PROFESSIONAL ENGINEER
STATE OF KANSAS

Copyright ©1978 Law/Kingdon, P.A.

DRAWN	CHECKED
BWA	REF

RELATED DRAWINGS

SHELL	
DETAILS	
STRUCTURE	
MECHANICAL	
ELECTRICAL	
OTHER	

SEQUENCE NUMBER
OF SHEETS

TARGET EAST
Wichita, Kansas
PROJECT NUMBER 7881


XEY PLAN

TENANT


STORM WATER SEWER DETAILS
SHEET TITLE

TENANT NUMBER	SHEET NUMBER
2/2	SG-2


OF SHEETS

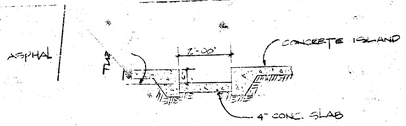


3 DRAIN THRU ISLAND

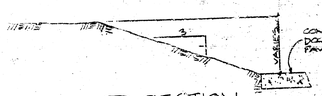

2 SECTION

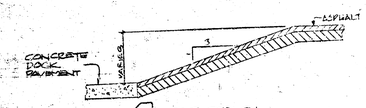

1 SECTION

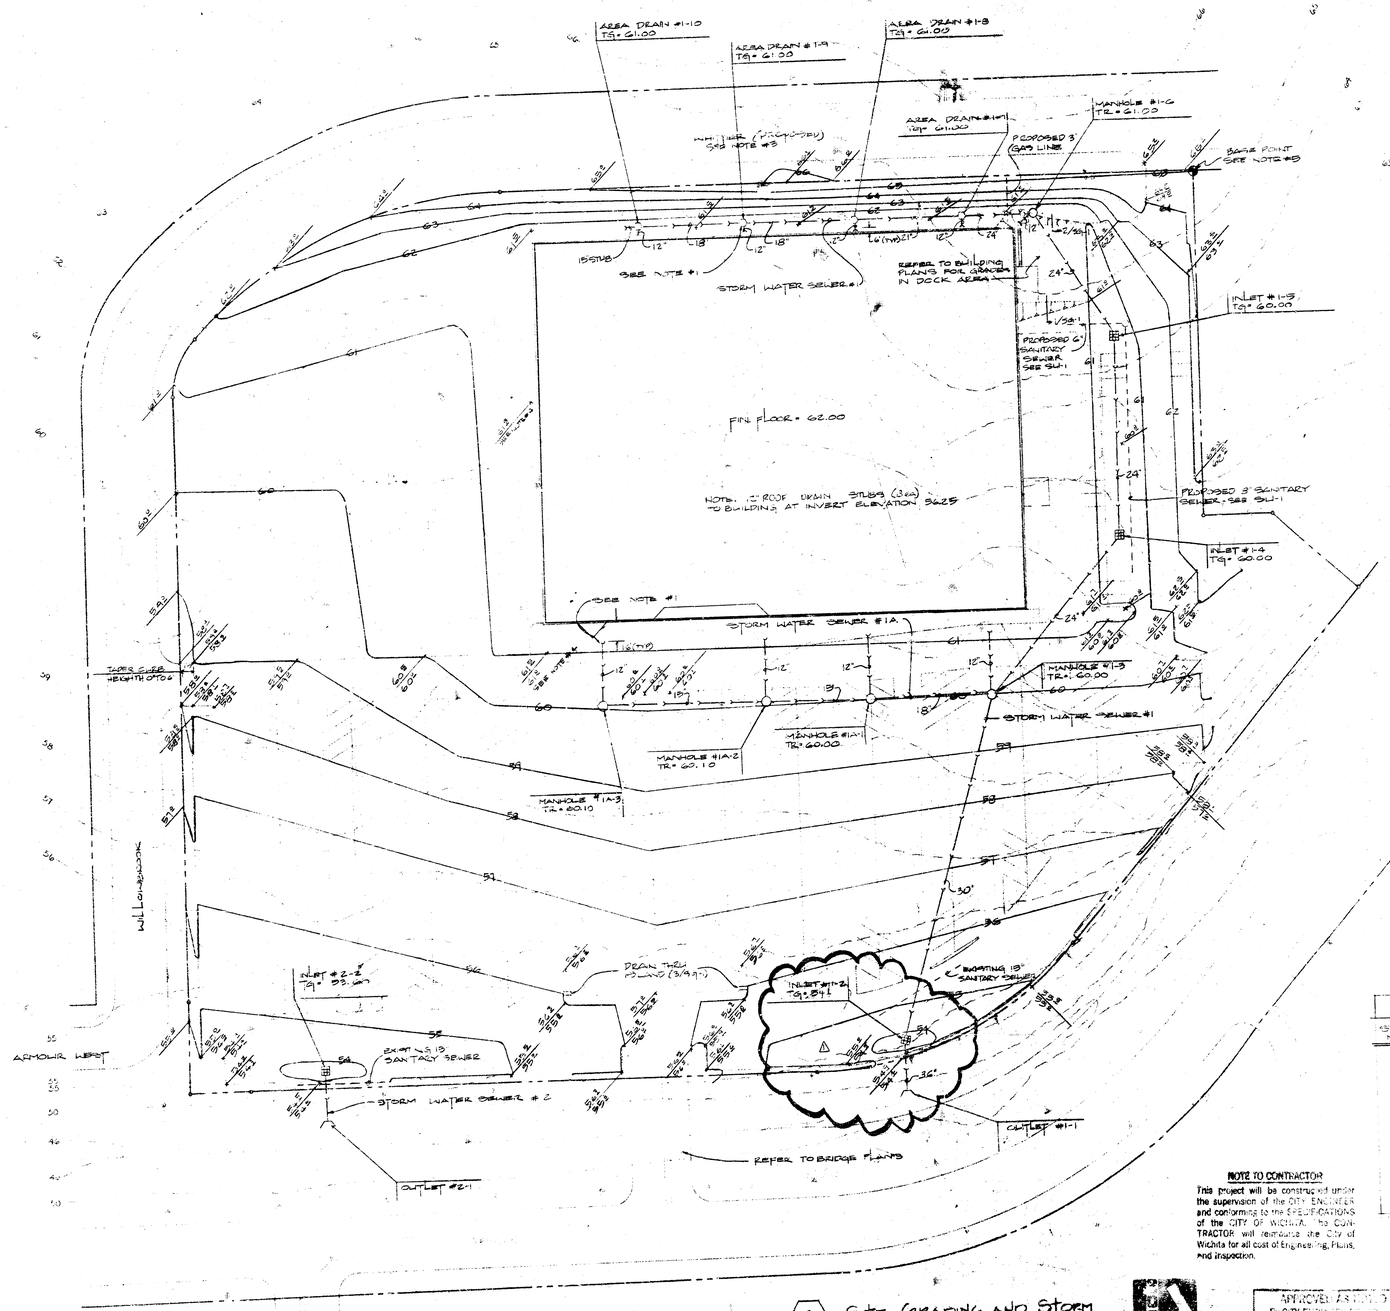

A SITE GRADING AND STORM WATER SEWER PLAN

T-140'-0"

NOTES

1. CONTRACTOR TO VERIFY & COORDINATE EXACT LOCATION OF ROOF DRAINS DOCK DRAINAGE WITH PLUMBING DRAWINGS & MAKE ADJUSTMENTS AS REQUIRED
2. FINISH GRADES SHOWN ARE TO THE TOP OF PAVEMENT OR GRASSED AREA
3. [illegible]
4. [illegible]
5. [illegible]
6. [illegible]

NOTE TO CONTRACTOR

This project will be constructed under the supervision of the CITY ENGINEER and conforming to the SPECIFICATIONS of the CITY OF WICHITA. The CONTRACTOR will reimburse the City of Wichita for all cost of Engineering, Plans, and Inspection.

APPROVED AS NOTED
By CITY ENGINEER'S OFFICE
Specialty Items
Storm [illegible]
Drawing No. SG-1

LEGEND

60	EXISTING CONTOUR
60	NEW CONTOUR
x 61.2	NEW SPOT ELEVATION
	DRAIN INLET
	AREA DRAIN
	MANHOLE
	STORM WATER SEWER

STRUCTURE TABLE

STRUCTURE NUMBER	TYPE OF STRUCTURE	DETAIL NUMBER	LOCATION FROM SHEET LINE SOUTH	LOCATION FROM SHEET LINE EAST

LAW/KINGDON, P.A.
ARCHITECTS & ENGINEERS

Copyright © 1978 Law/Kingdon, PA.

DRAWN	CHECKED
JLW/JRT	PDF

RELATED DRAWINGS
SPECS
DETAILS
STRUCTURAL
MECHANICAL
ELECTRICAL
OTHER

SEQUENCE NUMBER
OF SHEETS

TARGET EAST
Wichita, Kansas
PROJECT NUMBER 7881

KEY PLAN

TITLE
SITE GRADING PLAN
SHEET NO.

SHEET NUMBER SG-1