


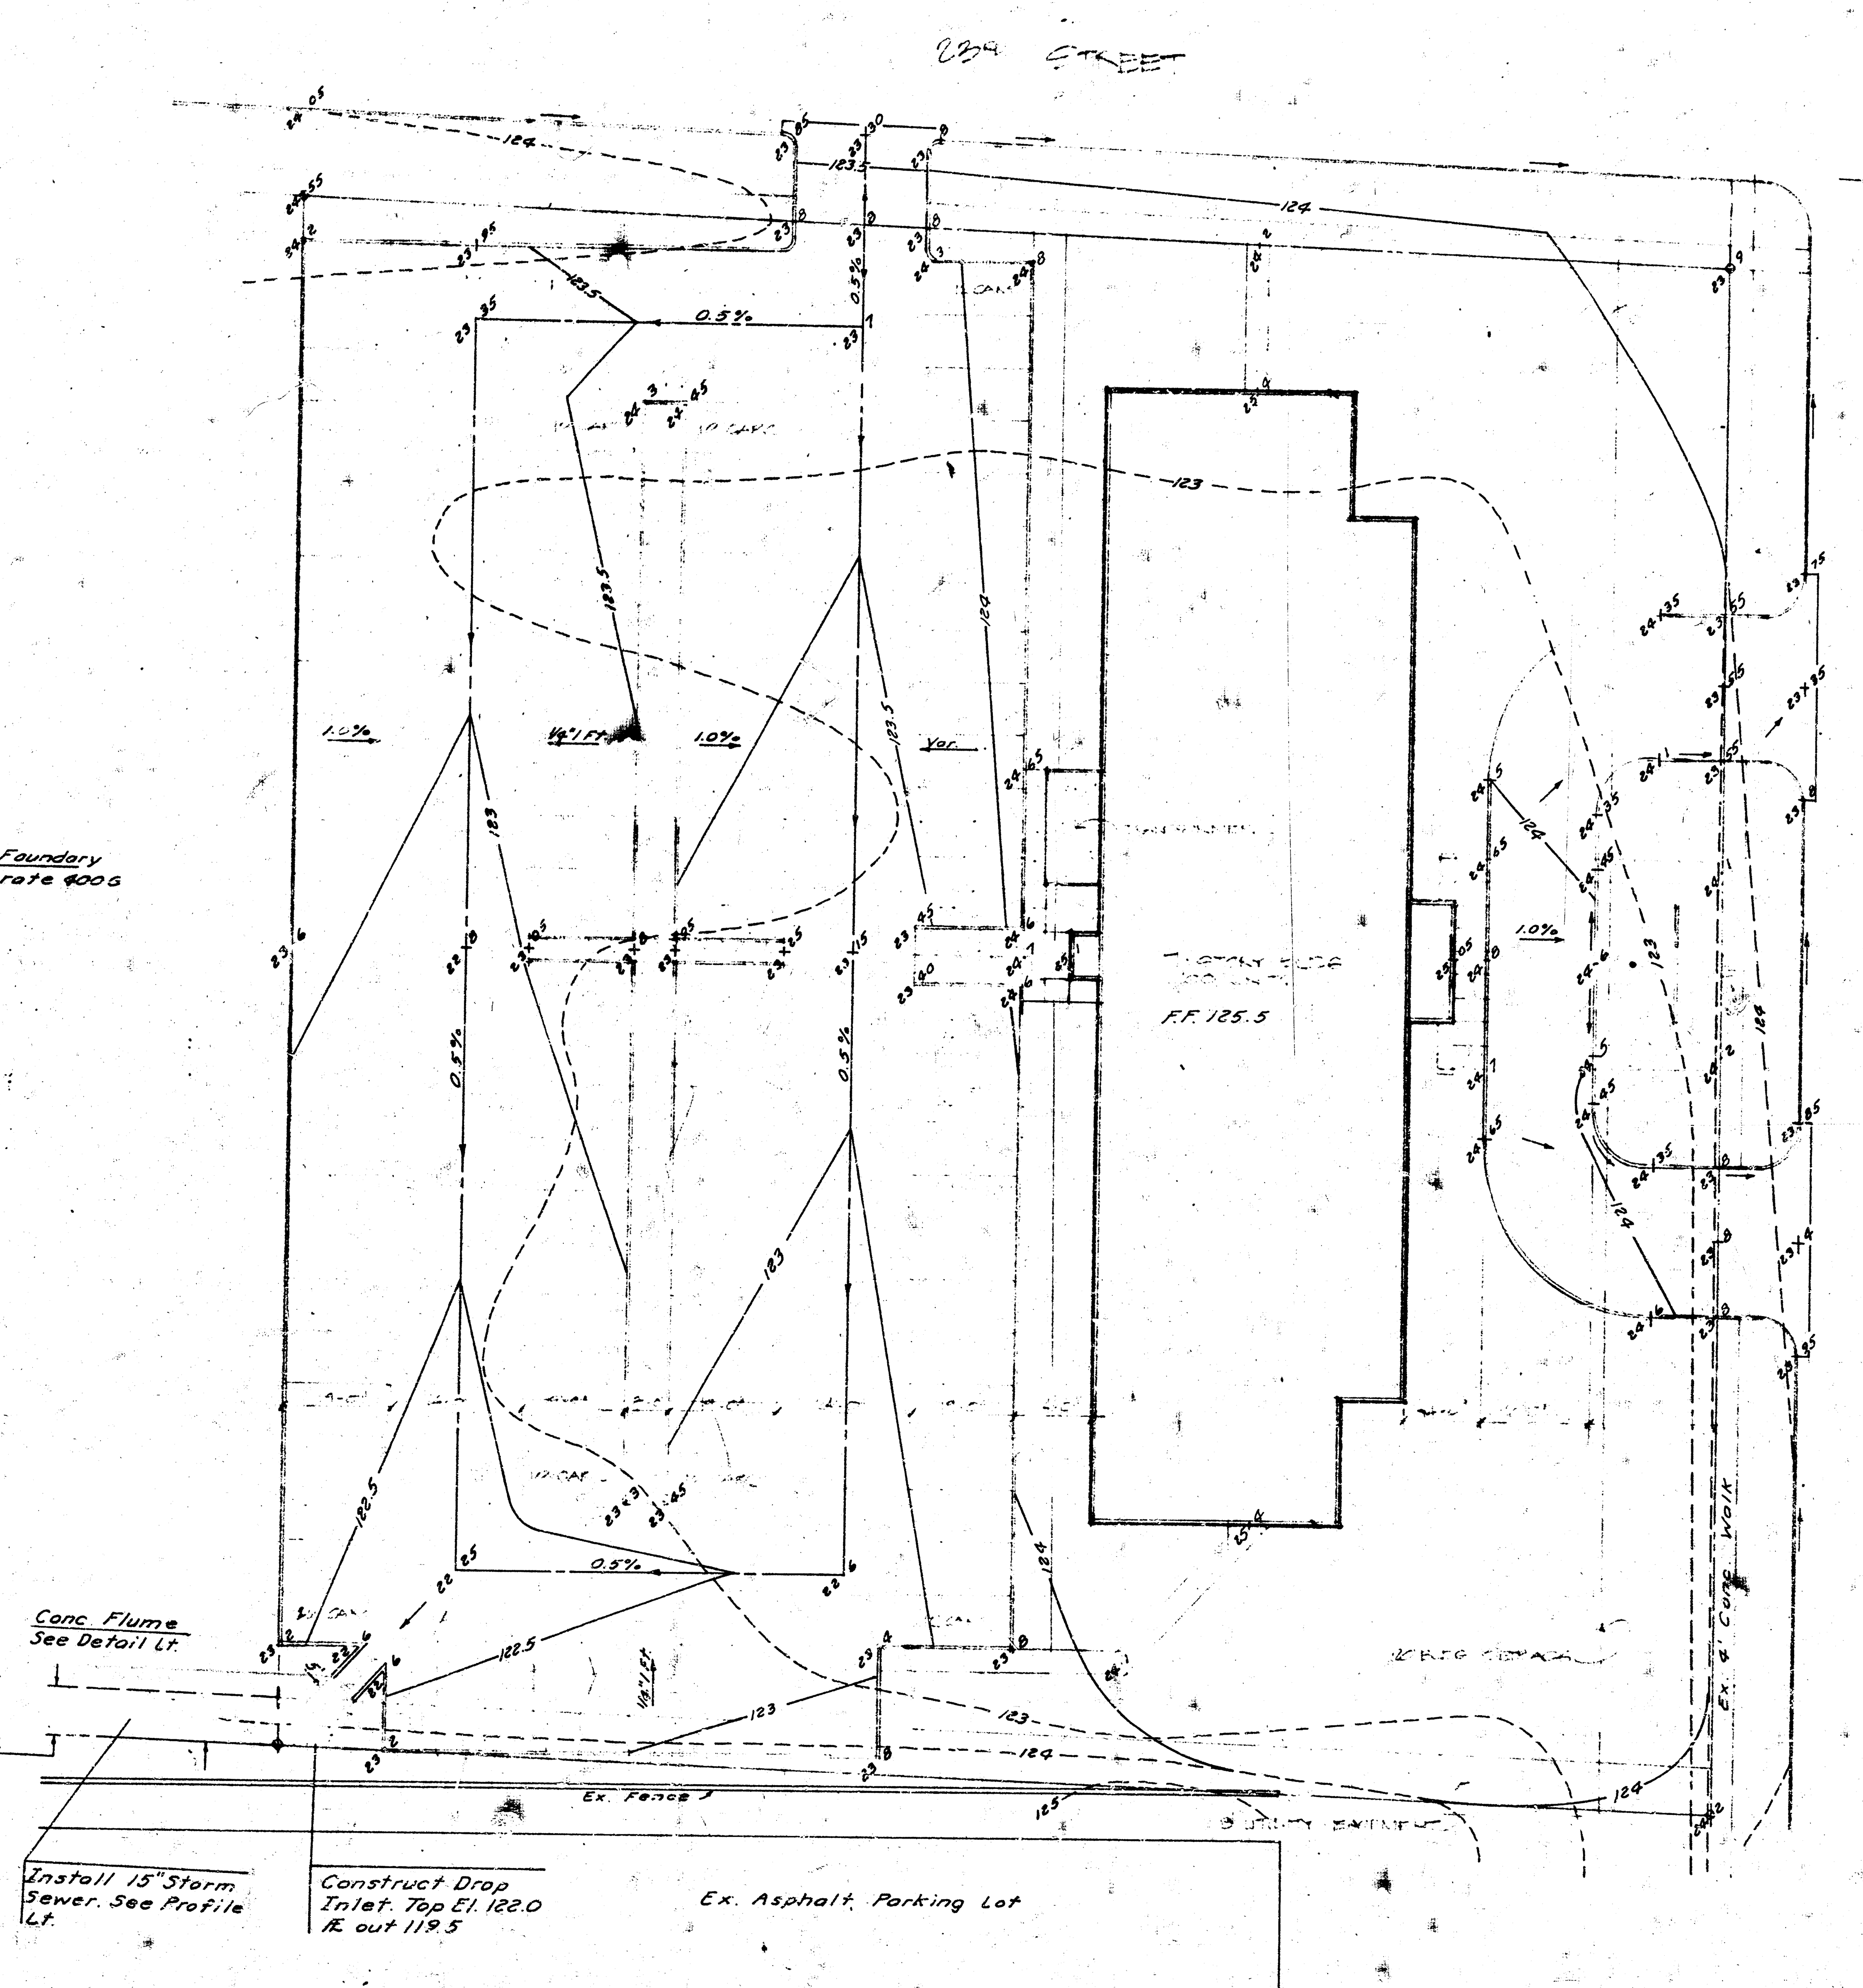


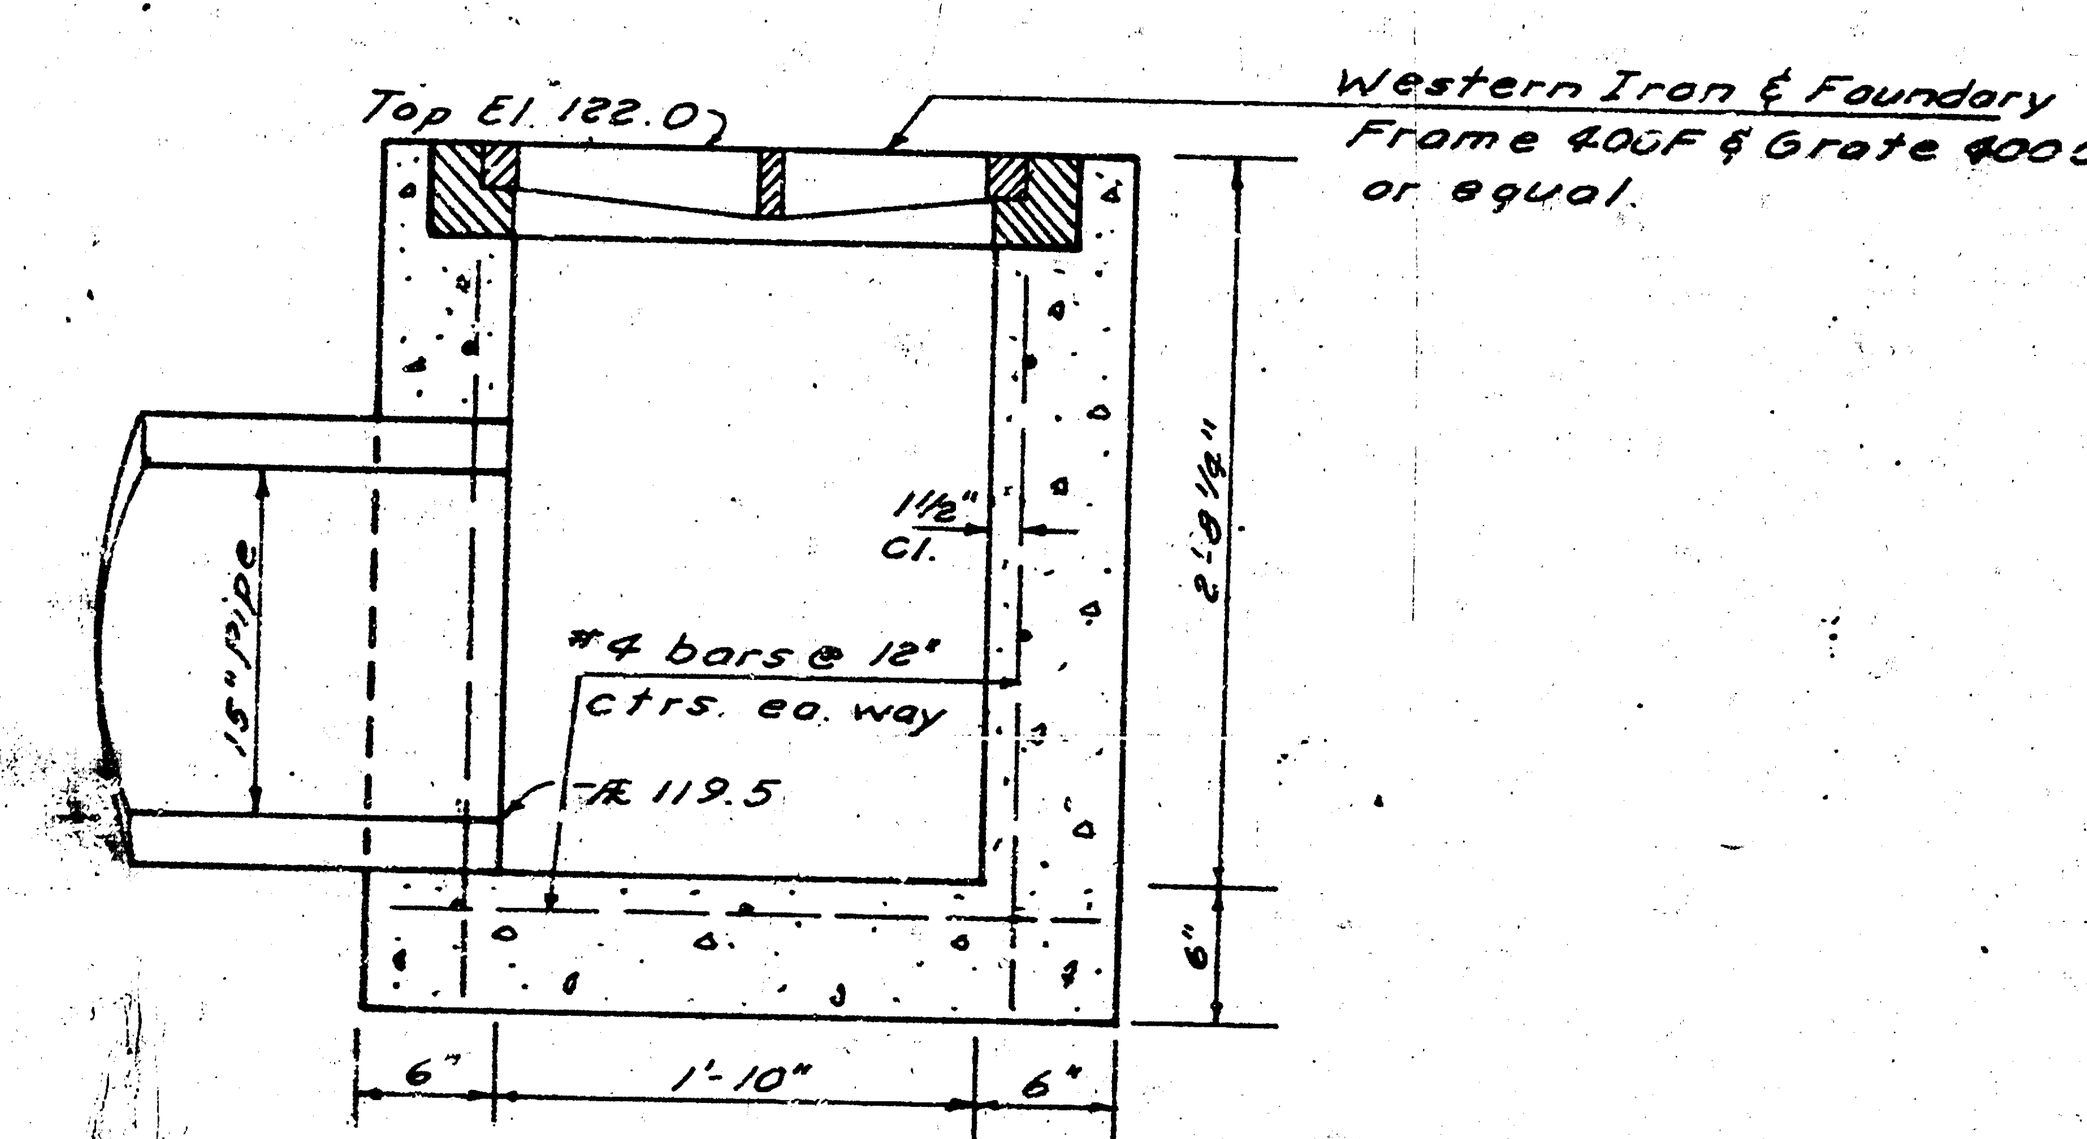

DROP INLET DETAILS

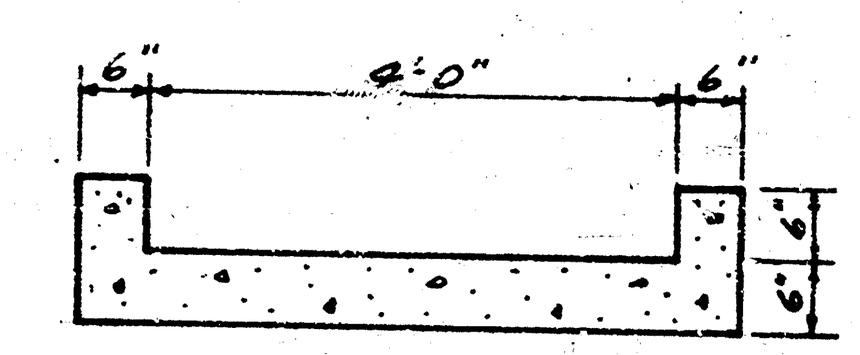

CONC. FLUME DETAIL

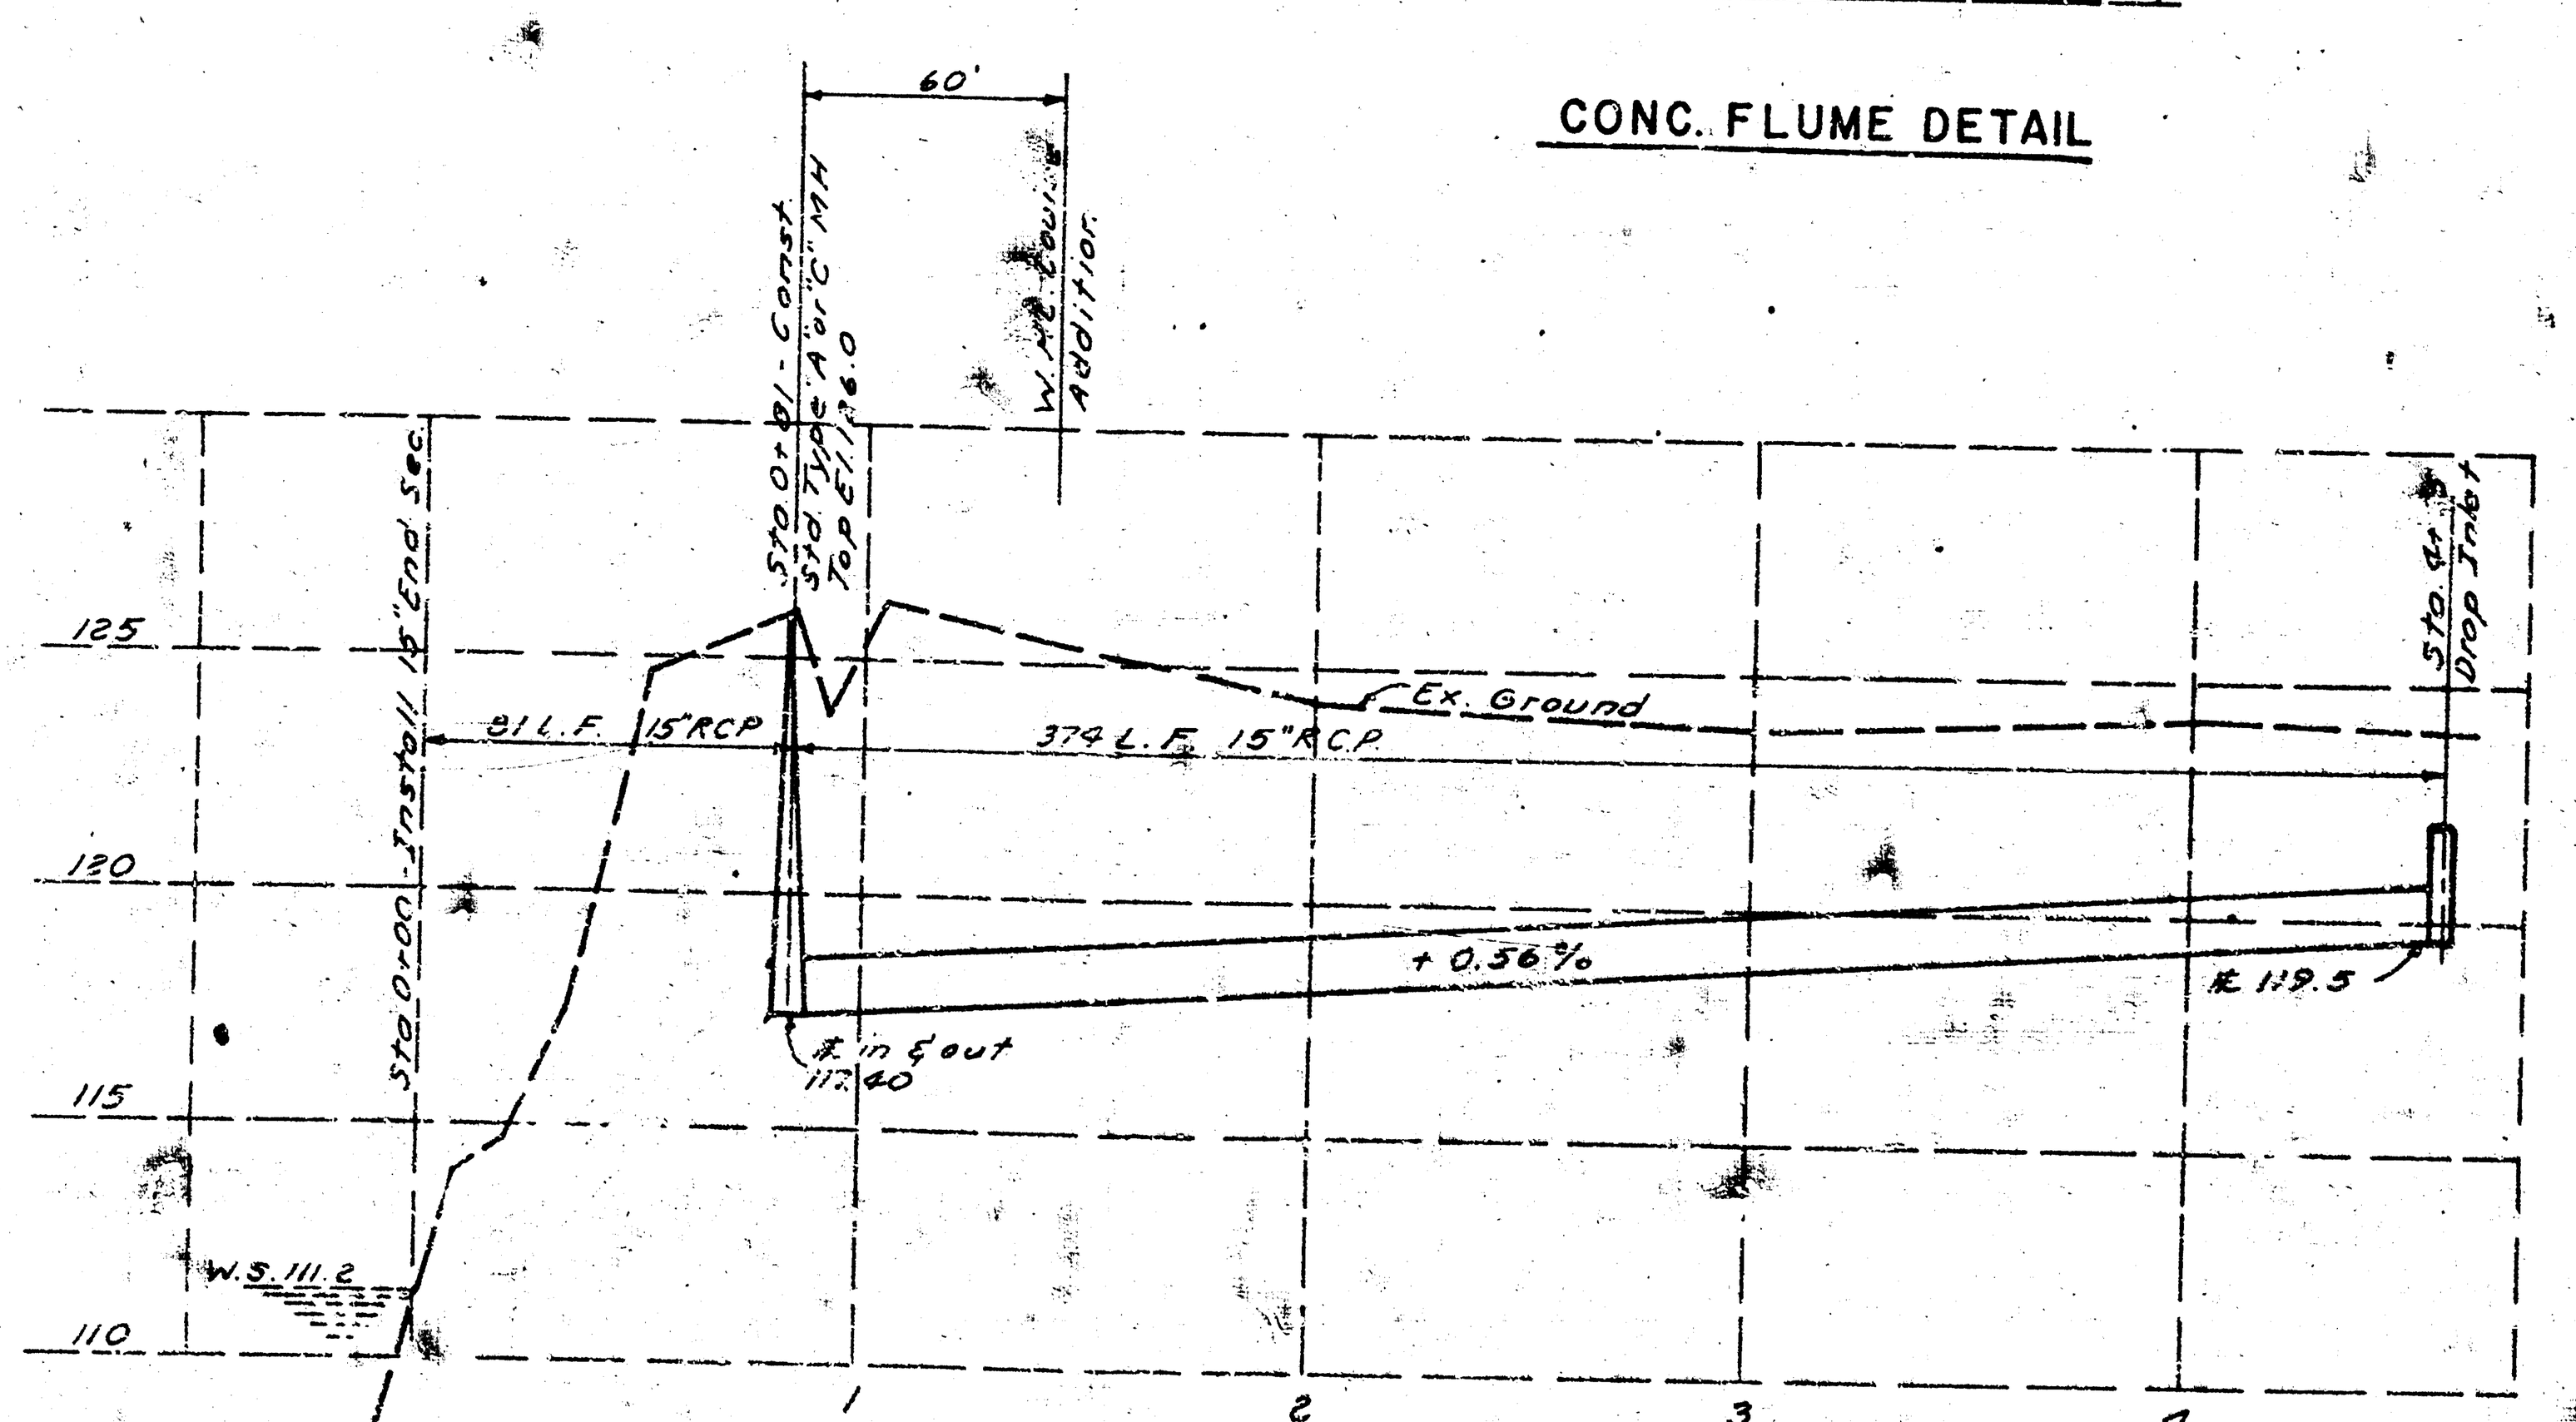

APPROVED AS NOTED

Sanitary Sewers

Storm Sewers — 9/24/78

Drainage Approved

Call George Wilton at 268-4559 for inspection during construction.

NORTH

SITE GRADING PLAN 1"=20'-0"

GENERAL NOTE FOR OVER EXCAVATION FOR FOOTINGS:

OVER EXCAVATION SHOULD COVER ENTIRE BUILDING AREA AND SHOULD EXTEND DOWN UNTIL THE RECOMMENDED BEARING LAYER (SILTY FINE TO MEDIUM SAND) IS ENCOUNTERED. APPROXIMATELY 5' TO 7' IN DEPTH REFER TO SOIL BORING LOGS FOR ACTUAL DATA.

prints issued

revisions 10/10/77 1/11/78

drawn 8/30/77

SOMERSET PLAZA TOWER

sheet SITE GR