
16 5 4 2

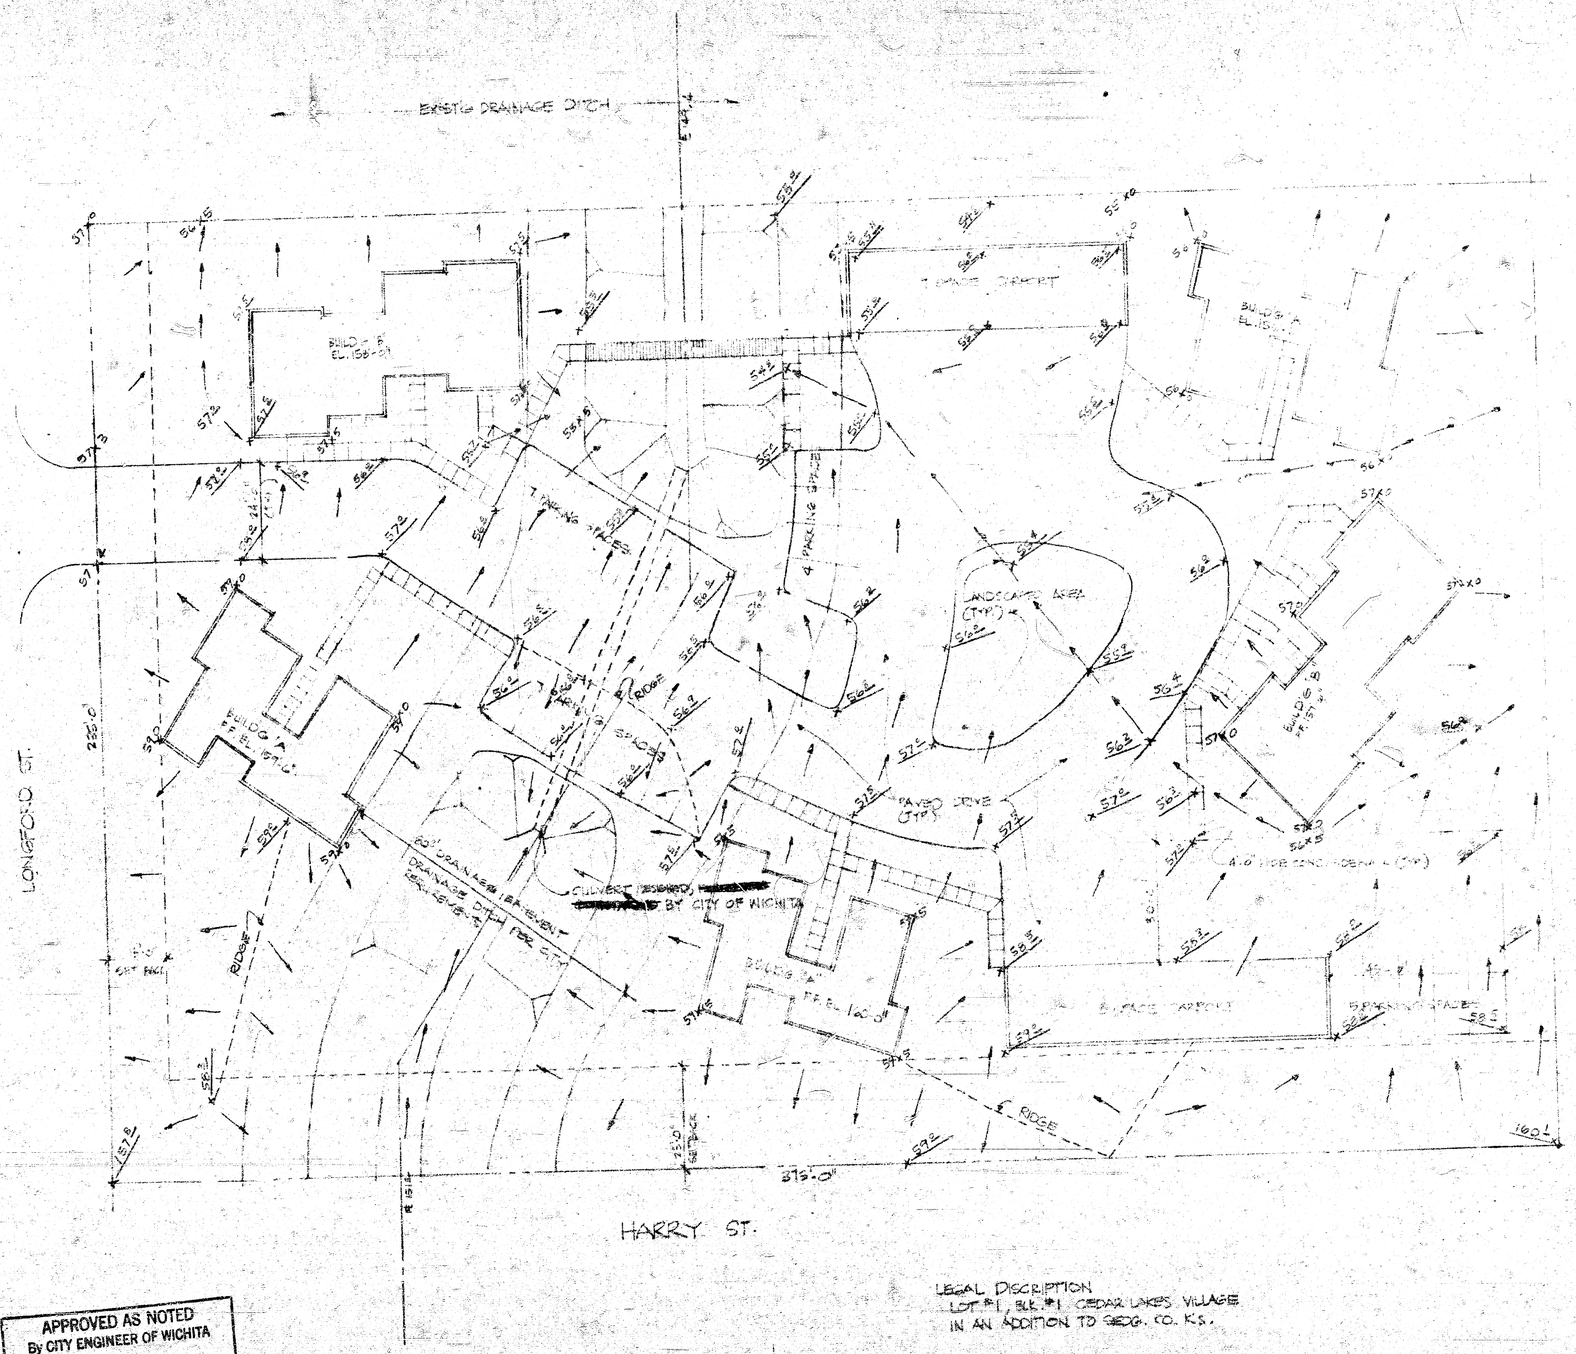

GRADING SITE PLAN
1"=20'-0"

NORTH

LEGAL DISCRIPTION
LOT #1, BLK. #1 CEDAR LAKES VILLAGE
IN AN ADDITION TO SEDG. CO. KS.

NOTE! CONTR. TO VERIFY ALL EXISTG GRADES

APPROVED AS NOTED
By CITY ENGINEER OF WICHITA
Sanitary Sewers _____
Storm Sewers [illegible] 7/5/78
Driveway Approaches _____

NOTE TO CONTRACTOR
This project will be constructed under the supervision of the CITY ENGINEER conforming to the SPECIFICATIONS

Storm Water Drain for Lot 1, Block 1

DATE: 6/26/78 5/8/78 5/17/78 5/31/78

AN APARTMENT COMPLEX
WICHITA, KANSAS