


NOTE: Grates shall be imprinted on the top surface with "CITY OF WICHITA" using letters at least 1" in height. Other marking methods may be used only if approved by the engineer.

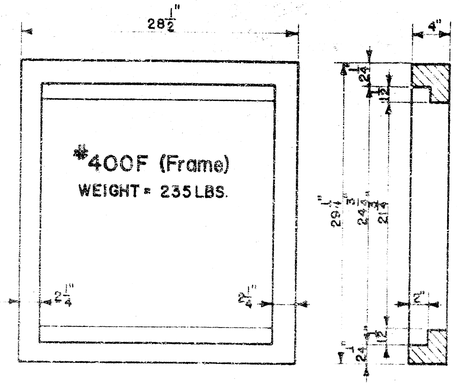


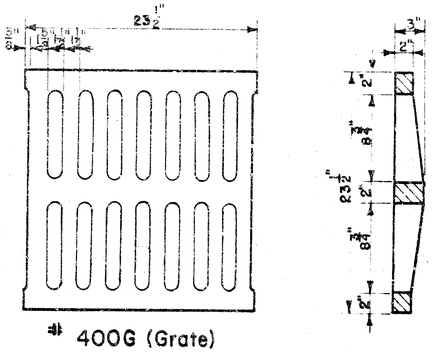


24"x24" Frame & Grate Detail

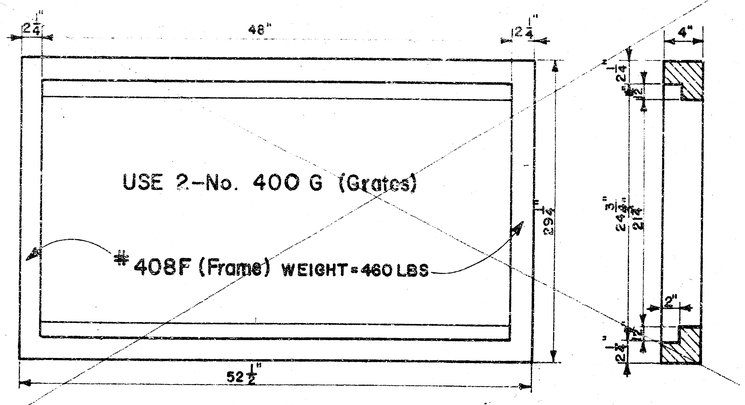


Double 24"x24" Frame Detail

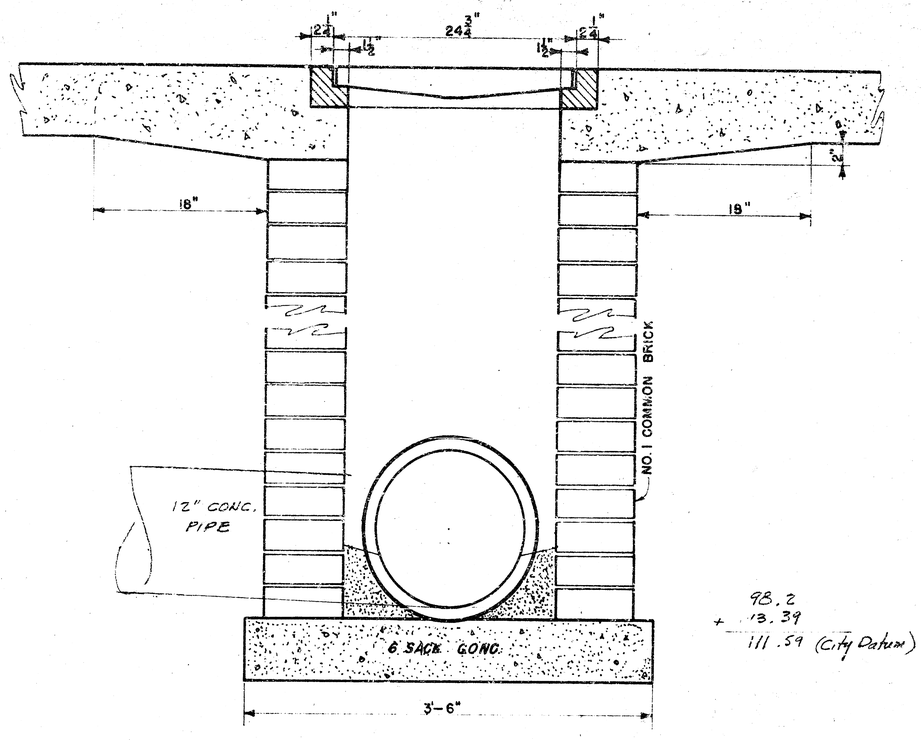

98.2
+ 13.39
111.59 (City Datum)

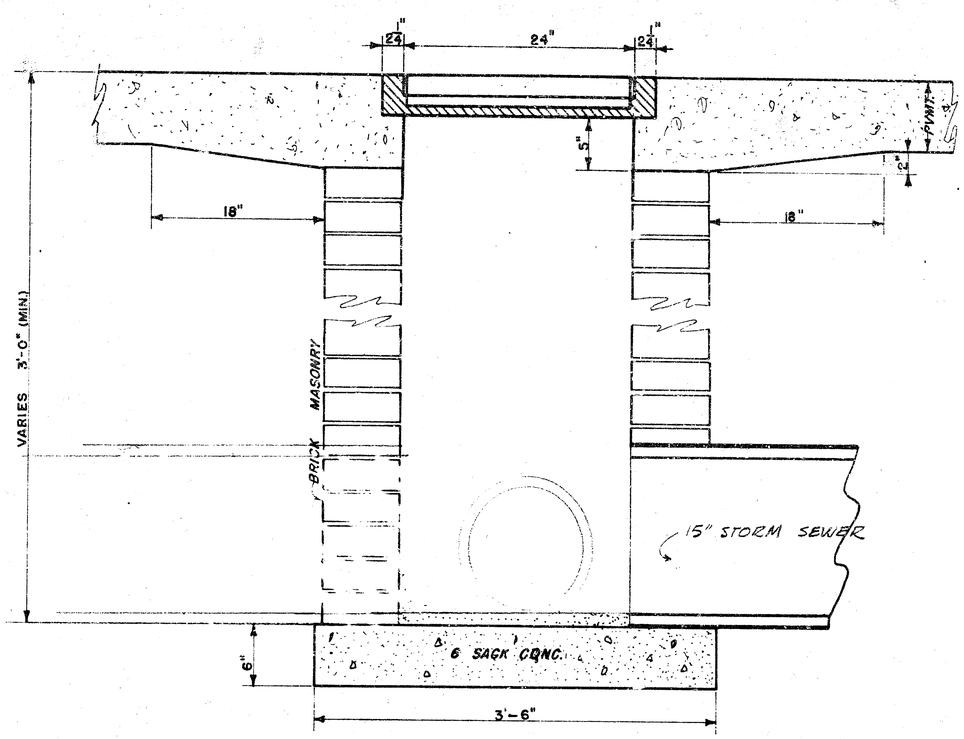

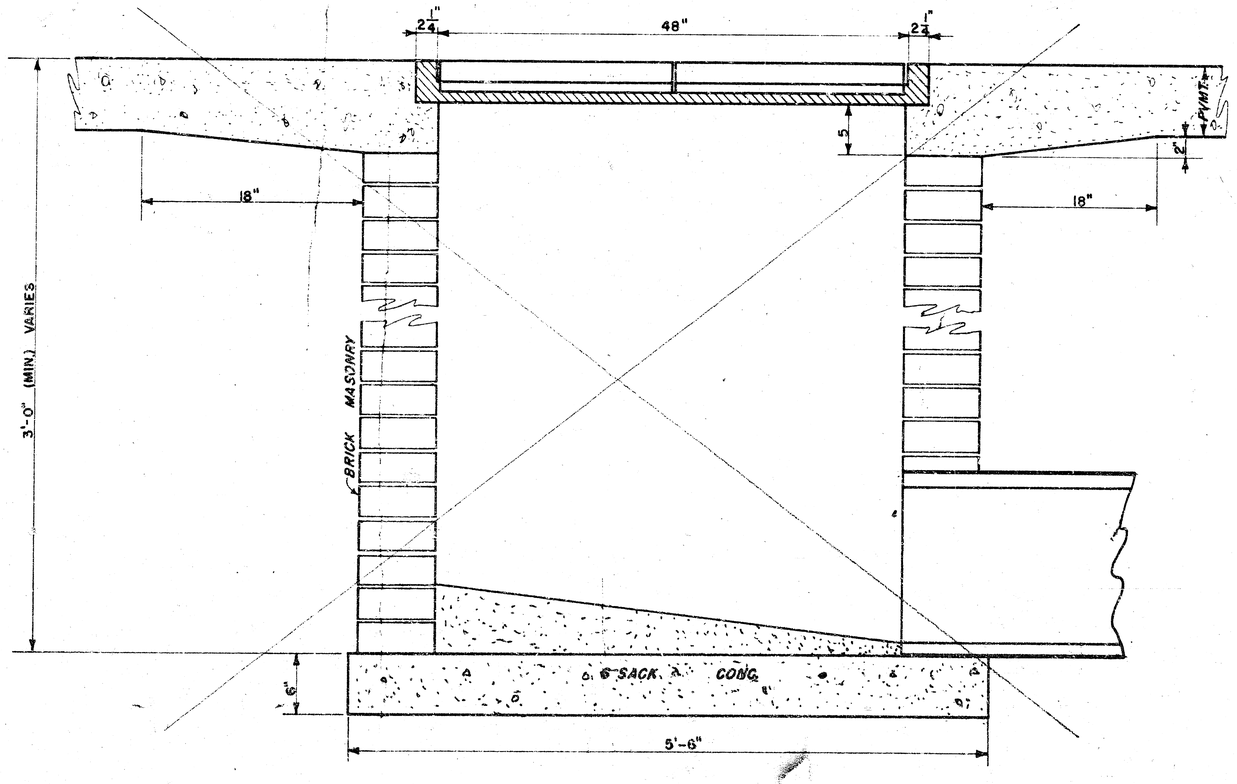

DROP INLET DET

R.W. Linn City Engineer

City of Wichita, Kansas

Project: Courtyard Drainage - St. Hospital

Project No.