



LOCATION MAP

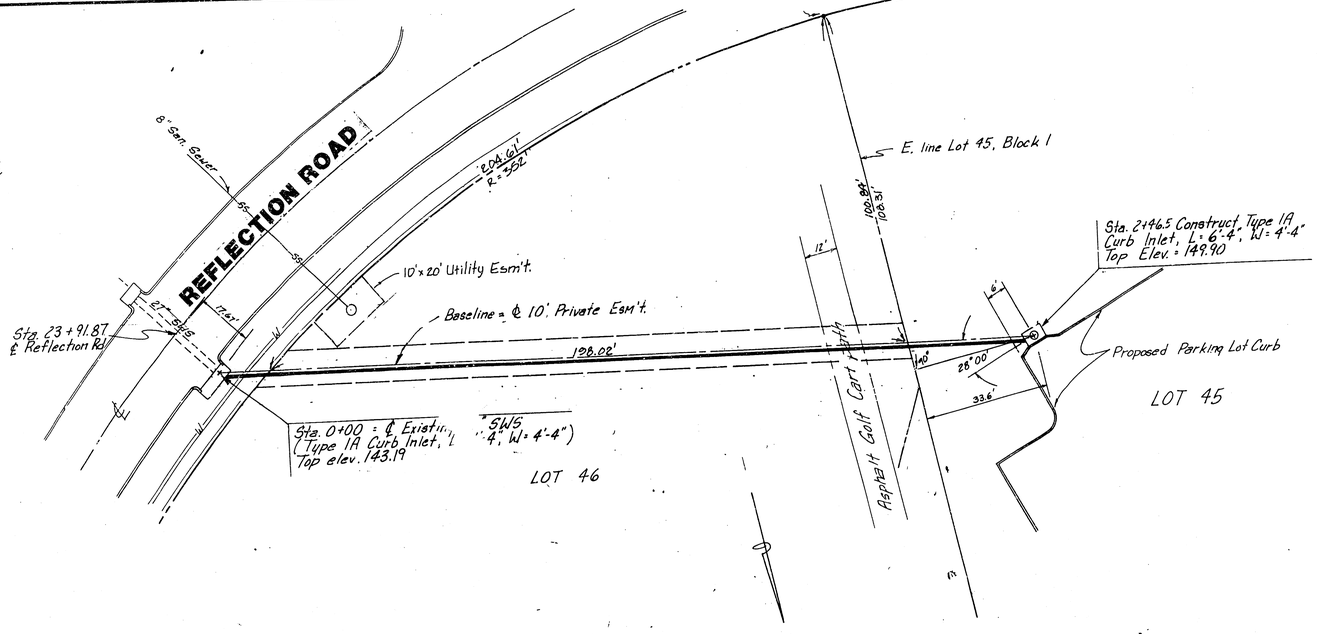

Bench Mark:
Chiseled "I" Cut Top of Curb
West of inlet
Elev. = 143.15

Booked
MCG
D-113

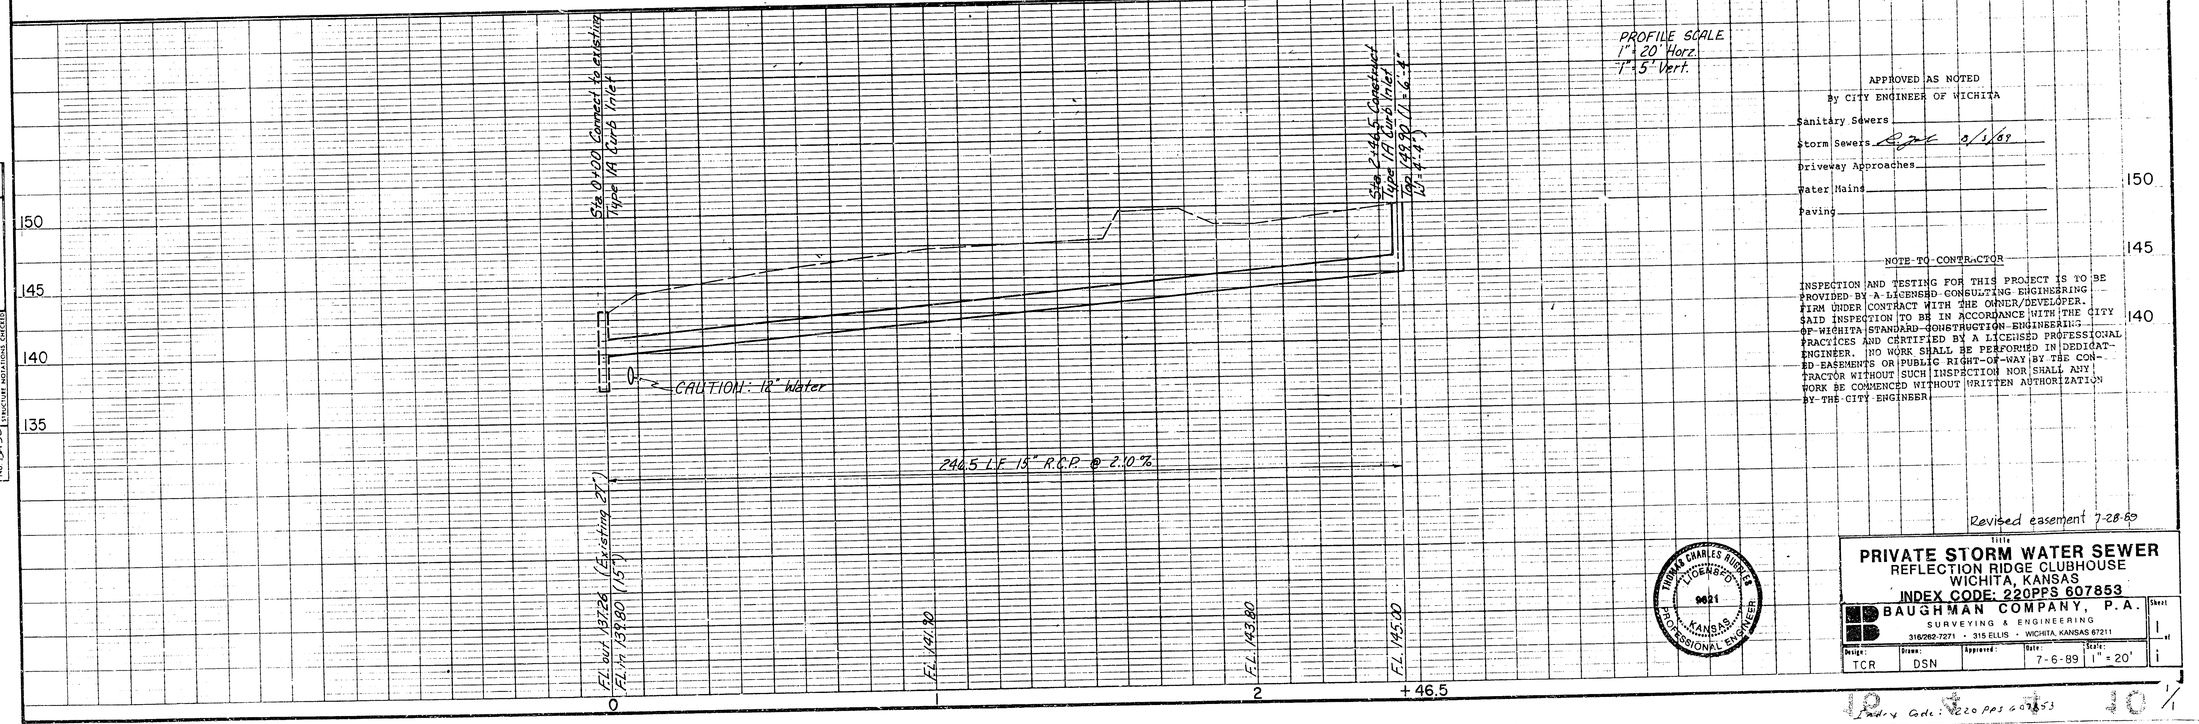

APPROVED AS NOTED
By CITY ENGINEER OF WICHITA

Sanitary Sewers _____

Storm Sewers [signature] 8/3/89

Driveway Approaches _____

Water Mains _____

Paving _____

NOTE TO CONTRACTOR

INSPECTION AND TESTING FOR THIS PROJECT IS TO BE PROVIDED BY A LICENSED CONSULTING ENGINEERING FIRM UNDER CONTRACT WITH THE OWNER/DEVELOPER. SAID INSPECTION TO BE IN ACCORDANCE WITH THE CITY OF WICHITA STANDARD CONSTRUCTION ENGINEERING PRACTICES AND CERTIFIED BY A LICENSED PROFESSIONAL ENGINEER. NO WORK SHALL BE PERFORMED IN DEDICATED EASEMENTS OR PUBLIC RIGHT-OF-WAY BY THE CONTRACTOR WITHOUT SUCH INSPECTION NOR SHALL ANY WORK BE COMMENCED WITHOUT WRITTEN AUTHORIZATION BY THE CITY ENGINEER.

Revised easement 7-28-89

THOMAS CHARLES RUSSELL LICENSED 9021 KANSAS PROFESSIONAL ENGINEER

Title
PRIVATE STORM WATER SEWER
REFLECTION RIDGE CLUBHOUSE
WICHITA, KANSAS
INDEX CODE: 220PPS 607853


BAUGHMAN COMPANY, P.A.
SURVEYING & ENGINEERING
316/262-7271 • 315 ELLIS • WICHITA, KANSAS 67211

Design:	Drawn:	Approved:	Date:	Scale:	Sheet
TCR	DSN		7-6-89	1" = 20'	1 of 1


Index Code: 220 PPS 607853

PLAN — SURVEYED; PLOTTED; NOTE BOOK; No. ____; DRAWING CHECKED; AS-BUILT CHECKED; BY; DATE


PROFILE — SURVEYED; PLOTTED; NOTE BOOK; No. 84 JG; GRADES CHECKED; AS-BUILT NOTED; SPECIFICATIONS CHECKED; BY; DATE

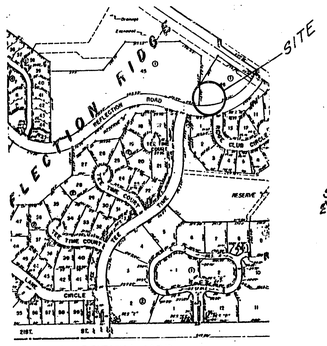

LOCATION MAP

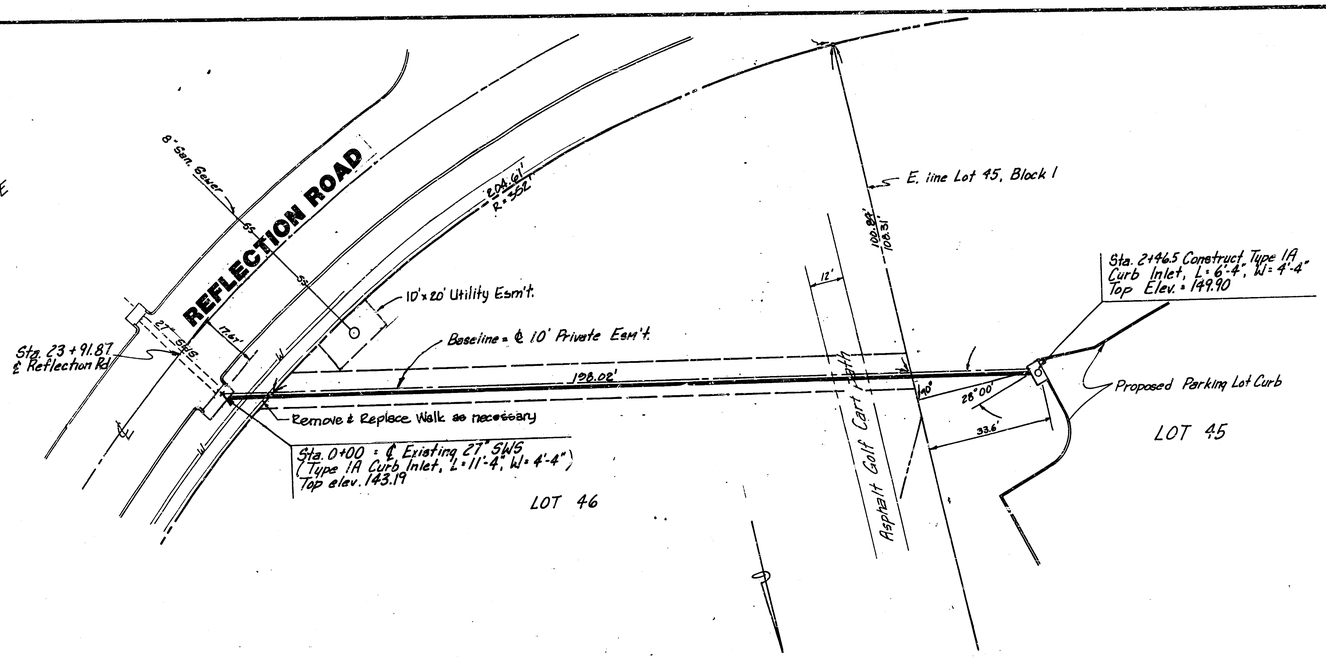

Bench Mark:
Chiseled "X" Cut Top of Curb
West of inlet
Elev. = 143.15

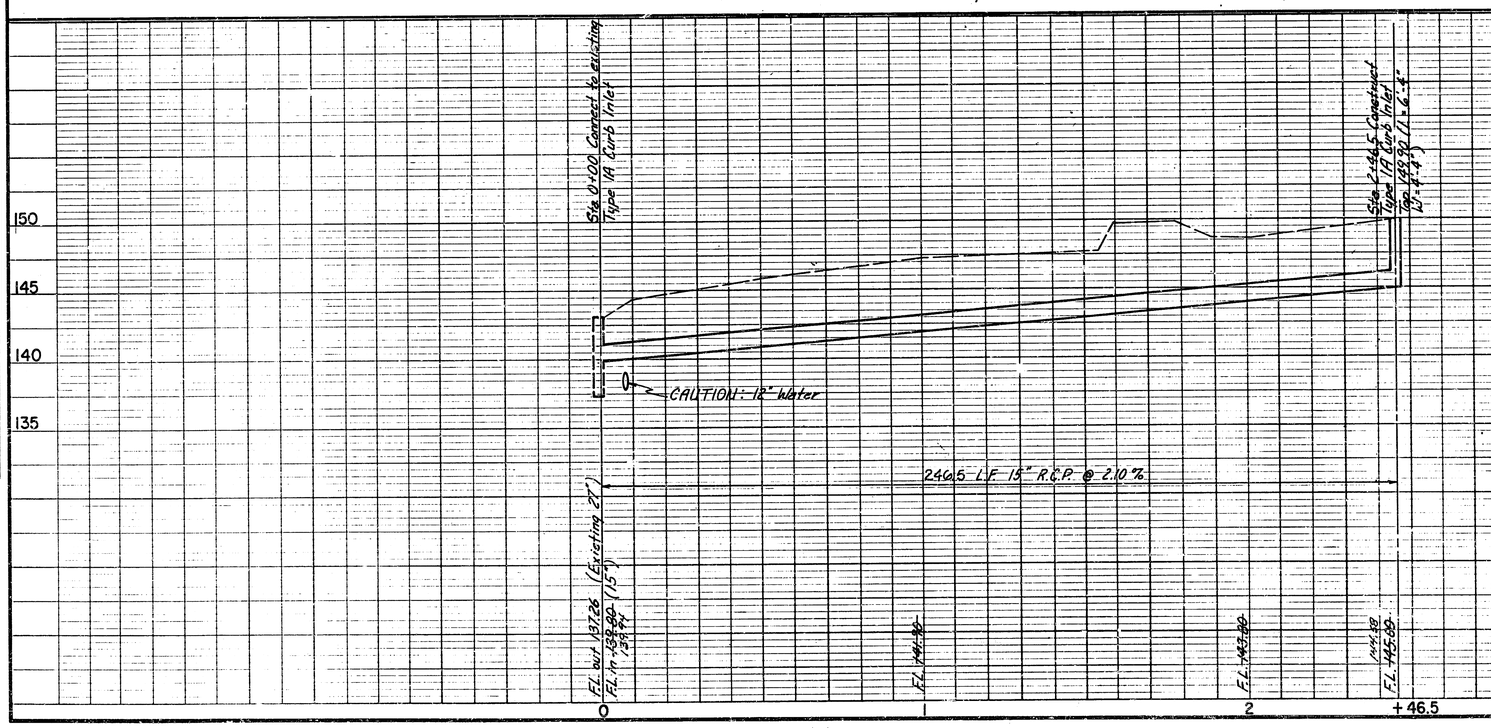

Booked
10-4-89

APPROVED AS NOTED
By CITY ENGINEER OF WICHITA

Sanitary Sewers
Storm Sewers Case 8/1/89
Driveway Approaches
Water Mains
Paving

NOTE TO CONTRACTOR

INSPECTION AND TESTING FOR THIS PROJECT IS TO BE PROVIDED BY A LICENSED CONSULTING ENGINEERING FIRM UNDER CONTRACT WITH THE OWNER/DEVELOPER. SAID INSPECTION TO BE IN ACCORDANCE WITH THE CITY OF WICHITA STANDARD CONSTRUCTION ENGINEERING PRACTICES AND CERTIFIED BY A LICENSED PROFESSIONAL ENGINEER. NO WORK SHALL BE PERFORMED IN DEDICATED EASEMENTS OR PUBLIC RIGHT-OF-WAY BY THE CONTRACTOR WITHOUT SUCH INSPECTION NOR SHALL ANY WORK BE COMMENCED WITHOUT WRITTEN AUTHORIZATION BY THE CITY ENGINEER.

Revised as built 9-25-89
Revised easement 7-28-89

THOMAS CHARLES RUBENSER
LICENSED
9021
KANSAS
PROFESSIONAL ENGINEER

Title
PRIVATE STORM WATER SEWER
REFLECTION RIDGE CLUBHOUSE
WICHITA, KANSAS

BAUGHMAN COMPANY, P.A.
SURVEYING & ENGINEERING
316/262-7271 • 315 ELLIS • WICHITA, KANSAS 67211

Design:	Drawn:	Approved:	Date:	Scale:	Sheet
TCR	DSN		7-6-89	1" = 20'	1 of 1

PLAN
SURVEYED
PLOTTED
NOTE BOOK
No.
ALIGNMENT CHECKED
BY CITY ENGINEER

PROFILE
SURVEYED
PLOTTED
NOTE BOOK 6A-25
No.
GRADES CHECKED
BY CITY ENGINEER
STRUCTURE INDICATIONS CHECKED