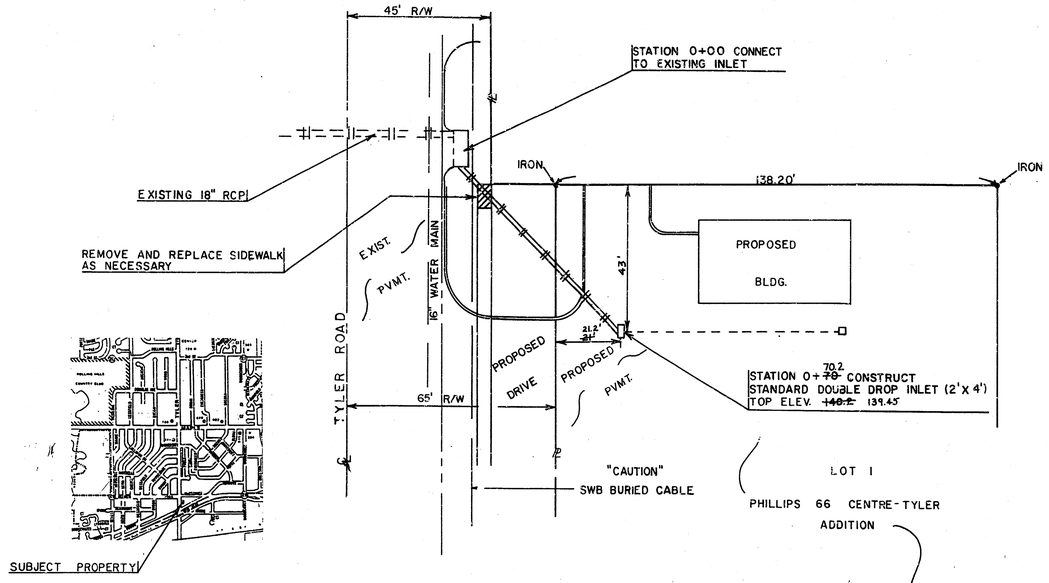


BENCH MARK:
Chiseled square on top of curb east side inlet, north side of Kellogg frontage road on south side of U.S. 54, approx. 330' west of ℄ Tyler.
Elev. = 135.35 City Datum

APPROVED AS NOTED
By CITY ENGINEER OF WICHITA

Sanitary Sewers _____

Storm Sewers VRH 3/8/91

Driveway Approaches _____

Water Mains _____


Paving _____

NOTE TO CONTRACTOR

INSPECTION AND TESTING FOR THIS PROJECT IS TO BE PROVIDED BY A LICENSED CONSULTING ENGINEERING FIRM UNDER CONTRACT WITH THE OWNER/DEVELOPER. SAID INSPECTION TO BE IN ACCORDANCE WITH THE CITY OF WICHITA STANDARD CONSTRUCTION ENGINEERING PRACTICES AND CERTIFIED BY A LICENSED PROFESSIONAL ENGINEER. NO WORK SHALL BE PERFORMED IN DEDICATED EASEMENTS OR PUBLIC RIGHT-OF-WAY BY THE CONTRACTOR WITHOUT SUCH INSPECTION NOR SHALL ANY WORK BE COMMENCED WITHOUT WRITTEN AUTHORIZATION BY THE CITY ENGINEER.

Scale: 1"= 20' PLAN
1"= 5' PROFILE
o = IRON

PLAN
SURVEYED
PLOTTED
ALIGNMENT CHECKED
R. W.'s NOTED
STRUCTURE NOTATIONS CHECKED
NOTE BOOK
No.
DATE
BY

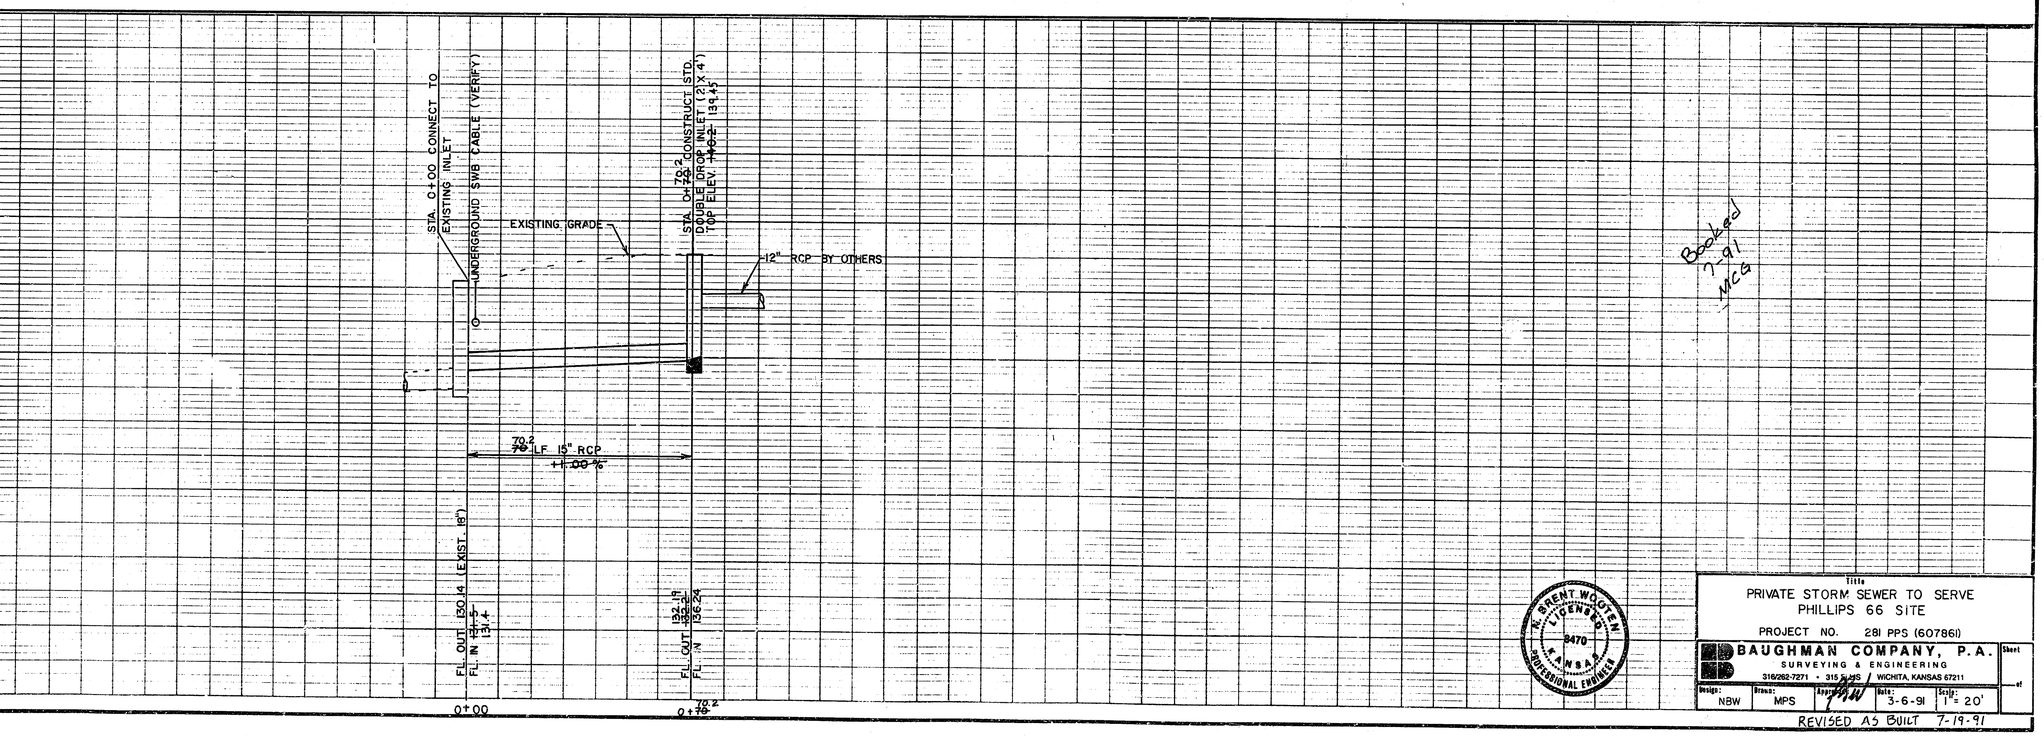

PROFILE
SURVEYED
PLOTTED
ALIGNMENT CHECKED
R. W.'s NOTED
STRUCTURE NOTATIONS CHECKED
NOTE BOOK
No.
DATE
BY

Booked 7-91 MCS

Title
PRIVATE STORM SEWER TO SERVE PHILLIPS 66 SITE

PROJECT NO. 281 PPS (607861)

BAUGHMAN COMPANY, P.A.
SURVEYING & ENGINEERING
316/262-7271 • 315 S. 19TH / WICHITA, KANSAS 67211

Design: NBW | Drawn: MPS | Approved: [illegible] | Date: 3-6-91 | Scale: 1"= 20' | Sheet of

REVISED AS BUILT 7-19-91

R. BRENT WOOTEN LICENSED 8470 KANSAS PROFESSIONAL ENGINEER

FILMED FROM THE BEST AVAILABLE COPY