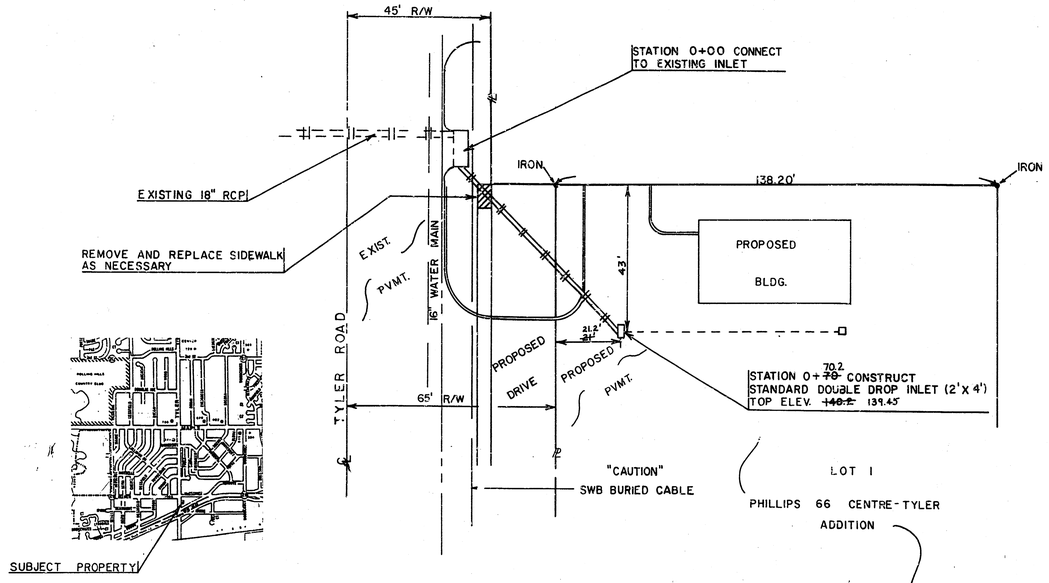


BENCH MARK:
Chiseled square on top of curb east side inlet, north side of Kellogg frontage road on south side of U.S. 54, approx. 330' west of ℄ Tyler.
Elev. = 135.35 City Datum

APPROVED AS NOTED
By CITY ENGINEER OF WICHITA

Sanitary Sewers _____
Storm Sewers VRH 3/8/91
Driveway Approaches _____
Water Mains _____
Paving _____

NOTE TO CONTRACTOR

INSPECTION AND TESTING FOR THIS PROJECT IS TO BE PROVIDED BY A LICENSED CONSULTING ENGINEERING FIRM UNDER CONTRACT WITH THE OWNER/DEVELOPER. SAID INSPECTION TO BE IN ACCORDANCE WITH THE CITY OF WICHITA STANDARD CONSTRUCTION ENGINEERING PRACTICES AND CERTIFIED BY A LICENSED PROFESSIONAL ENGINEER. NO WORK SHALL BE PERFORMED IN DEDICATED EASEMENTS OR PUBLIC RIGHT-OF-WAY BY THE CONTRACTOR WITHOUT SUCH INSPECTION NOR SHALL ANY WORK BE COMMENCED WITHOUT WRITTEN AUTHORIZATION BY THE CITY ENGINEER.

Scale: 1"= 20' PLAN
1"= 5' PROFILE
o = IRON

PLAN
SURVEYED
PLOTTED
ALIGNMENT CHECKED
R. W.'s NOTED
STRUCTURE NOTATIONS CHECKED
NOTE BOOK
No.
DATE
BY




Booked 7-91 MCG

Title
PRIVATE STORM SEWER TO SERVE PHILLIPS 66 SITE

PROJECT NO. 281 PPS (607861)

BAUGHMAN COMPANY, P.A.
SURVEYING & ENGINEERING
316/262-7271 • 315 S. 19TH / WICHITA, KANSAS 67211

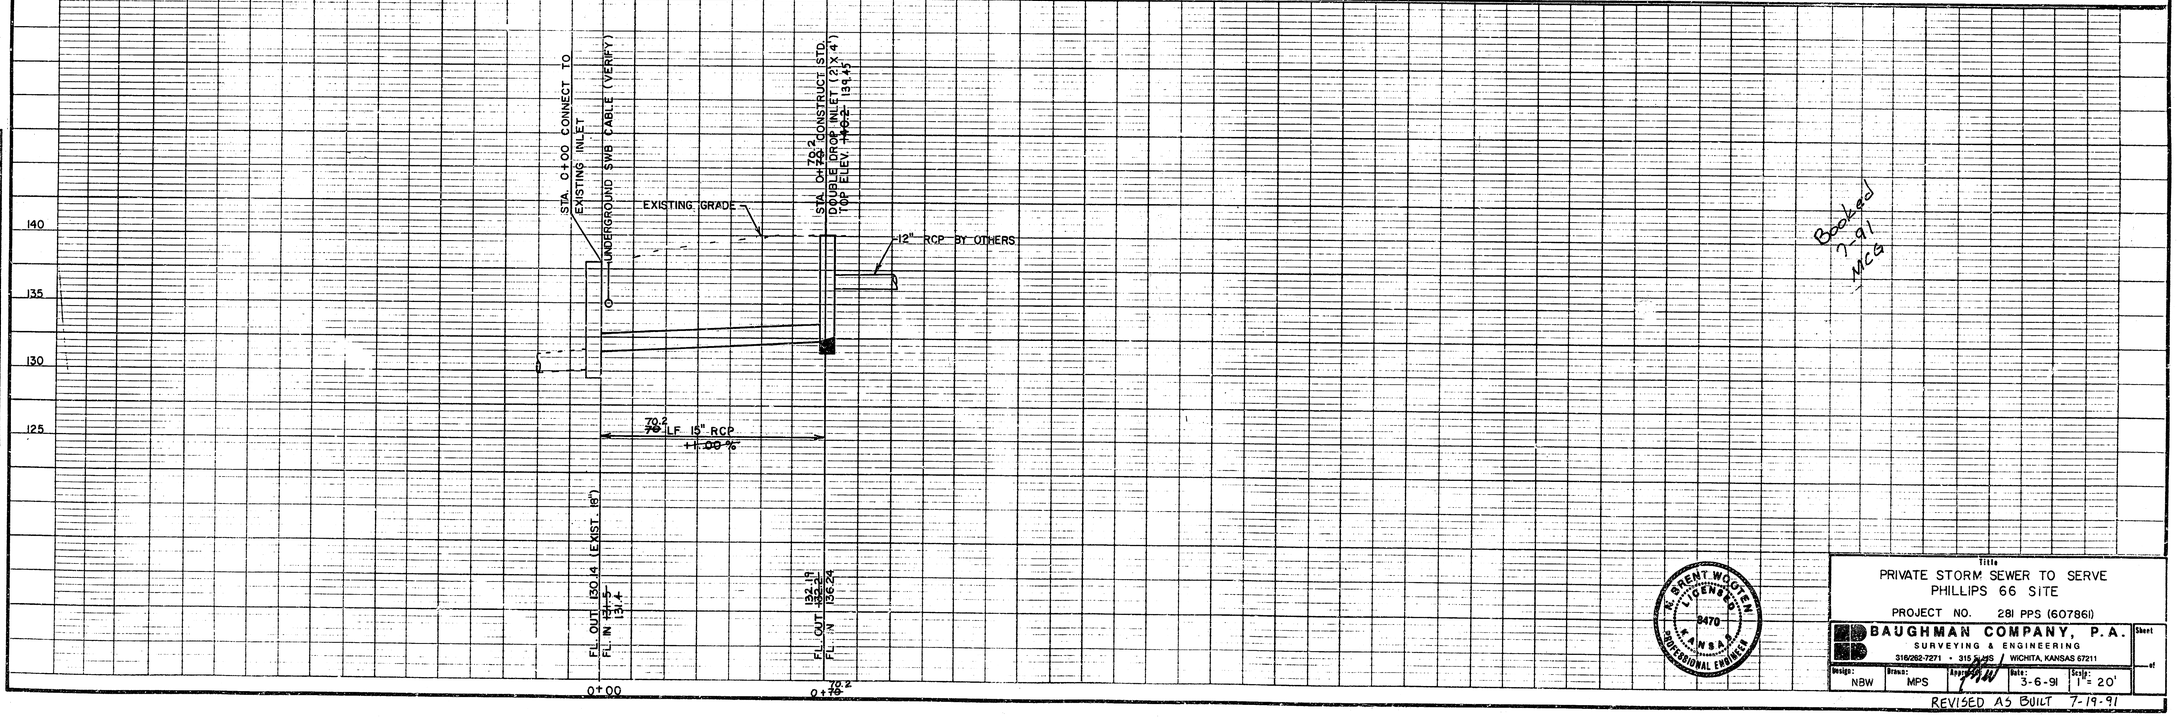Design: NBW | Drawn: MPS | Approved: [illegible] | Date: 3-6-91 | Scale: 1"= 20'

Sheet of

REVISED AS BUILT 7-19-91

W. BRENT WOOTEN LICENSED 8470 KANSAS PROFESSIONAL ENGINEER

FILMED FROM THE BEST AVAILABLE COPY