



Note:
 Manholes to be Constructed to
 City of Wichita Standards.
 Type A 4' Dia.
 Inlets to be Constructed to
 City of Wichita Standards.
 Double Drop Inlet (2'14")

NOTE TO CONTRACTOR
 This project was prepared by
 HKS, Inc. under contract to
 the City of Wichita, Kansas.
 The City of Wichita, Kansas
 is not responsible for the
 accuracy of the information
 presented herein.

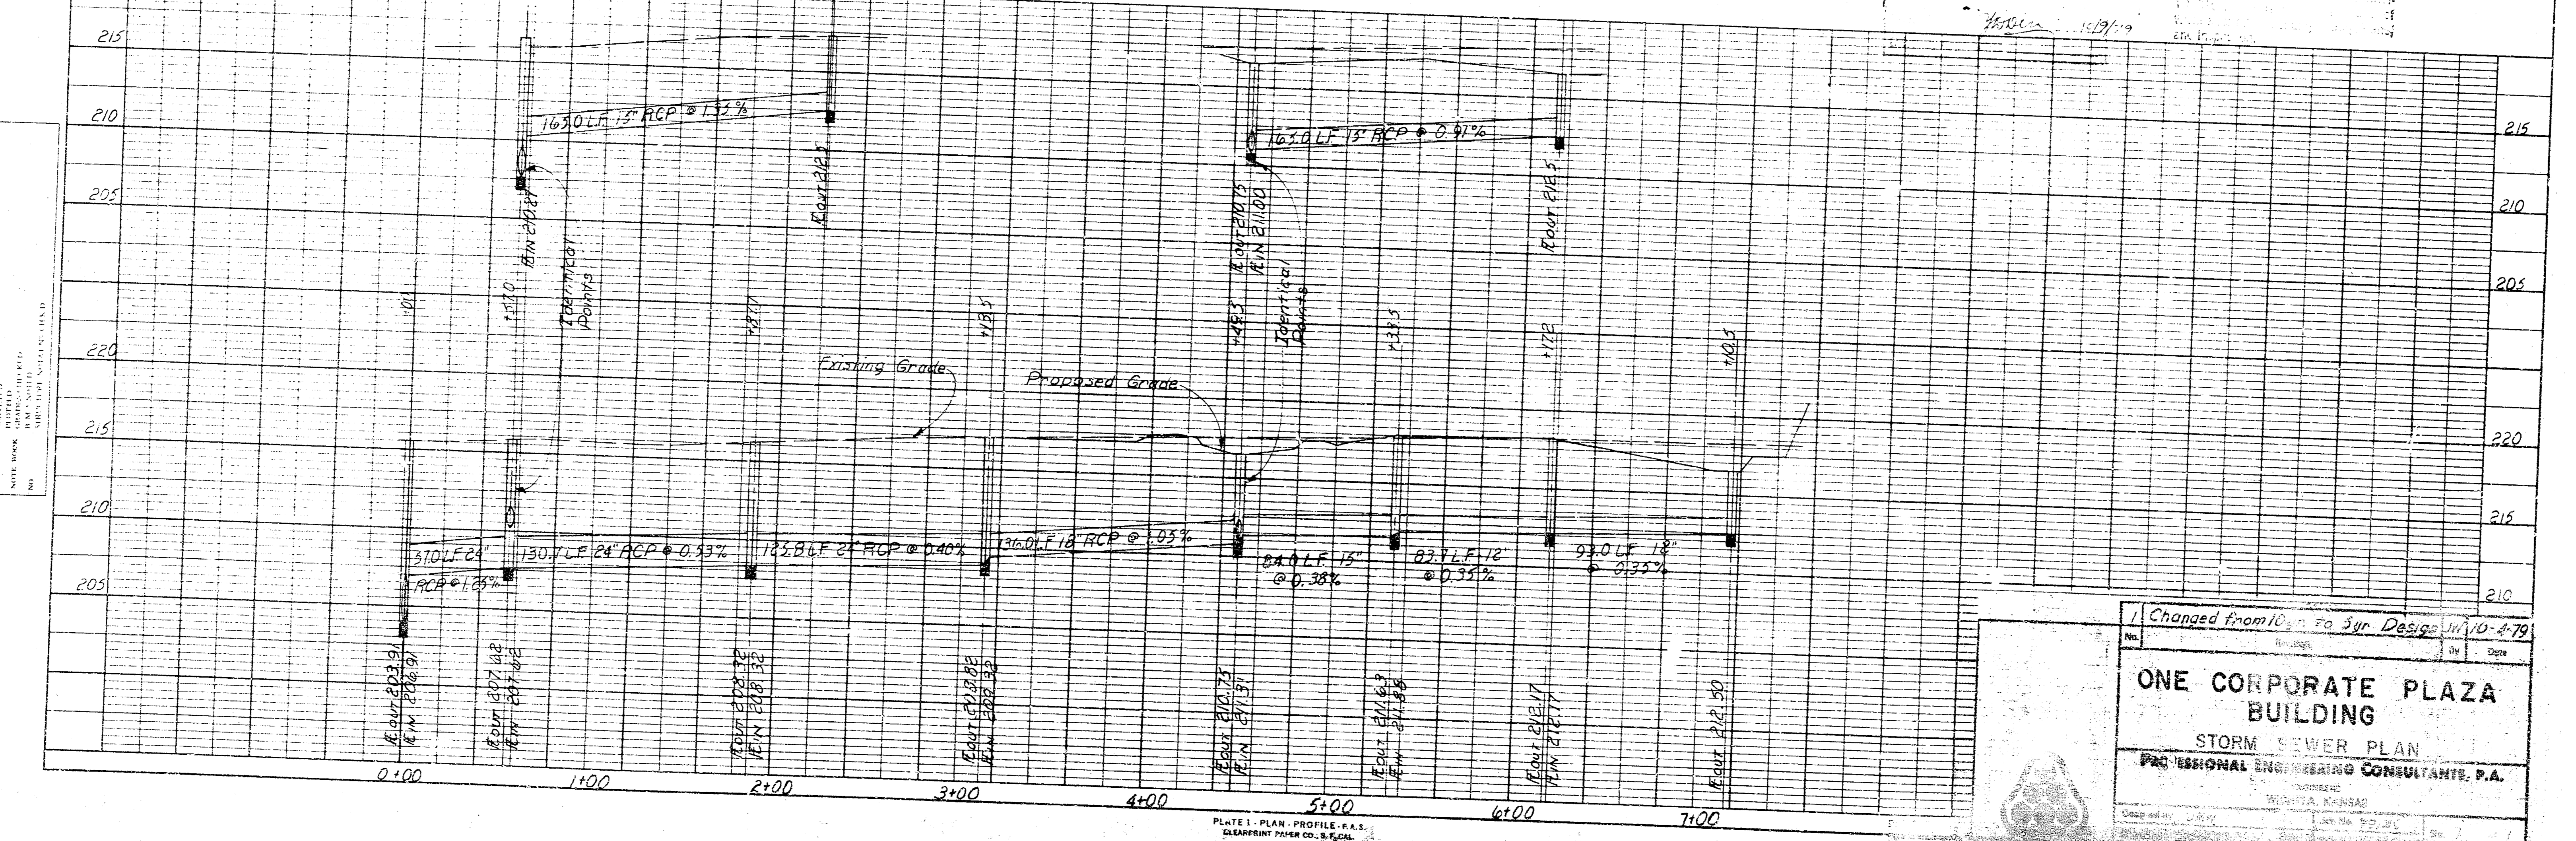

Changed from 10" to 30" Design 11/10/79
 No. _____ Date _____
**ONE CORPORATE PLAZA
 BUILDING**
 STORM SEWER PLAN
 PROFESSIONAL ENGINEERING CONSULTANTS, P.A.
 WICHITA, KANSAS

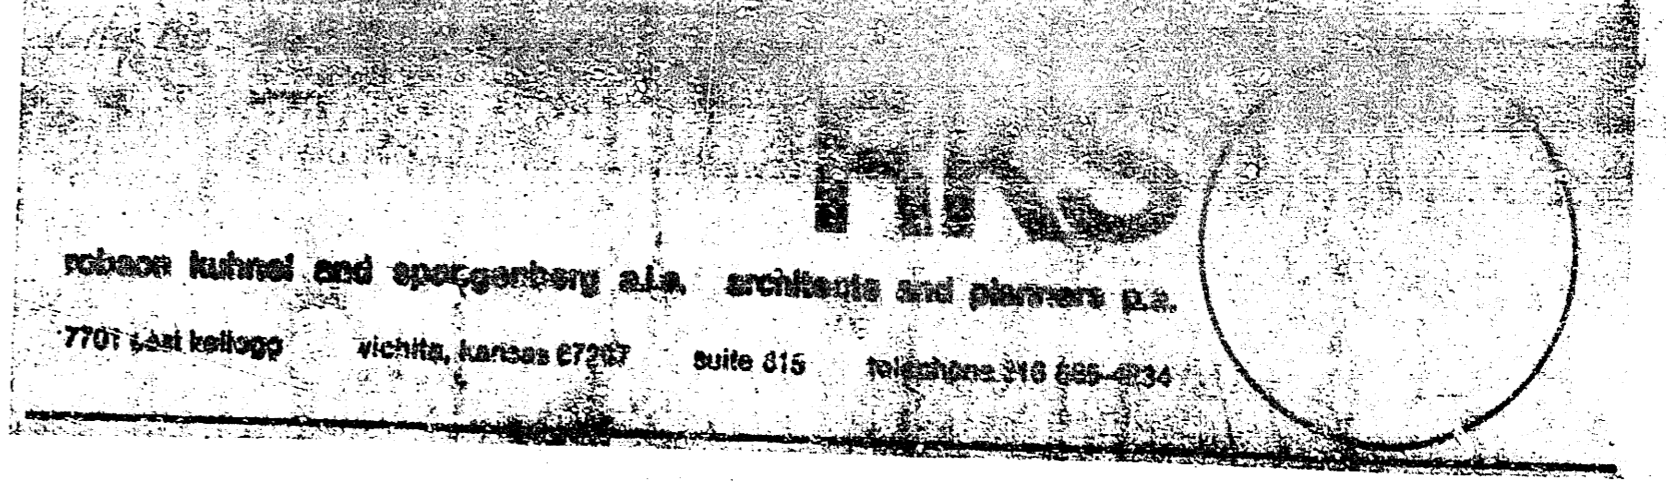

AVAILABLE COPY... FILMED FROM THE BEST