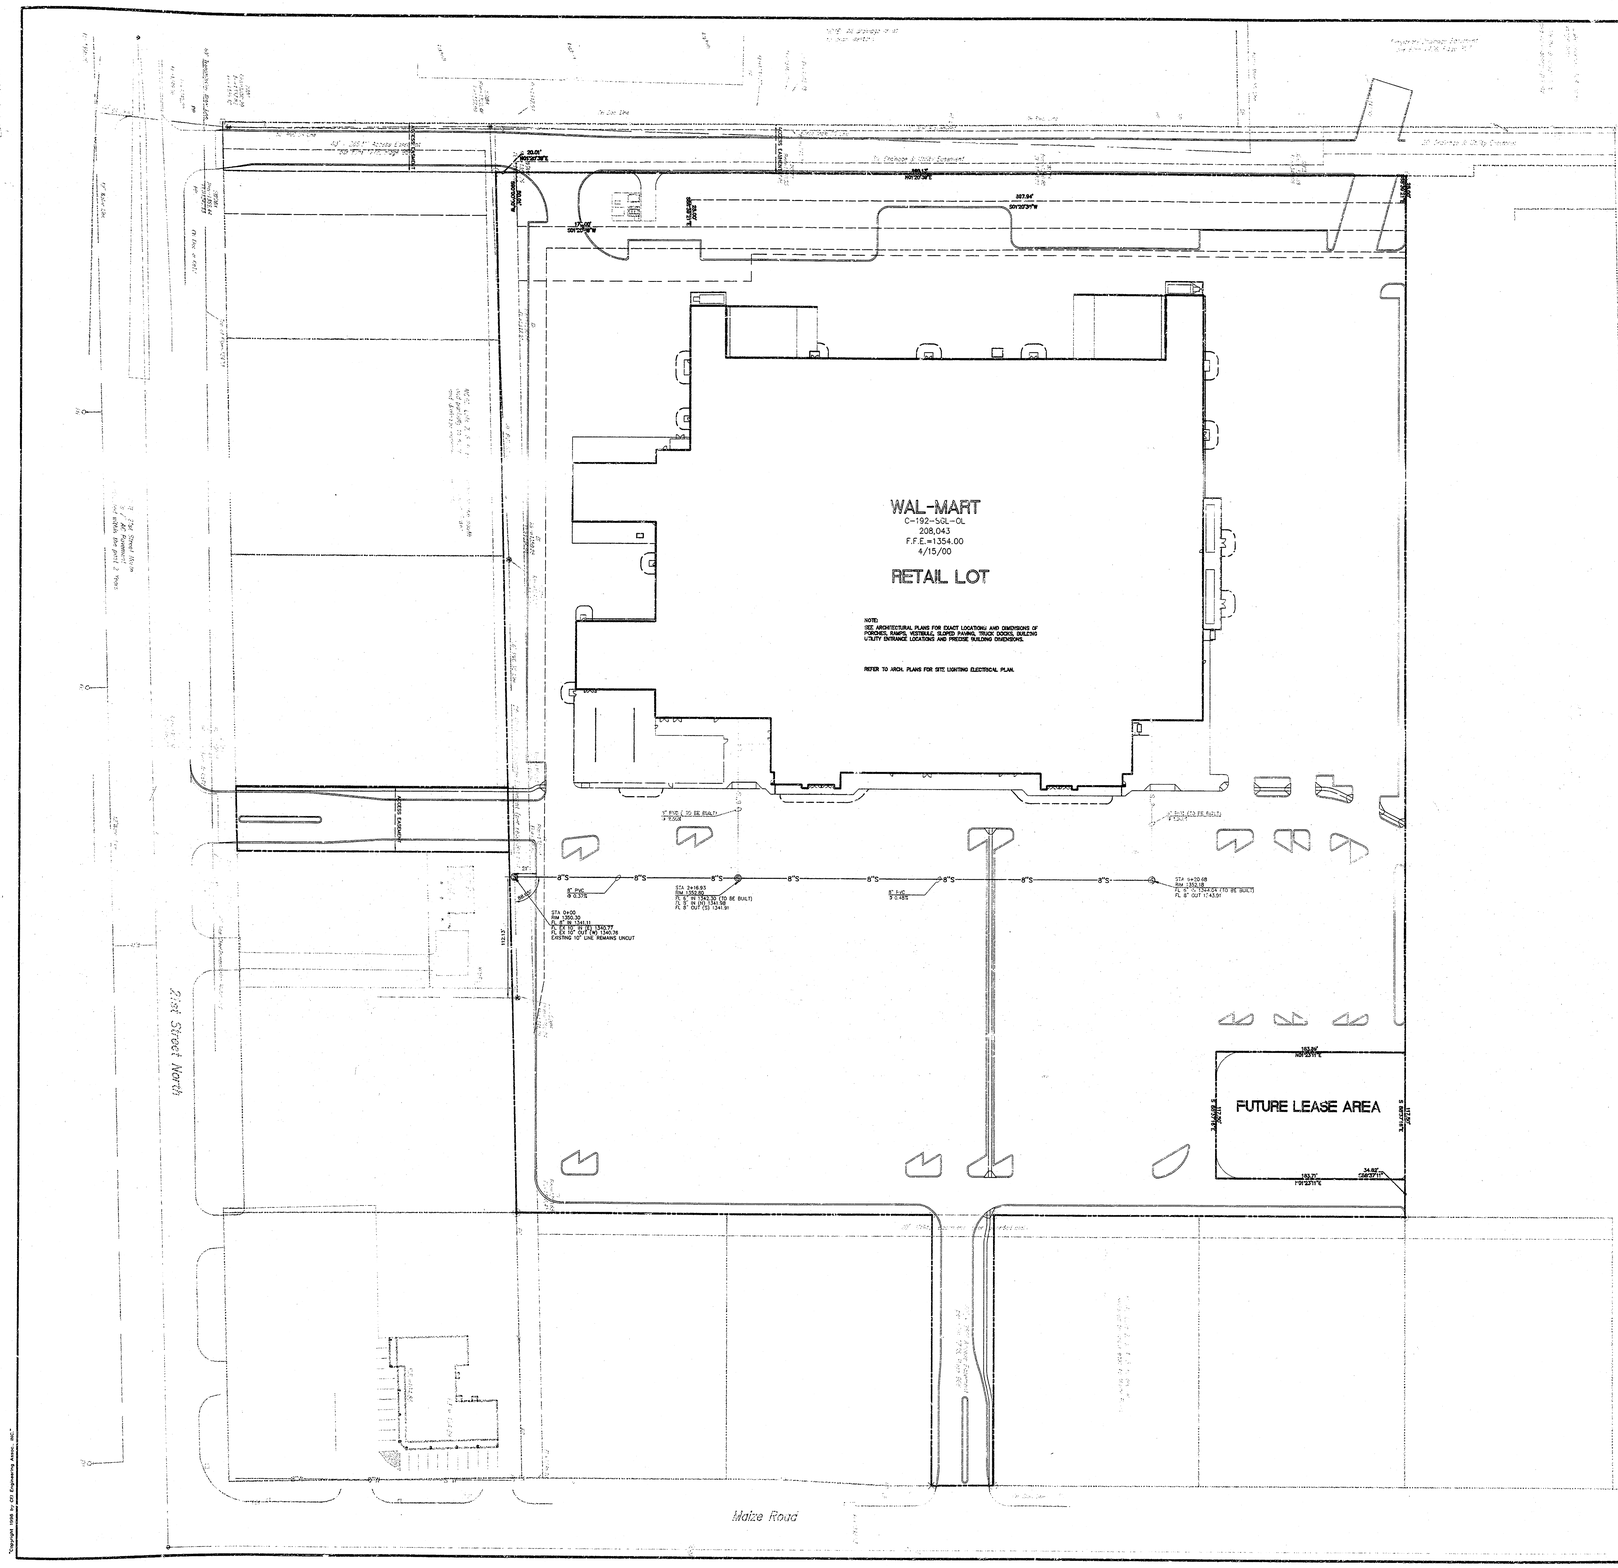


0 50' 75' 100'
SCALE IN FEET

Site Benchmark: Chiseled Cross at the eastern most Southeast corner of Lot 1, Block 1, Newmarket Square. Elevation = 1351.34(M.S.L. Sea Level)

LEGEND

EXISTING

Lot 1, Blk 1 NEWMARKET SQUARE

1085 PPS

Booked P-165 2-14-01 RDL

AS BUILT SEWER LINE INFORMATION PROVIDED BY GARDER SURVEYING SERVICE, P.A.

CITY OF WICHITA, KANSAS
PRIVATE PROJECT 1085 PPS(607861)

INITIAL DESIGN	3-13-00	WCM	W.Jw	HOY	HOY
	DATE	PRN	PM	ENG	DES

W. CHARLES MITCHELL
DESIGNED
15514
KANSAS
PROFESSIONAL ENGINEER
W. Chuck Mitchell 1/3-1-01

WAL-MART
SUPERCENTER #3283-00

CEI ENGINEERING ASSOCIATES, INC.
ENGINEERS • PLANNERS • SURVEYORS

110 W. Central Ave. Bentonville, AR 72712 (501) 273-0472 FAX (501) 273-0844

JOB NO: 15242.0
DWG NAME: 5242PROJ

AS-BUILT SEWER LINE
21ST STREET & MAIZE ROAD
WICHITA, KANSAS

DATE 01-29-01 2:58 PM

SHEET NO 1 OF 1

Copyright 1998 by CEI Engineering Assoc., Inc.

FILMED FROM THE BEST AVAILABLE COPY