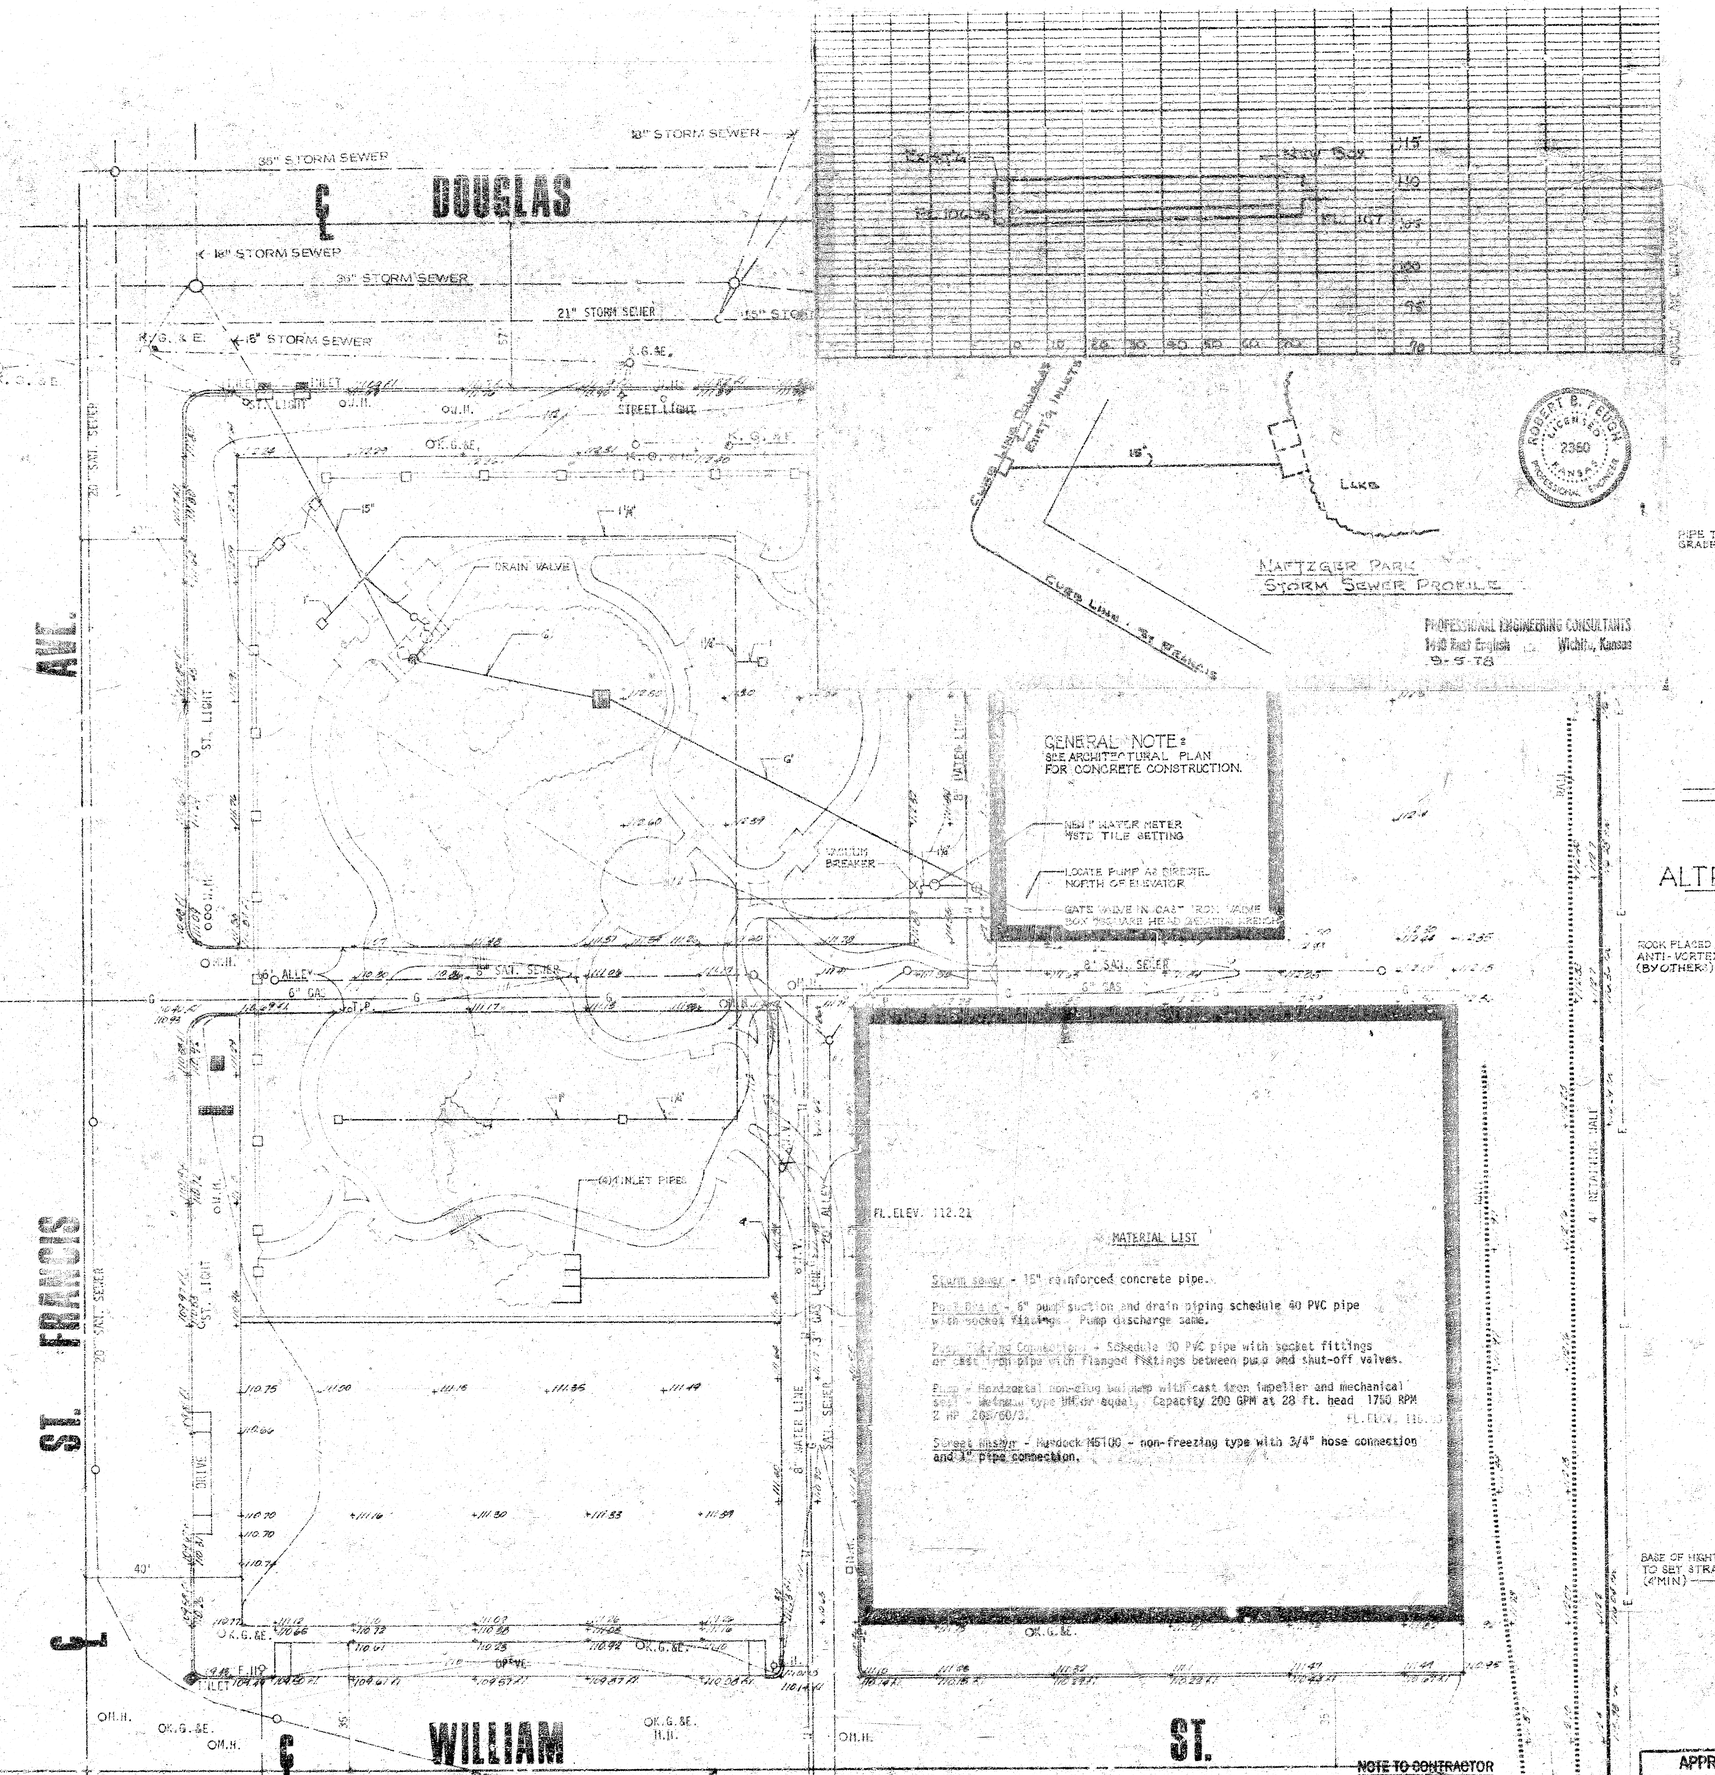


PROFESSIONAL ENGINEERING CONSULTANTS
1948 East English Wichita, Kansas
9-5-78

GENERAL NOTE:
SEE ARCHITECTURAL PLAN FOR CONCRETE CONSTRUCTION.

NEW 1" WATER METER W/STD. TILE SETTING

LOCATE PUMP AS DIRECTED NORTH OF ELEVATOR

GATE VALVE IN CAST IRON VALVE BOX W/STAR HEAD OPERATING WRENCH

MATERIAL LIST

Storm sewer - 15" reinforced concrete pipe.


Pump Piping - 6" pump suction and drain piping schedule 40 PVC pipe with socket fittings. Pump discharge same.

Pump Piping Connections - Schedule 80 PVC pipe with socket fittings or cast iron pipe with flanged fittings between pump and shut-off valves.


Pump - Horizontal non-clog bronze pump with cast iron impeller and mechanical seal - Weinman type HM (or equal). Capacity 200 GPM at 28 ft. head 1750 RPM 2 HP 208/60/3. FL.ELEV. 110.



NOTE TO CONTRACTOR
This project will be constructed under the supervision of the CITY ENGINEER

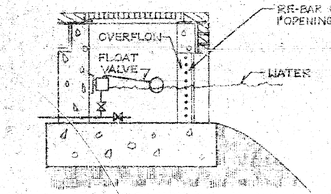


LEVEL CONTROL DETAIL
NO SCALE

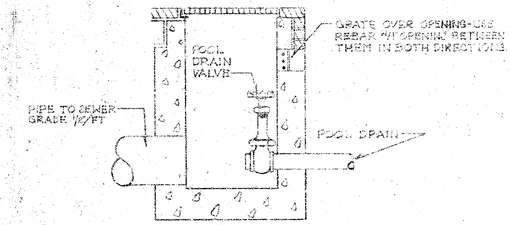


STORM DRAIN DETAIL
NO SCALE

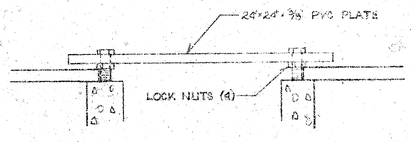

ALTERNATE ANTI-VORTEX PLATE
NO SCALE

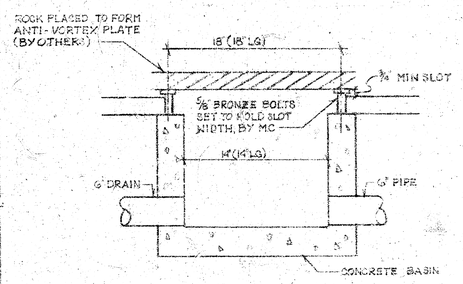

DRAIN DETAIL
NO SCALE

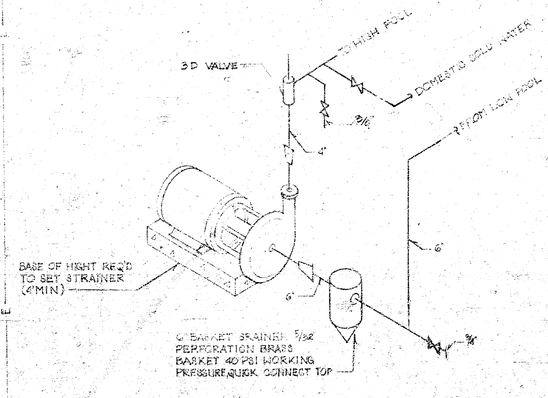

PUMP PIPING DETAIL
NO SCALE

APPROVED AS NOTED
By CITY ENGINEER OF WICHITA

bill g. yurg - design
1845 north waco wichita kansas 67203

M 1

15 JUNE 1978