

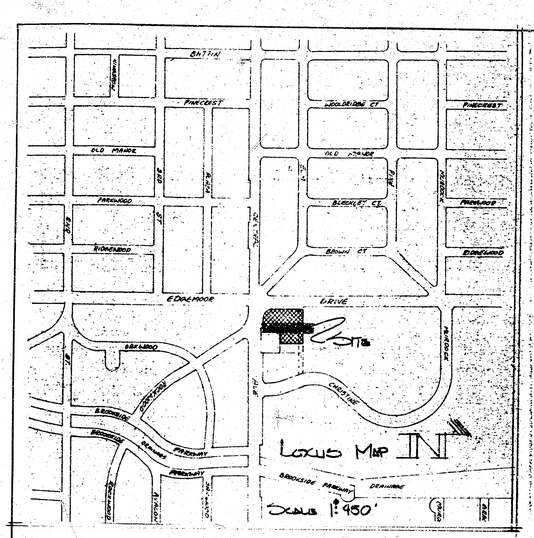


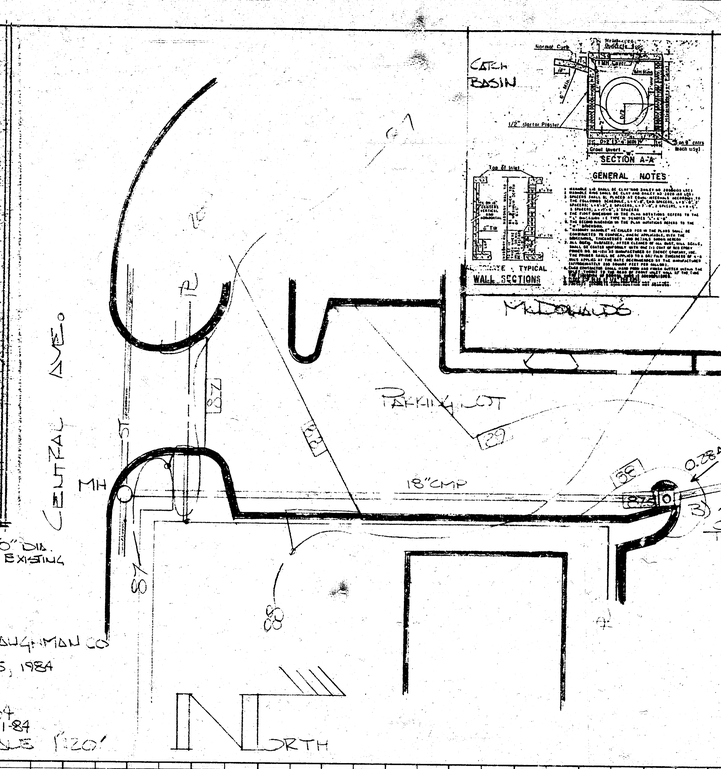

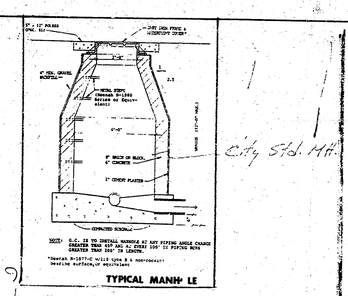

APPROVED AS NOTED
By CITY ENGINEER OF WICHITA
Sanitary Sewers
Storm Sewers
Driveway Approaches


NOTE TO CONTRACTOR

This project will be constructed under the supervision of the CITY ENGINEER and conforming to the SPECIFICATIONS of the CITY OF WICHITA. The CONTRACTOR will keep the City of Wichita for all costs of inspection.

RONALD K. FREVERMUTH
LICENSED
8644
KANSAS
PROFESSIONAL ENGINEER

SURVEY BY: BAUGHMAN CO
DATE: APRIL 25, 1984
DRAWN: LMH
DATE: 9-26-84
REVISED 10-1-84
PLAN SCALE 1"=20'

NORTH

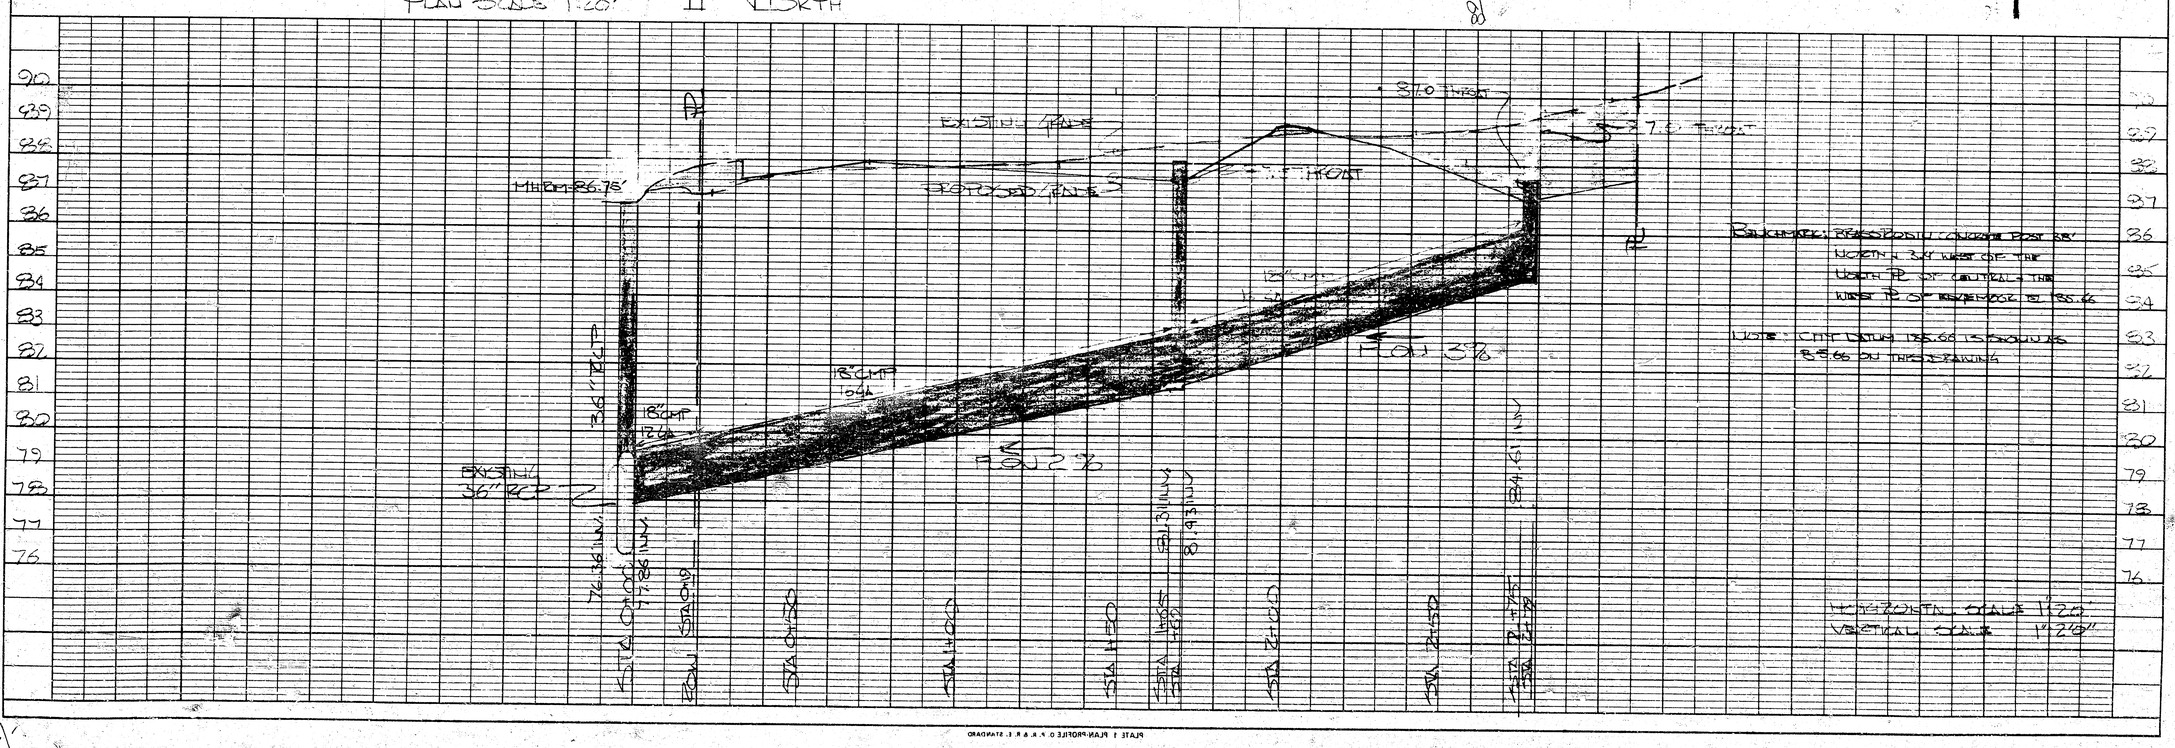

Benchmark: Prestressed concrete post 30' North & 3.4' West of the North PP of Central & the West PP of Edgemoor El 85.66

Note: Coit Datum 85.66 is shown as 85.66 on this drawing

Horizontal Scale 1"=20'
Vertical Scale 1"=5'

PLATE 1 PLAN-PROFILE O. P. R. R. E. STANDARD
ENGINEERING CO.

MCDONALDS CENTRAL & EDGEMOOR - WICHITA KS