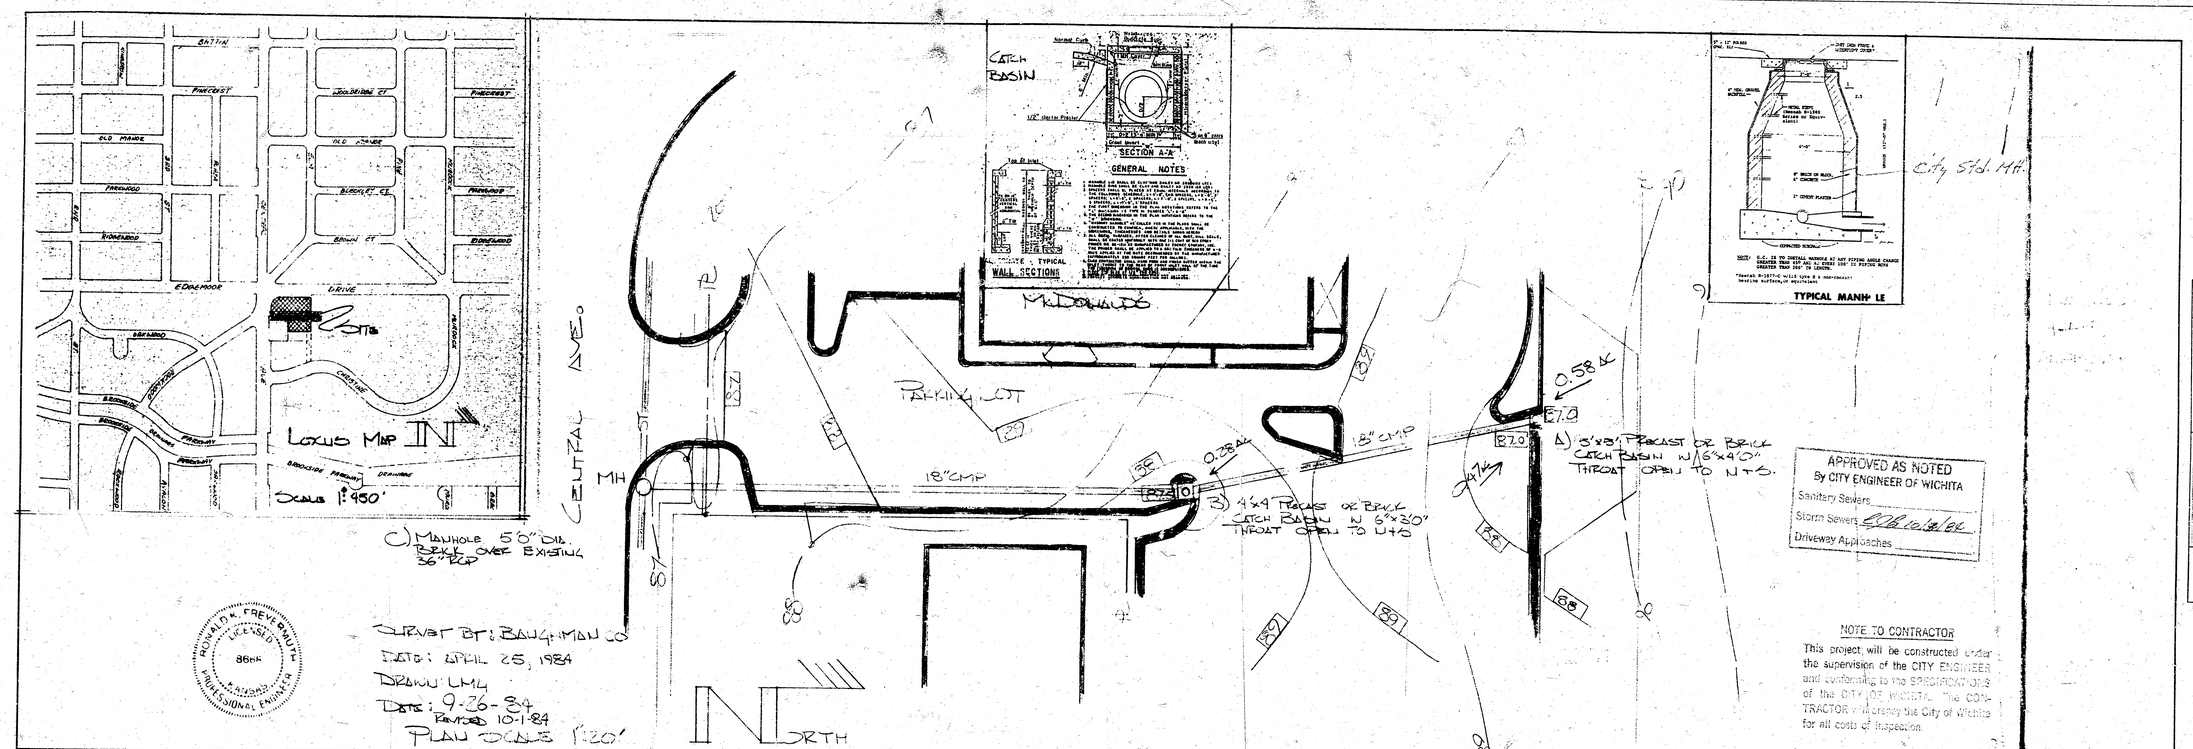

NO			DATE
MILE BOOK	MT. OL AWA CHECKED		BY
	BLUEPRINTS CHECKED		
	STAMPED		
	BROKLITE		

NO			DATE
MILE BOOK	BLUEPRINTS CHECKED		BY
	DRAWER CHECKED		
	STAMPED		
	BROKLITE		