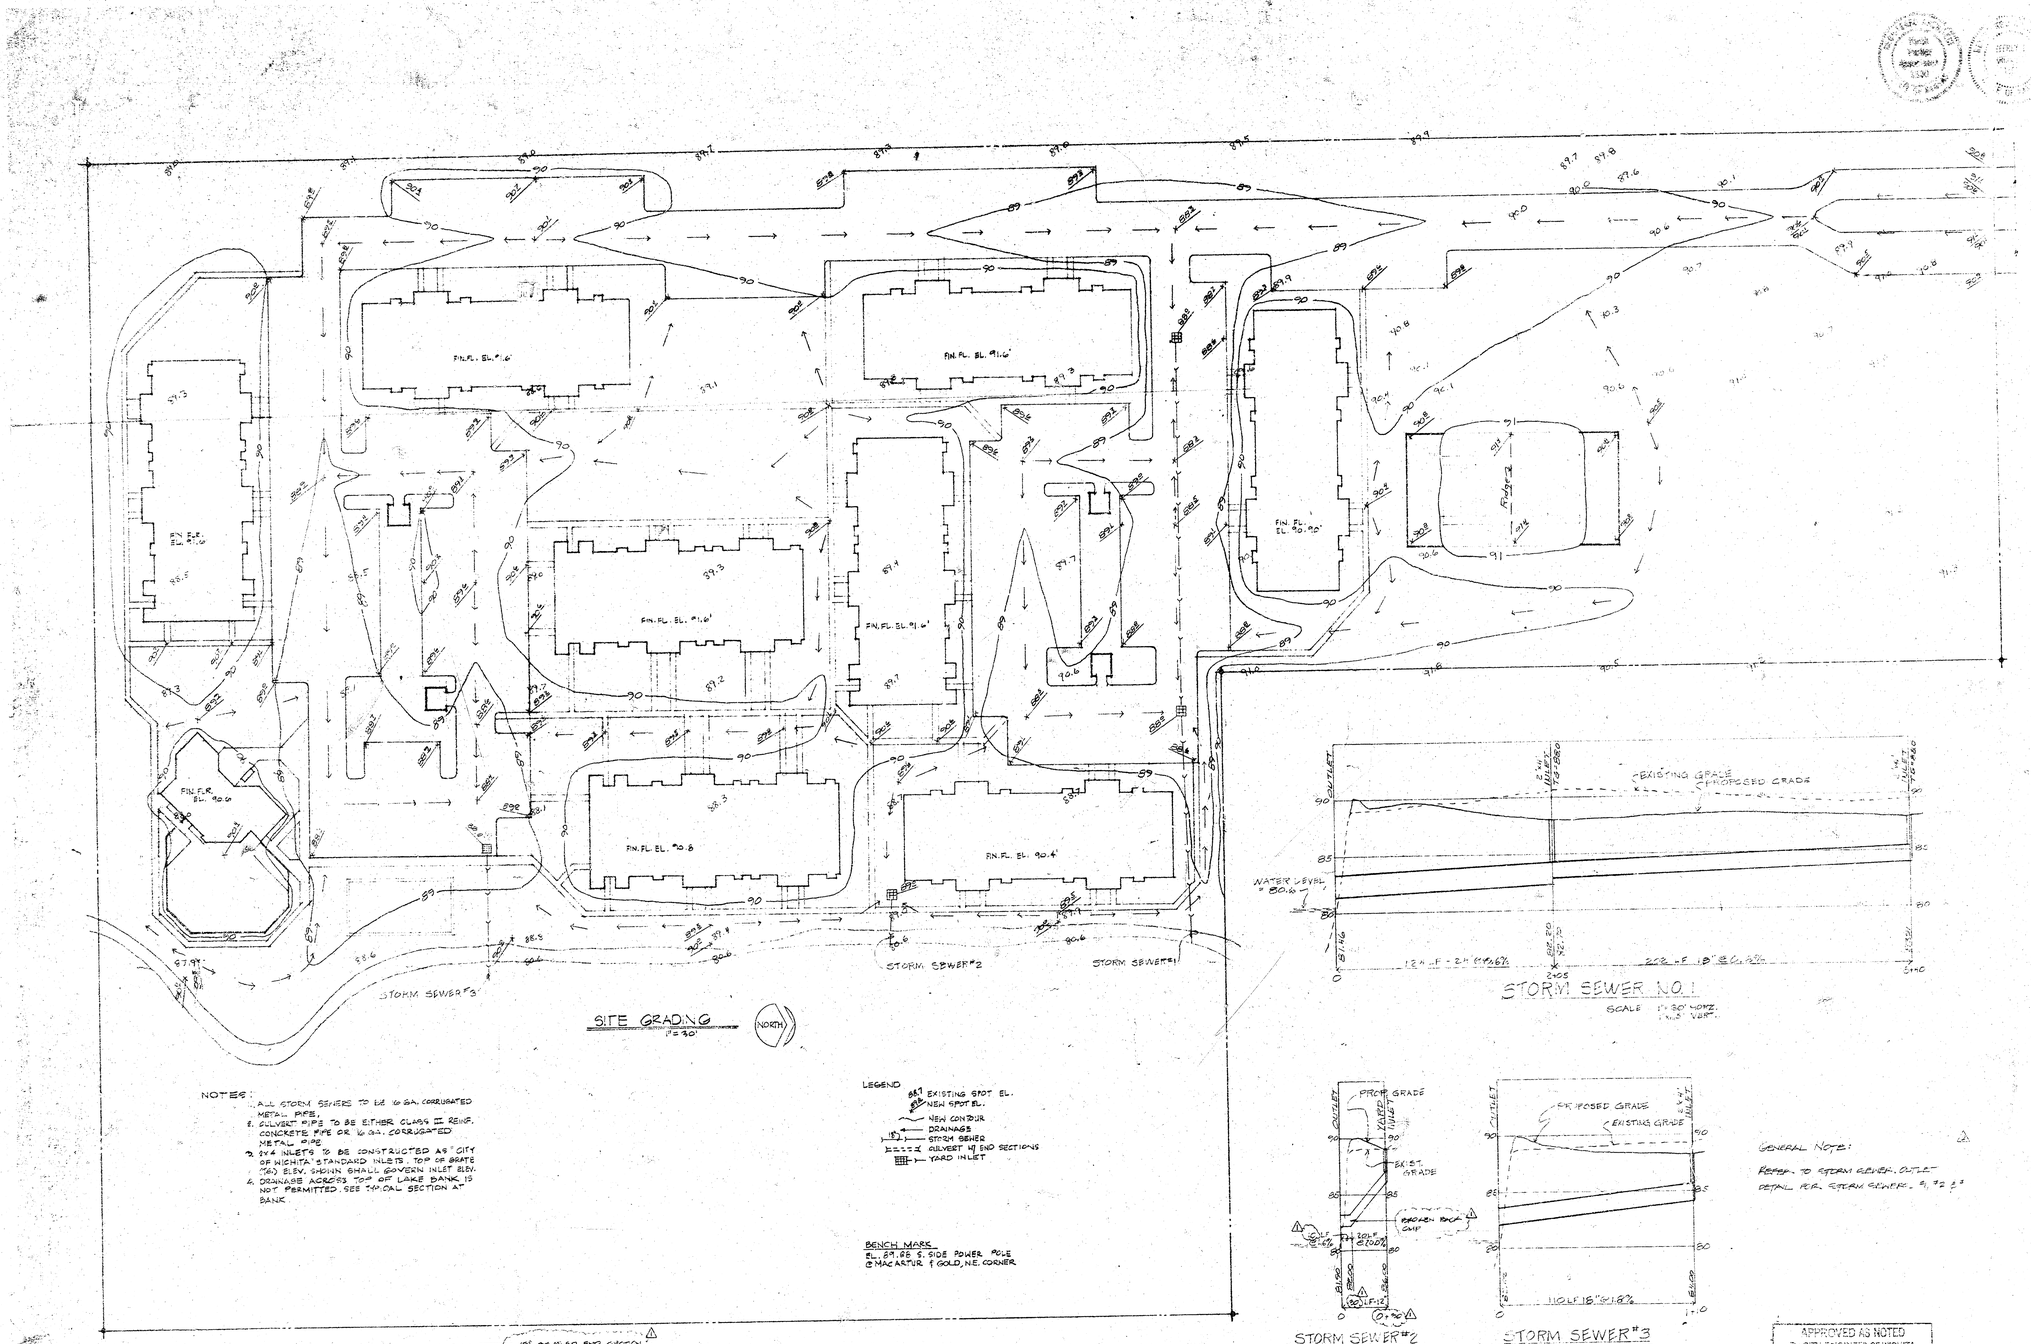


SITE GRADING
1"=30'

NOTES:
1. ALL STORM SEWERS TO BE 16 GA. CORRUGATED METAL PIPE.
2. CULVERT PIPE TO BE EITHER CLASS III REINF. CONCRETE PIPE OR 16 GA. CORRUGATED METAL PIPE.
3. 2'x4' INLETS TO BE CONSTRUCTED AS "CITY OF WICHITA" STANDARD INLETS. TOP OF GRATE (760) ELEV. SHOWN SHALL GOVERN INLET ELEV.
4. DRAINAGE ACROSS TOP OF LAKE BANK IS NOT PERMITTED. SEE TYPICAL SECTION AT BANK.

LEGEND
- 88.7 EXISTING SPOT EL.
- 88.8 NEW SPOT EL.
- NEW CONTOUR
- DRAINAGE
- STORM SEWER
- CULVERT W/ END SECTIONS
- YARD INLET

BENCH MARKS
EL. 89.88 S. SIDE POWER POLE @ MACARTUR & GOLD, NE. CORNER.


STORM SEWER NO. 1
SCALE 1"=30' HORZ. 1"=5' VERT.

STORM SEWER #2
SCALE 1"=30' HORZ. 1"=5' VERT.


STORM SEWER #3
SCALE 1"=30' HORZ. 1"=5' VERT.

GENERAL NOTE:
REFER TO STORM SEWER OUTLET DETAIL FOR STORM SEWER #1, #2 & #3


APPROVED AS NOTED
By CITY ENGINEER of WICHITA
Sanitary Sewers
Storm Sewers 4/18/80 3/28/79
Private Approaches

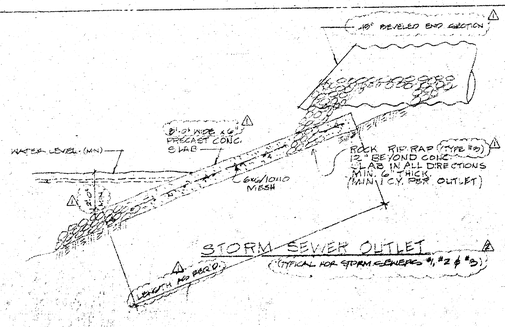

STORM SEWER OUTLET
(TYPICAL FOR STORM SEWERS #1, #2 & #3)

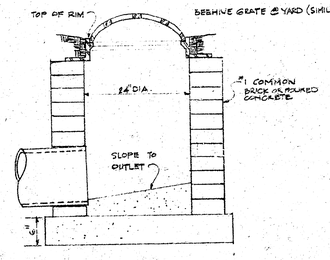

YARD INLET DETAIL
NO SCALE

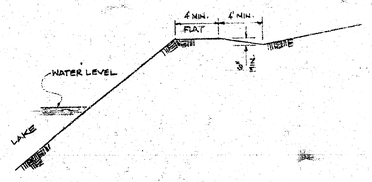

TYPICAL SECT. @ BANK
NO SCALE

CITY OF WICHITA

NOTE TO CONTRACTOR
This project will be constructed under the supervision of the CITY ENGINEER and conformance to the SPECIFICATIONS of the CITY OF WICHITA. The CONTRACTOR shall notify the City of Wichita Engineering Inspector.

prints issued

revisions

date drawn

JEFF KREHBIEL ASSOCIATES, aia
architecture · planning
100-1 east waterman wichita, kansas 67214

MACARTHUR BEACH APTS.
727 WEST MACARTHUR ROAD
WICHITA, KANSAS
FOR:
RITCHIE ENTERPRISES

sheet title
SITE GRADING

sheet
SG-1
of 1 sheets