


SHEET INDEX



SHEET NUMBER	DESCRIPTION
ARCHITECTURAL	
A-1	Site plan & sheet index
A-2	Room finish schedule, door & window schedules
A-3	Floor Plan
A-4	Exterior Elevations
A-5	Building section, wall section & details
A-6	Typical room plans & details
A-7	1/4" Kitchen & Laundry plans & details
STRUCTURAL	
S-1	Footings & foundation plan
S-2	Wall framing plan & details
MECHANICAL	
M-1	Heating plan & details
M-2	Cooling plan & details
M-3	Mechanical plan & details
ELECTRICAL	
E-1	Electrical plan & details

15' drive along Bluffview appeared
Hydrant location appeared
if accessible. 10-9-78

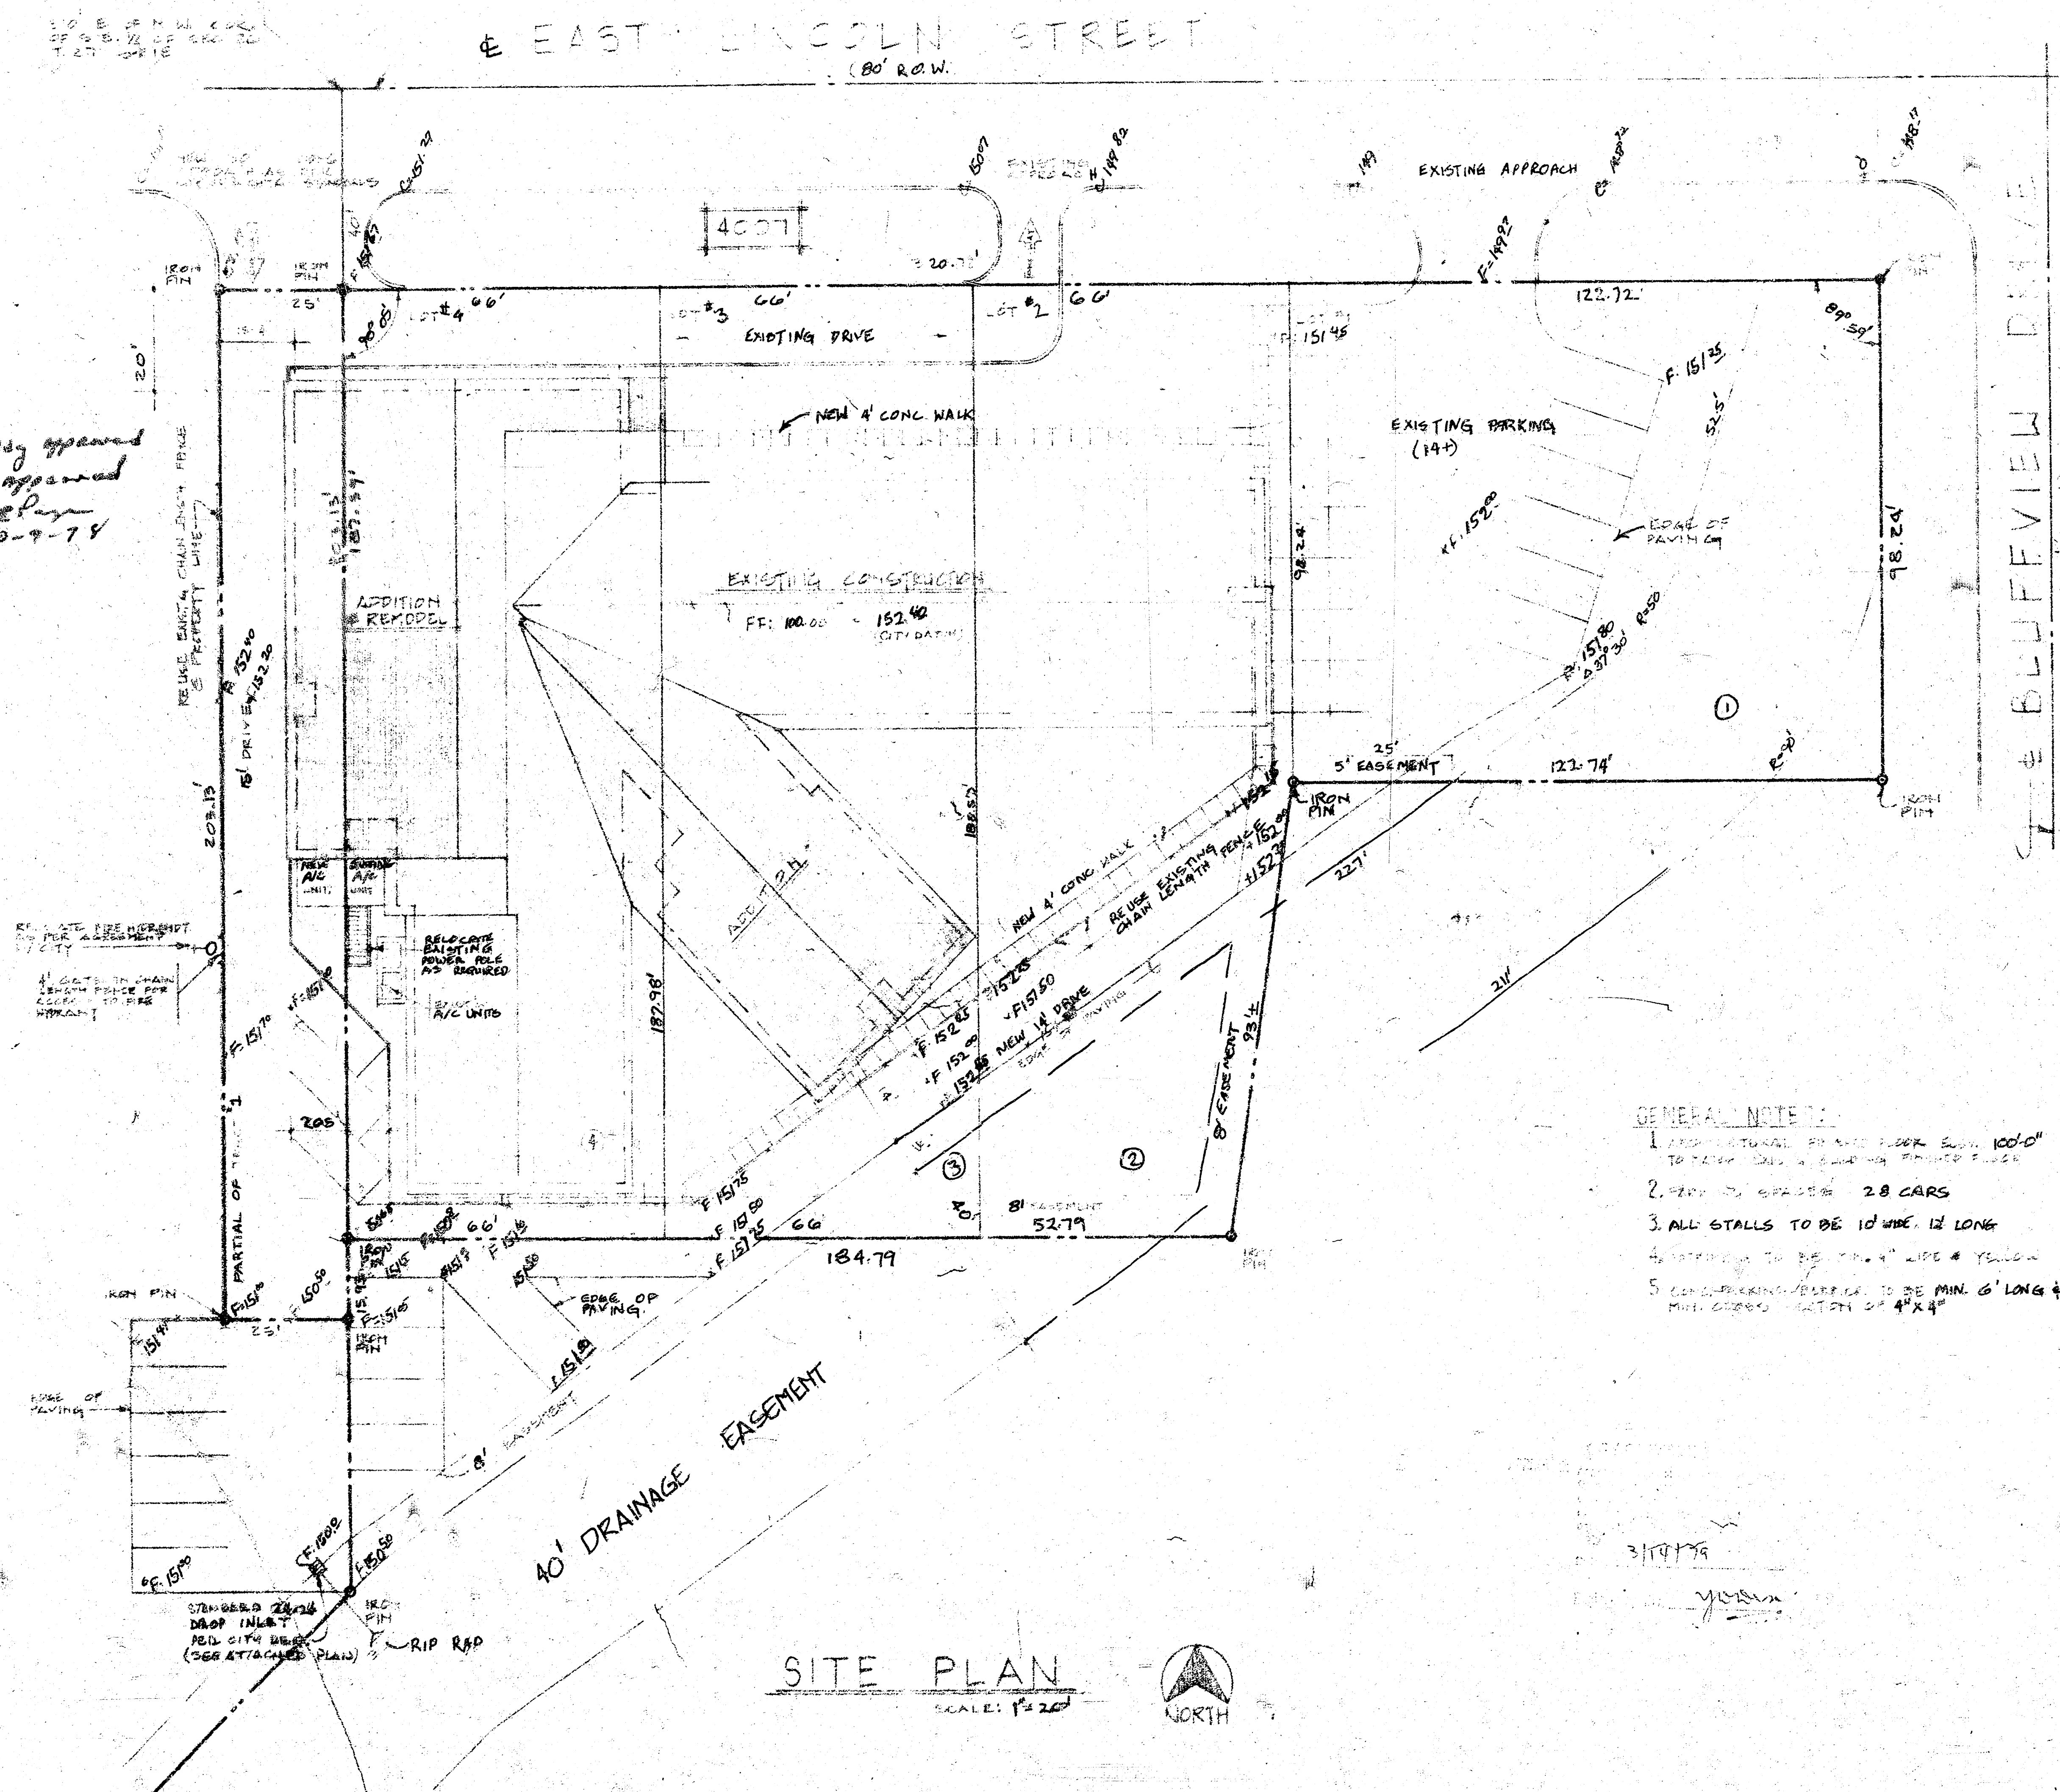

LEGAL

Lots 1, 2, 3 and 4, Mount St. Mary's Addition to Wichita, Sedgewick County, Kansas, and a tract in the Southeast Quarter of Section 26, T27S, R1E, of the 6th Principal Meridian, described as beginning at the Northwest corner of Lot 4 Mount St. Mary's Addition, thence south along the West line of Mount St. Mary's Addition a distance of 203.13 feet; thence west parallel to the North line of said Southeast Quarter a distance of 25 feet; thence north parallel to the West line of said Mount St. Mary's Addition a distance of 203.13 feet; thence east 25 feet to the point of beginning.

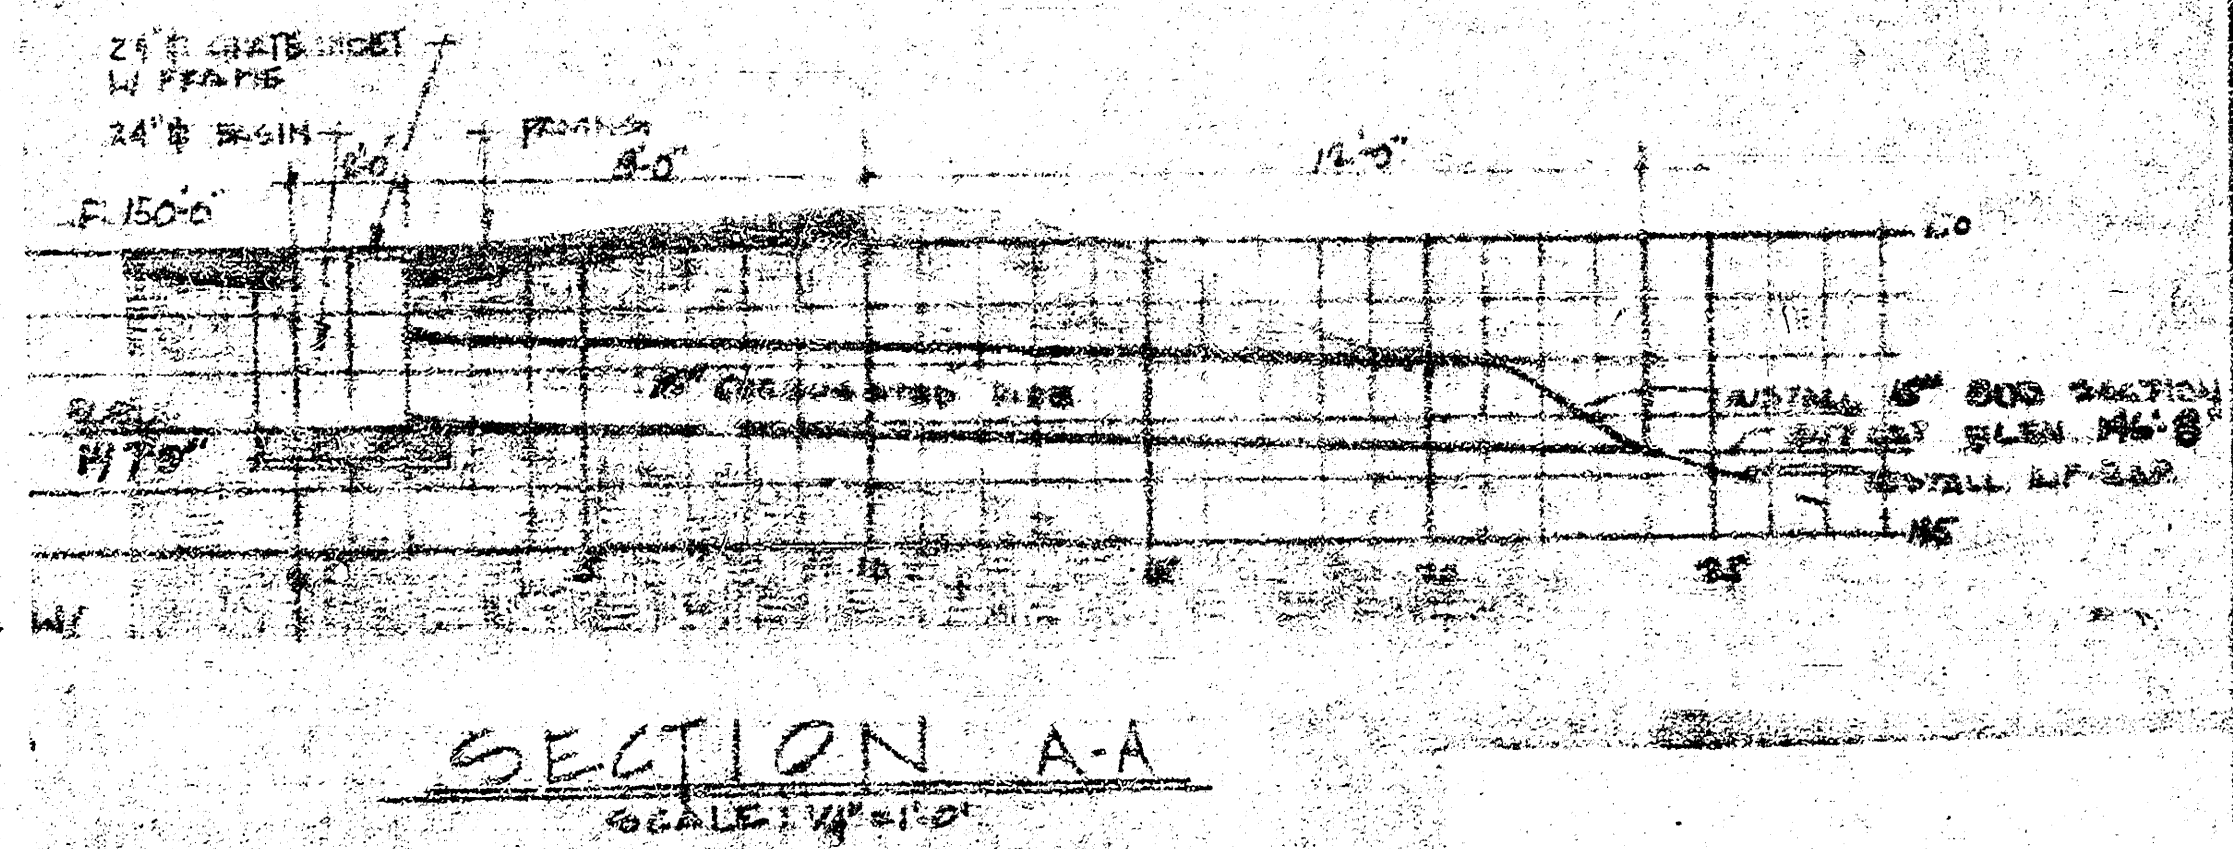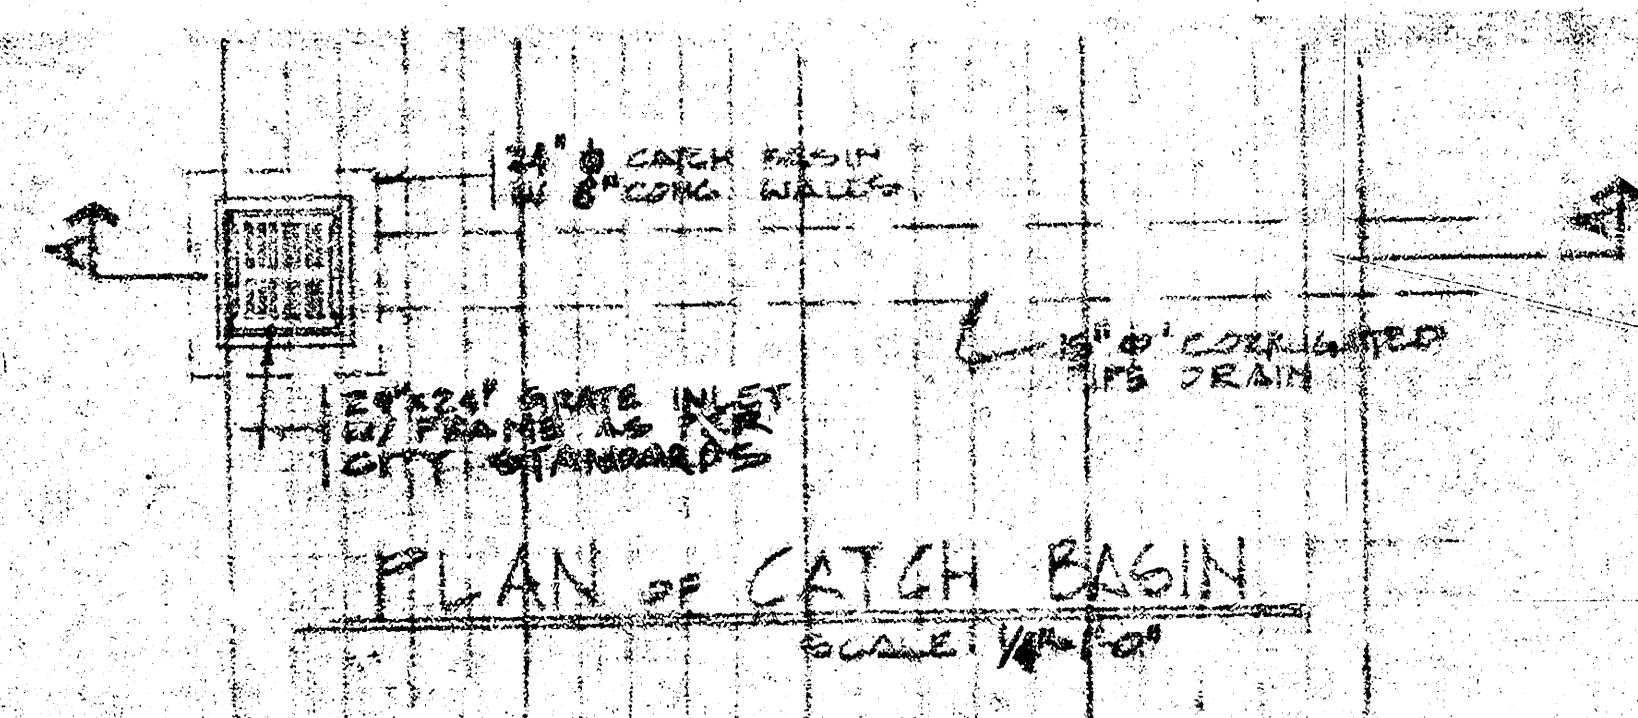


GENERAL NOTES

2. ALL STALLS TO BE 10' WIDE, 12' LONG.

SITE PLAN


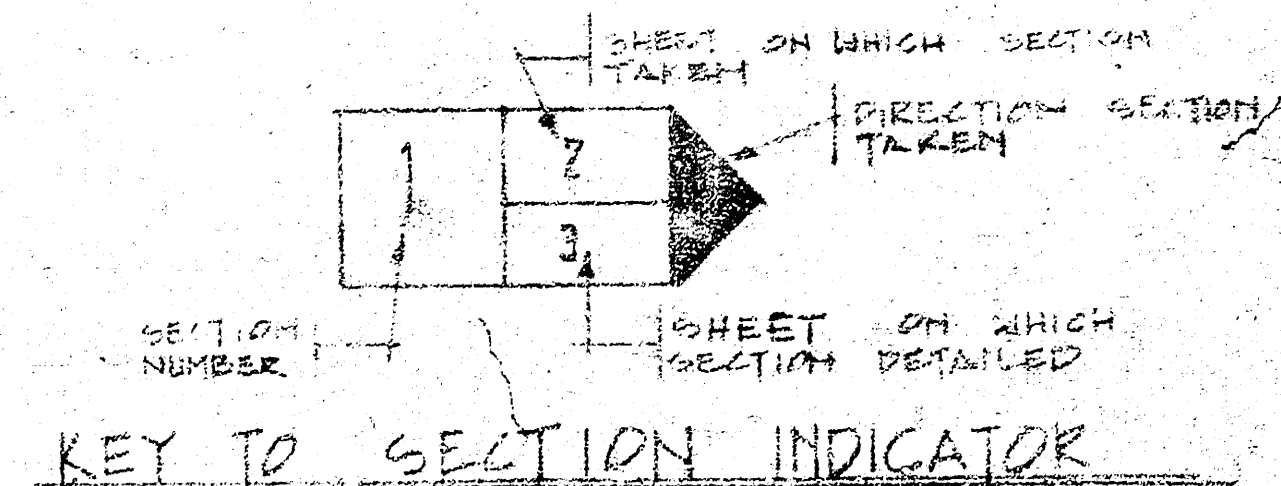

AN ADDITION & REMODEL LINCOLN EAST NURSING HOME WICHITA, KANSAS	
JOB NO. 2-221	
DATE: 3-14-79	SHEET NO. 1 OF 1
REVISIONS: 1	
REGISTERED ARCHITECT HARRY L. GIEGER STATE OF KANSAS	

SET NO.