


SCALE  
 PLAN 1" = 20'  
 PROFILE 1" = 2'  
 VERT. 1" = 2'  
 HORZ. 1" = 20'



NOTE  
 ALL STORM SEWER LINES UNDER ASPHALT SHALL BE BACKFILLED WITH AB-3 ROCK, COMPACTED TO A MIN. 95% STANDARD DENSITY.

NOTE  
 DISCHARGE PIPE MUST BE INSTALLED BEFORE CONCRETE DRAINAGE SWALE IS BUILT.

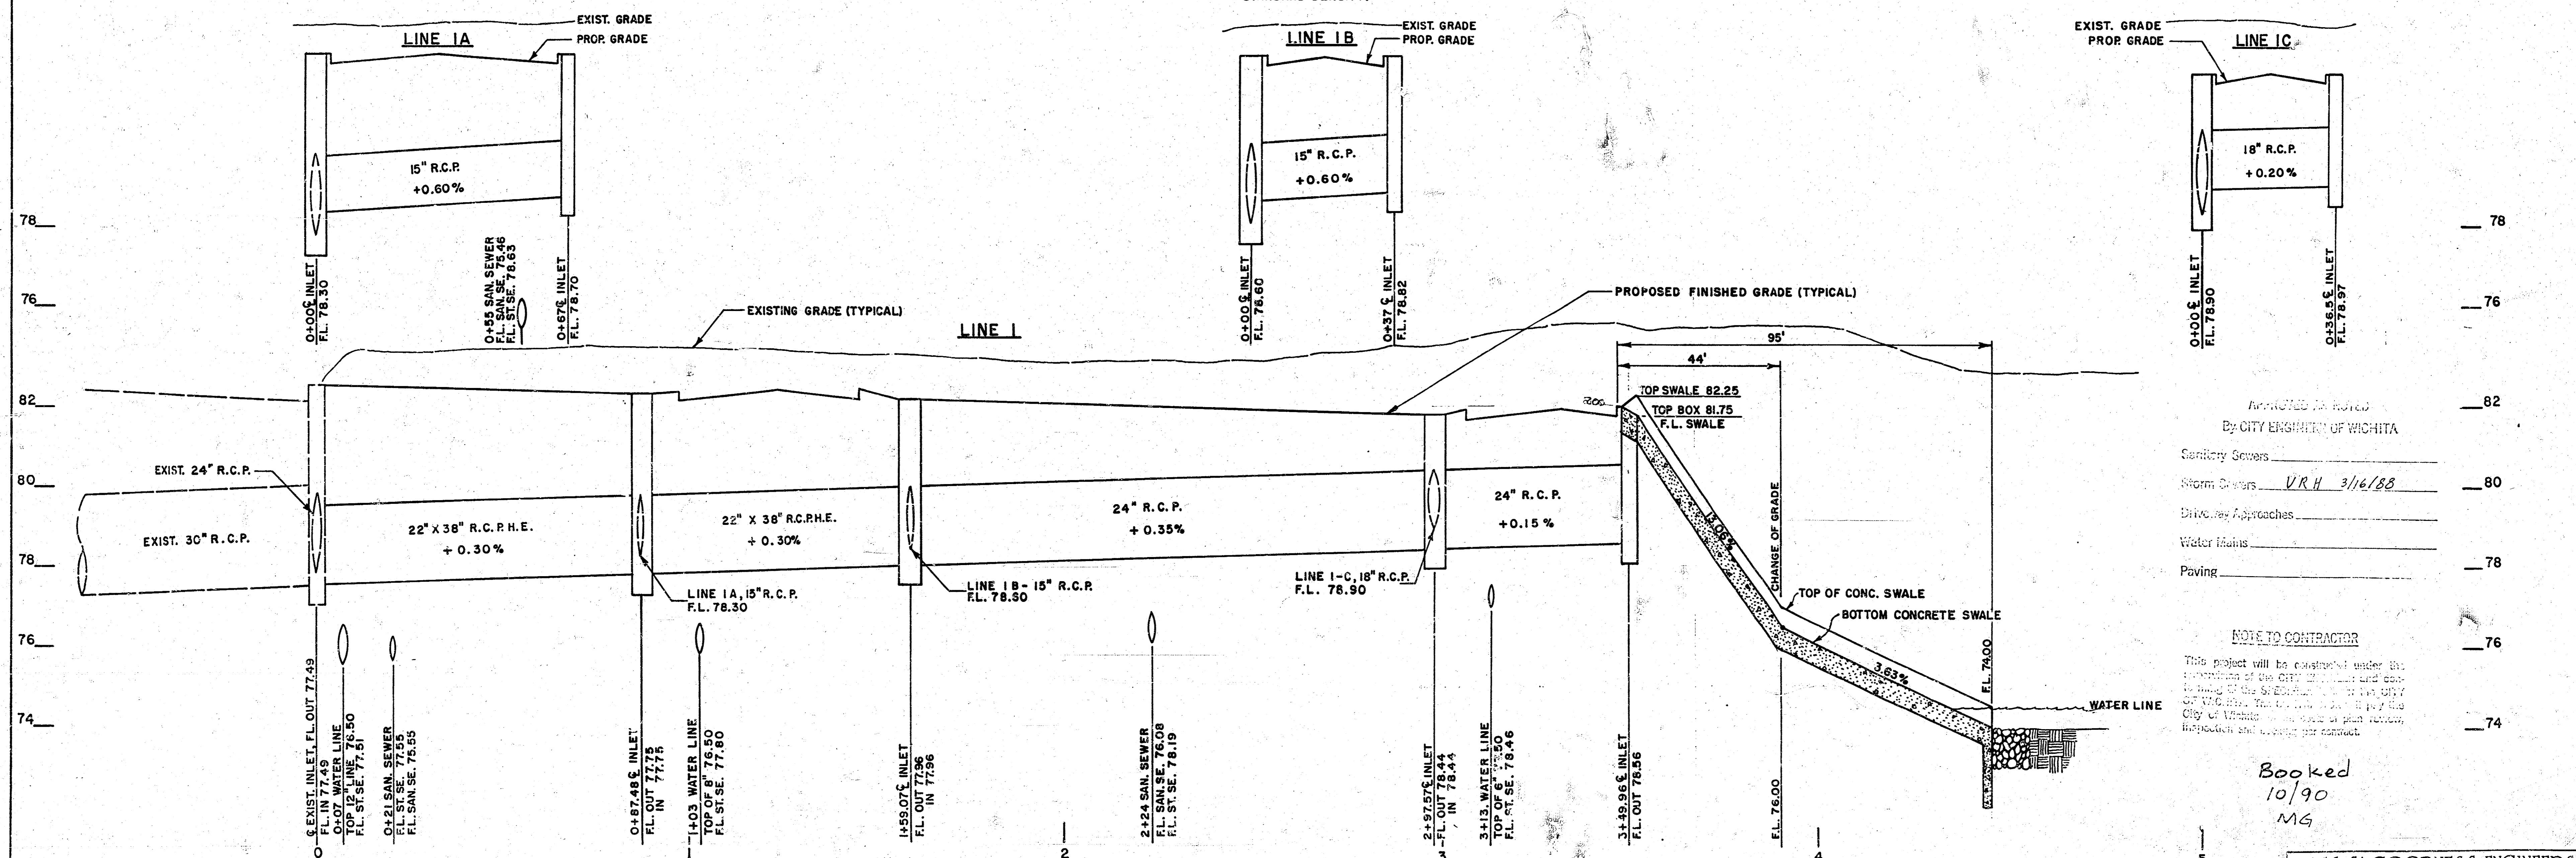


NOTE TO CONTRACTOR  

Booked  
 10/90  
 MS

CITY OF WICHITA PRIVATE PROJECT # 468-76-245-90001-000-000-160

REISS & GOODNESS ENGINEERS  
 2100 WEST 21<sup>ST</sup> STREET  
 WICHITA, KANSAS 67204  
 (316) 832-0213

REVISION	DRAWN BY	CHECKED BY	DESIGNED BY	PROJECT	CUSTOMER	SCALE	NOTED	PROJECT NO.
		AB	AB	STORM SEWER LINES 1, 1A, 1B, 1C & DETAILS	LAMPLIGHTER MOBILE HOME PARK	1" = 20'		MS 1288

DATE
 SHEET 9 OF |