
## GENERAL NOTES

1. PROVIDE ELECTRIC SERVICE TO LIGHT FIXTURES, PARKING CONTROL EQUIP ETC. AS REQ'D AND NOTED ON THE SITE PLAN.
2. NEW LIGHT FIXTURES (3 THUS) SHALL BE PRESCOLITE #5976 1/1-VHO T-15 LAMP, OPAL ACRYLIC DIFFUSER, HEAD AND FITTINGS ALL ALUMINUM LOW TEMP BALLAST, POST #6K W/ 2-PIECE BASE COVER. PROVIDE BRONZE FINISHED ALUMINUM IN COLOR AS SELECTED. MOUNTING HEIGHT 11'-0" - CONCRETE BASES AS REQ'D BY MFGR. AND FURNISHED BY G.C.
3. ALL DIMENSIONS, RADIUSES, ETC. ARE TO FACE OF CURB.
4. ALL NEW WALKS SHALL BE 4" CONCRETE (CITY MIX) W/ 6-6 #8/#8 W.W.F. OVER 3" COMPACTED SAND FILL. MATCH FINISH WHERE NEW WALK IS ADJACENT TO EXISTING.
5. PROVIDE ½" EXPANSION JOINT MATERIAL BETWEEN BACKSIDE OF CONCRETE CURB AND WALKS, AND BETWEEN EXISTING WALKS AND NEW WALKS. PROVIDE WITHIN NEW WALKS AT MAXIMUM 20'± O.C.
6. LOCATE CONTROL JOINTS AS INDICATED ON SITE PLAN AT 5'± O.C.
7. ALL NEW WALKS, PAVING AND CURBS SHALL CONFORM TO EXISTING DIRECTION OF SLOPES FOR PROPER SURFACE DRAINAGE. VERIFY ALL ELEVATIONS THAT DEVIATE FROM THOSE SHOWN ON THE SITE PLAN.
8. ALL NEW CONC. CURBS SHALL MATCH EXISTING PROFILE (DEPTH, WIDTH ETC.) AND SHALL BE CITY MIX.
9. ALL NEW COMBINED CURB AND GUTTER SHALL BE CITY MIX-STANDARD OR REVERSE GUTTER AS REQ'D FOR FLOW OF SURFACE DRAINAGE.
10. VERIFY DEPTH AND LOCATION OF ALL UNDERGROUND UTILITIES BEFORE EXCAVATION WORK.
11. ALL ELEVATIONS ARE FINISH GRADE OF PAVING OR FLOW LINE GUTTER.

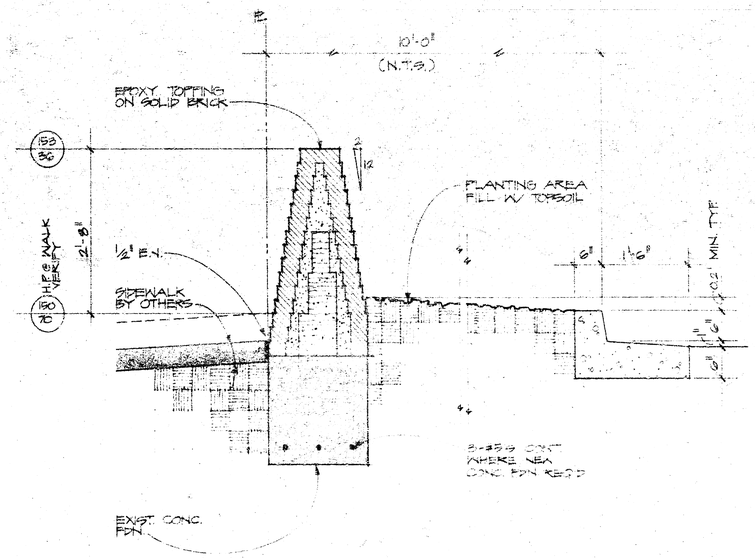


**1B** SECTION @ MASONRY WALL 3/4"=1'-0"

EXTENDED CARE FACILITIES

NOTE TO CONTRACTOR
This project will be constructed under the supervision of the CITY ENGINEER and conforming to the SPECIFICATIONS of the CITY OF WICHITA. The CONTRACTOR will reimburse the City of Wichita for all cost of Engineering, Plans, and Inspection.

5-4-76

APPROVED AS NOTED
By CITY ENGINEER OF WICHITA
Sanitary Sewers _____
Storm Sewers O.E.S.
Driveway Approaches _____

NORTH PARKING GARAGE

PINE STREET (VACATED)

VACATED PROPERTY LINE

MATERNITY BUILDING

14 EQUAL SPACES @ APPROX. 9'-0" EACH

NORTHWEST COURTYARD

WEST BUILDING

PLANTING AREA

PROPERTY LINE

HILLSIDE AVENUE

25 SPACES @ 9'-0" EACH = 225'-0"

MATCH LINE & PATIENT ENTRANCE

**A** SITE PLAN/PARKING LOT "C" 1" = 20'

"Storm Water Ext. for Wesley Medical Center"

LEGEND

EXISTING CURB & GUTTER TO REMAIN

THOMAS, HARRIS, ASH & MASON Architects & Engineers
202 NORTH WACO WICHITA, KANSAS 67202 (316) 262 5644

PARKING REVISIONS
WESLEY MEDICAL CENTER
WICHITA KANSAS
HILLSIDE LOTS
PROJECT NO.
DATE
REVISIONS
CHECKED