
WATERFORD NORTH THIRD ADDITION
STORM WATER SEWER NO.
PROJ. NO. 468.76-245-80001 .000-000-071

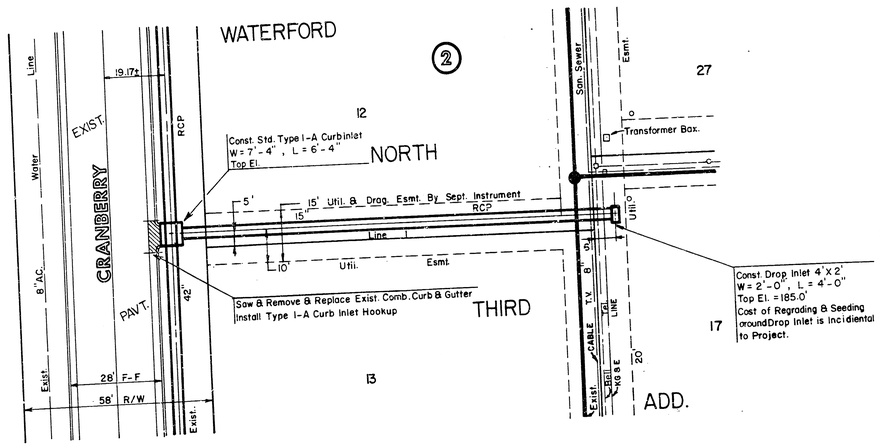


Scale: 1" = 20' Horiz.
1" = 5' Vert.

NOTE TO CONTRACTOR

This [illegible] be constructed under the supervision of the CITY ENGINEER and conform to the SPECIFICATIONS of the CITY OF W[illegible] CONTRACTOR will pay the [illegible] charges of plan review, [illegible] of contract.

By [illegible]
Sanitary Sewer
Storm Sewer
CIP 6-3-86

FINALED
4-15-87
GREENE

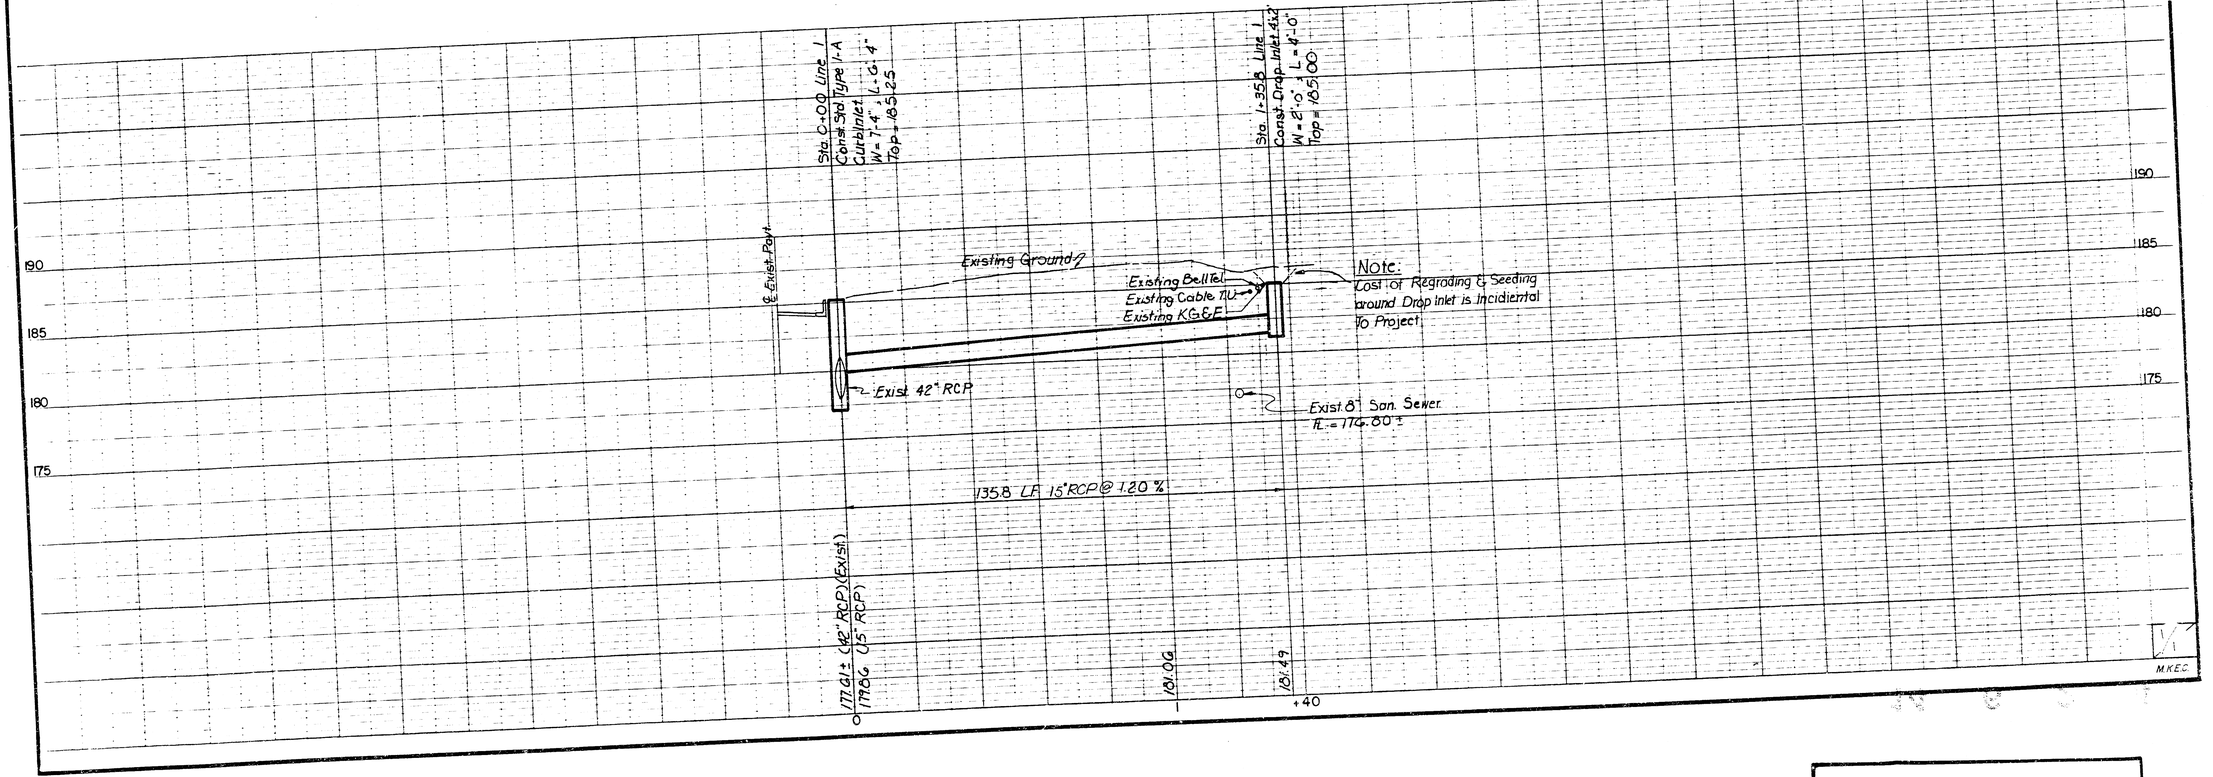

FILMED FROM THE BEST AVAILABLE COPY ····