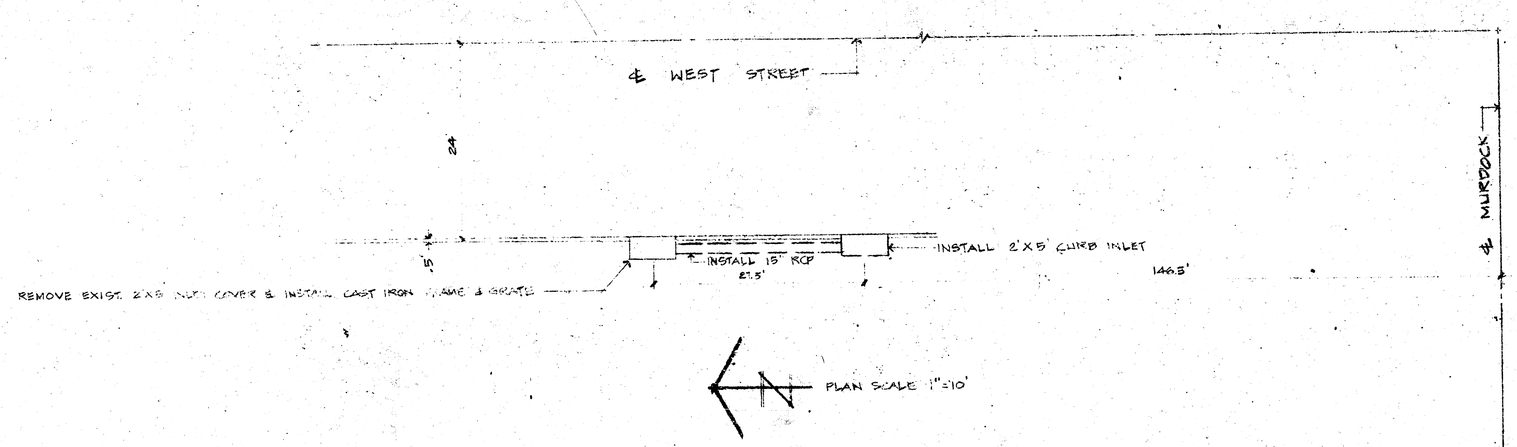


PROFILE SCALE - HORIZ 1"=10'
VERT 1"=5'

* PENCIL MARK - WILL BE 6" N GLOBE 1' SOUTH OF SOUTH END RADIUS SW COR WEST & MAIN

EX. GRATED 2'X3' INLET
EL 122.67 (NORTH)
EL 122.53 (SOUTH)

25.5 LF 15" RCP @ 0.60%

EX. CI 2.5' 2'X3' INLET
EL 120.65 GUTTER

EL 122.67 (NORTH)

125
120
115
110

UTILITY CONTRACTORS
AS BUILT STORM SEWER PLAN
BIT N WEST ST
DATE JULY 11 1971