

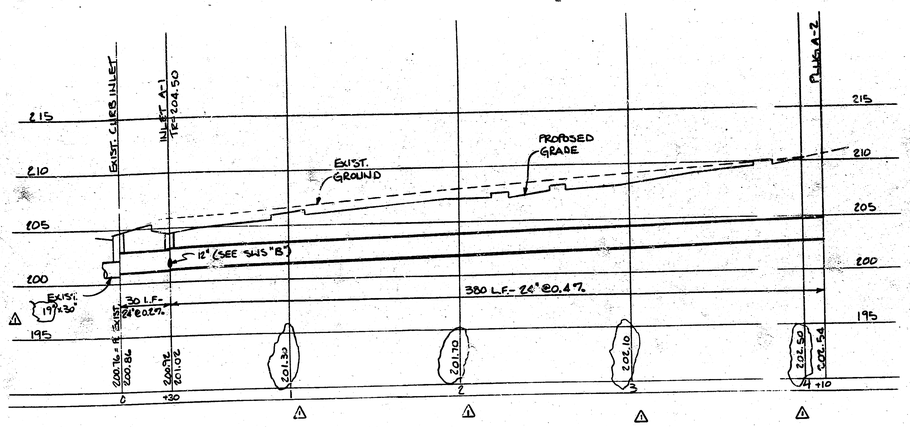



3 SWS "A"
HORZ. 1"=30'
VERT. 1"=5'

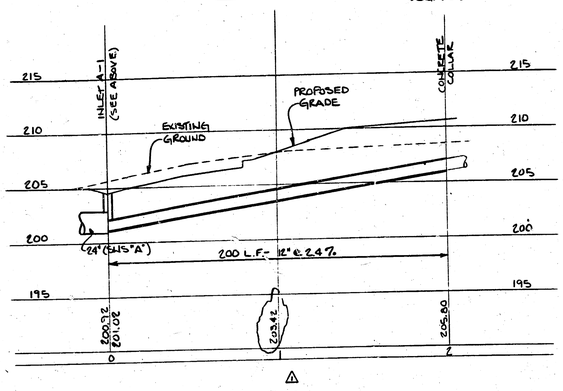


4 SWS "B"
HORZ. 1"=30'
VERT. 1"=5'

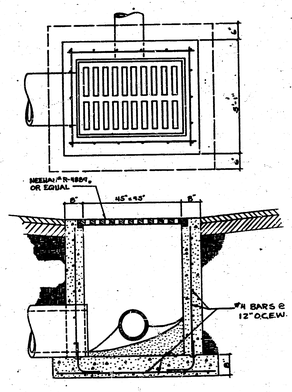


1 INLET DETAIL
N.T.S.

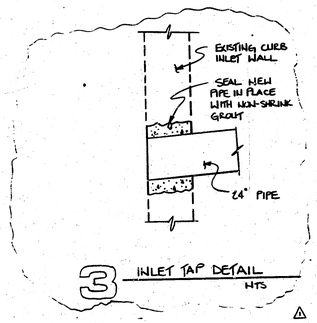

3 INLET TAP DETAIL
NTS

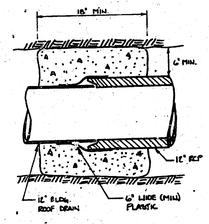

2 CONCRETE COLLAR
N.T.S.

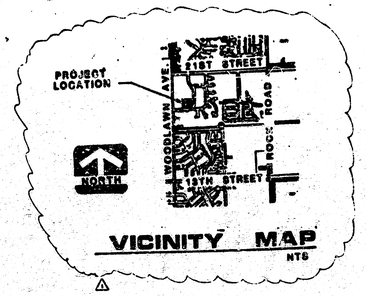

VICINITY MAP
NTS


GENERAL NOTES

1. Refer to plumbing drawings for exact location and elevation of roof drains. Site Storm Water Sewer to connect to roof drain system or provide temporary plug.
2. Refer to Sheet SA-1 for coordinate baseline information.
3. Refer to Site Survey for Bench Mark and complete existing topographic information.
4. All Storm Sewers shown on this sheet to be Reinforced Concrete Pipe.
5. Contractor to contact Continental Pipeline Company prior to any grading work within pipeline easement.

APPROVED AS NOTED
By CITY ENGINEER OF WICHITA
Sanitary Sewers _____
Storm Sewers 6/16 4/14/95
Driveway Approaches _____

NOTE TO CONTRACTOR

This project will be constructed under the supervision of the CITY ENGINEER and conforming to the SPECIFICATIONS of the CITY OF WICHITA. The CONTRACTOR will pay the City of Wichita for all costs of plan review, inspection and testing per contract.

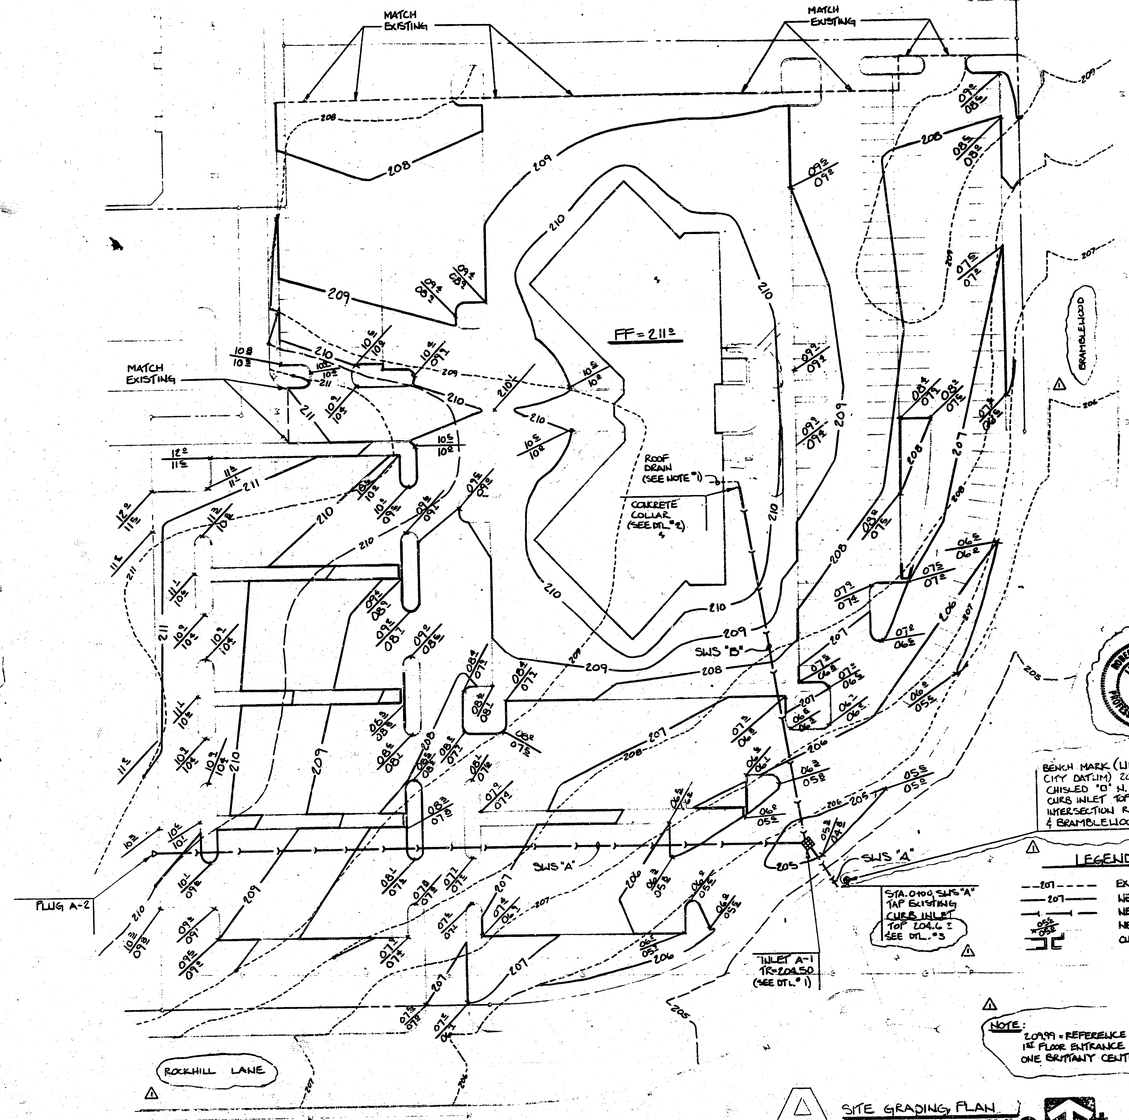

A SITE GRADING PLAN
1"=30'-0"

NORTH

ROBERT D. FINCHER LICENSED 6719 KANSAS PROFESSIONAL ENGINEER

PRINTS ISSUED		
DATE	PURPOSE	NO.
1-18-95	FOR BIDDING & PERMIT	1

FOR CONSTRUCTION:

REVISIONS		
DATE	ITEM	NO.
4-13-95	PSV. STORM SEWER	1

LAW/KINGDON, INC.
ARCHITECTS & ENGINEERS
340 RIVERVIEW, WICHITA, KANSAS 67203
Phone (316) 268-0230 Copyright © 1994

REGISTERED ARCHITECT BEN J. KINGDON 1096 STATE OF KANSAS

DRAWN	CHECKED
	BJK

RELATED DRAWINGS

SHELL	
DETAILS	
STRUCTURE	
MECHANICAL	
ELECTRICAL	
OTHER	

SEQUENCE NUMBER
OF SHEETS

TWO BRITTANY PLACE
WICHITA, KANSAS
PROJECT NUMBER 7515

KEY PLAN

CITY MAP # 428-76-5N5-B0001-000-000-0NE

SITE GRADING PLAN
SHEET TITLE
SHEET NUMBER SG1
OF SHEETS

FILMED FROM THE BEST AVAILABLE COPY