
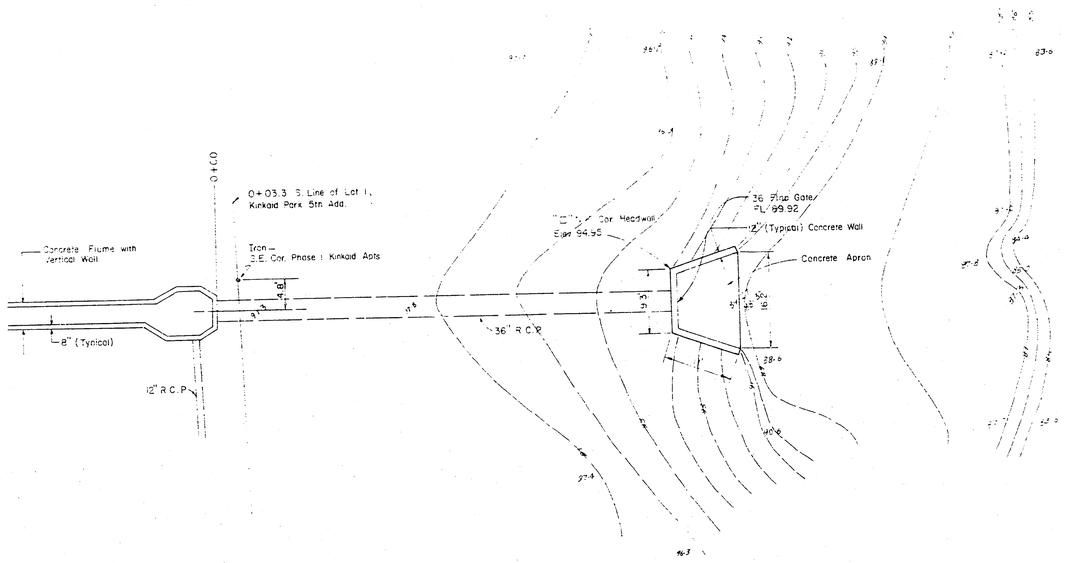


BENCH MARK : Top of Iron at S.W. Corner Lot 1, Kinkaid Park 5th Addition. Elev. 98.20 City Datum

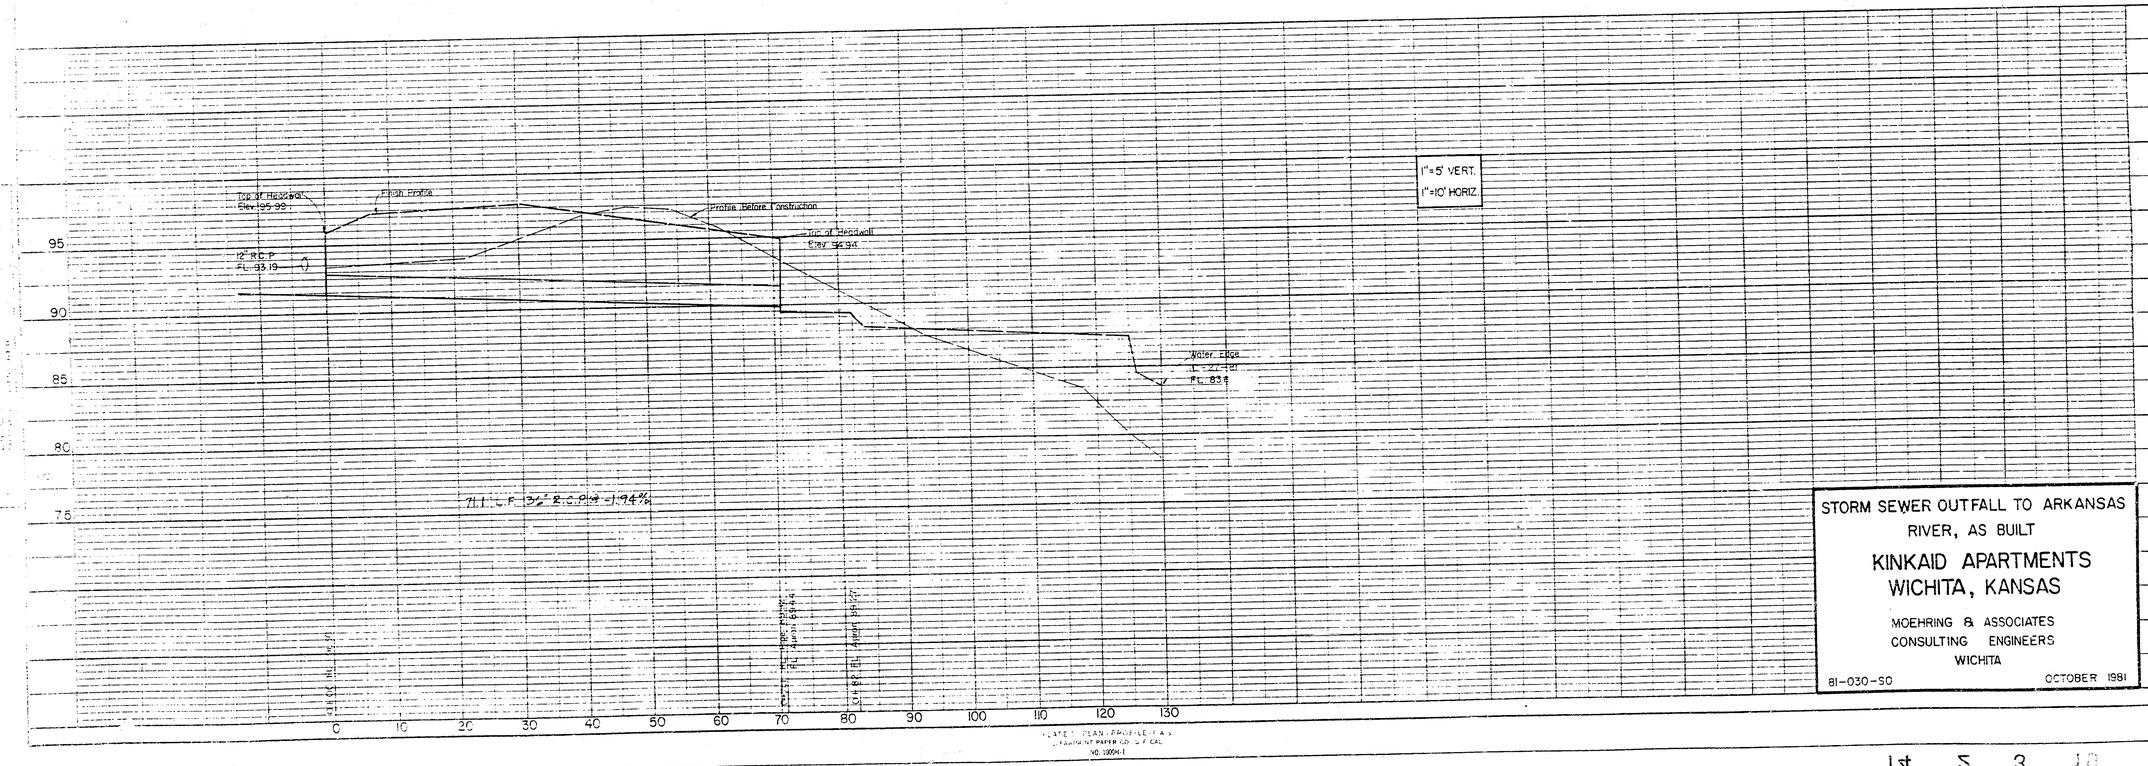

STORM SEWER OUTFALL TO ARKANSAS RIVER, AS BUILT

KINKAID APARTMENTS
WICHITA, KANSAS

MOEHRING & ASSOCIATES
CONSULTING ENGINEERS
WICHITA

81-030-50 OCTOBER 1981

1/1

FILMED FROM THE BEST