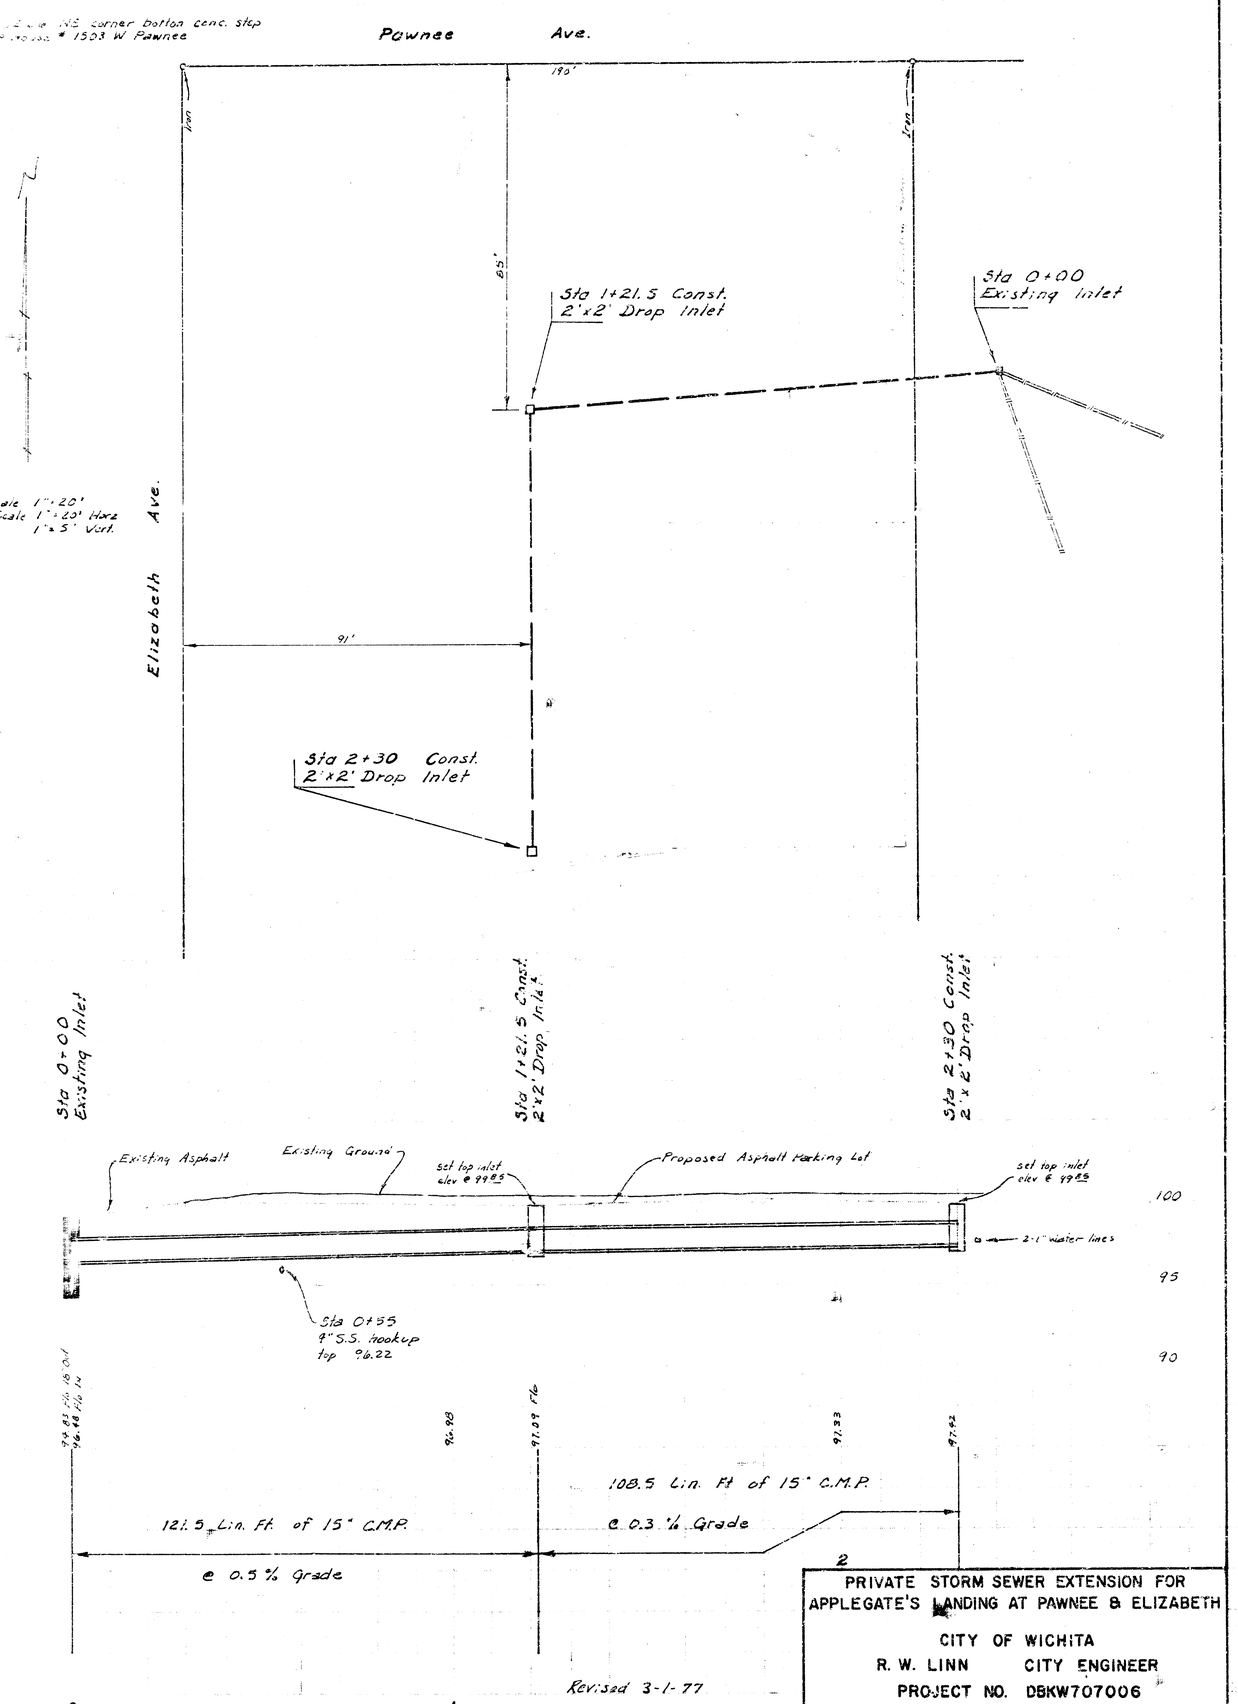

PRIVATE STORM SEWER EXTENSION FOR
APPLEGATE'S LANDING AT PAWNEE & ELIZABETH

CITY OF WICHITA
R. W. LINN CITY ENGINEER
PROJECT NO. DBKW707006

Revised 3-1-77

APPROVED AS NOTED
BY CITY ENGINEER, WICHITA

Note: Replace the 4" Clay Pipe Sanitary Sewer hookup with 4" Ductile Iron Pipe a minimum distance of 2.5 ft. on both sides of the center line Storm Sewer. Concrete Collars must be installed on the joints between the Iron & Clay pipe.