STATE		FISCAL YEAR	SHEET NO	TOTAL SHEETS

1. Contractor shall provide for Construction Staking
2. Inspection shall be paid for by Owner and furnished by Engineer.
3. The Contractor shall be responsible for maintaining continuous flow through construction. Contractor proposed method for maintaining flow shall be approved by the Engineer.
4. The Contractor shall be responsible for preserving property irons. The Contractor will be required to re-establish any property irons which are damaged or destroyed by his construction operations. Such irons shall be re-established by a licensed land surveyor or a licensed professional Engineer in accordance with state laws.
5. All construction shall conform to the Standard City of Wichita Specifications for the installation of Storm Water Sewers.
6. Contractor shall verify Top of Manhole grades with Paving Contractor and adjust if neccesary.
7. Underground utility service lines and overhead utility pole lines are to be adjusted as neccessary by others prior to construction unless the plans specifically call for their adjustment by the Contractor or unless the plans specifically identify a utility to be adjusted by its owner during construction. Existing utilities and their location, as shown on the plans, represent the best information obtainable for design. Location information has been obtained from the various utility companies and is either from company record drawings or company provided field locations. The Contractor will be required to work around existing utilities within the right-of-way which do not conflict with proposed construction.
8. Rubble from the removal of miscellaneous structures and excess excavation which is to be wasted shall be disposed of on sites to be provided by the Contractor. These sites shall be approved by the Engineer as to suitability, appearance and site location. Locations that, in the opinion of the Engineer, will leave an unsightly appearance will not be approved.
9. The Contractor shall notify pipeline companies at least 24 hours in advance of any work being performed across and/or adjacent to pipelines.

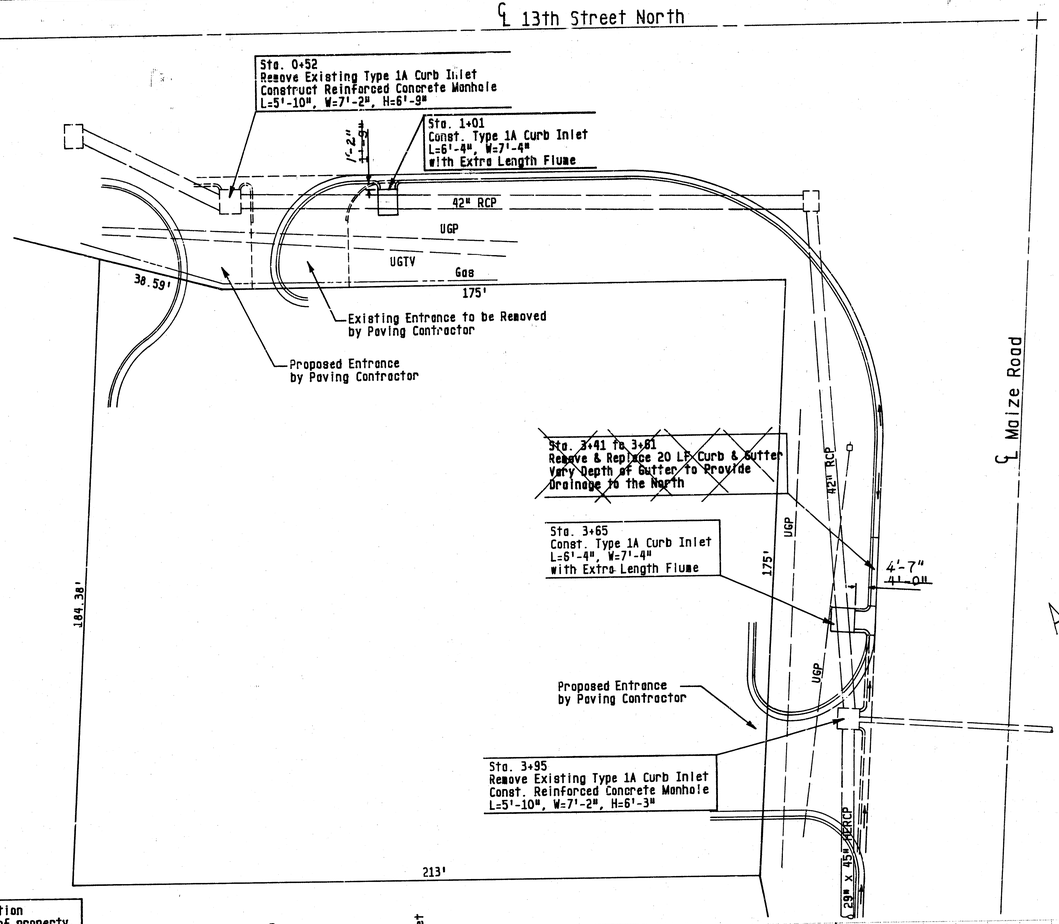

NOTE TO CONTRACTOR

INSPECTION AND TESTING FOR THIS PROJECT IS TO BE PROVIDED BY A LICENSED CONSULTING ENGINEERING FIRM [illegible] CONTRACT WITH THE [illegible] ON ACCOUNT [illegible] CONSTRUCTION [illegible] LICENSED [illegible] PERFORMED [illegible] OF-WAY [illegible] SHALL [illegible] ON PUBLIC RIGHT-OF-WAY WITHOUT WRITTEN AUTHORIZATION BY THE CITY ENGINEER

APPROVED AS NOTED
By CITY ENGINEER OF WICHITA

Sanitary Sewers _____
Storm Sewers VRH 12/1/88
Driveway Approaches _____
Water Mains _____
Project _____

BOOKED: 1-11-89 MCG

KENNY E. HILL LICENSED 7690 KANSAS PROFESSIONAL ENGINEER

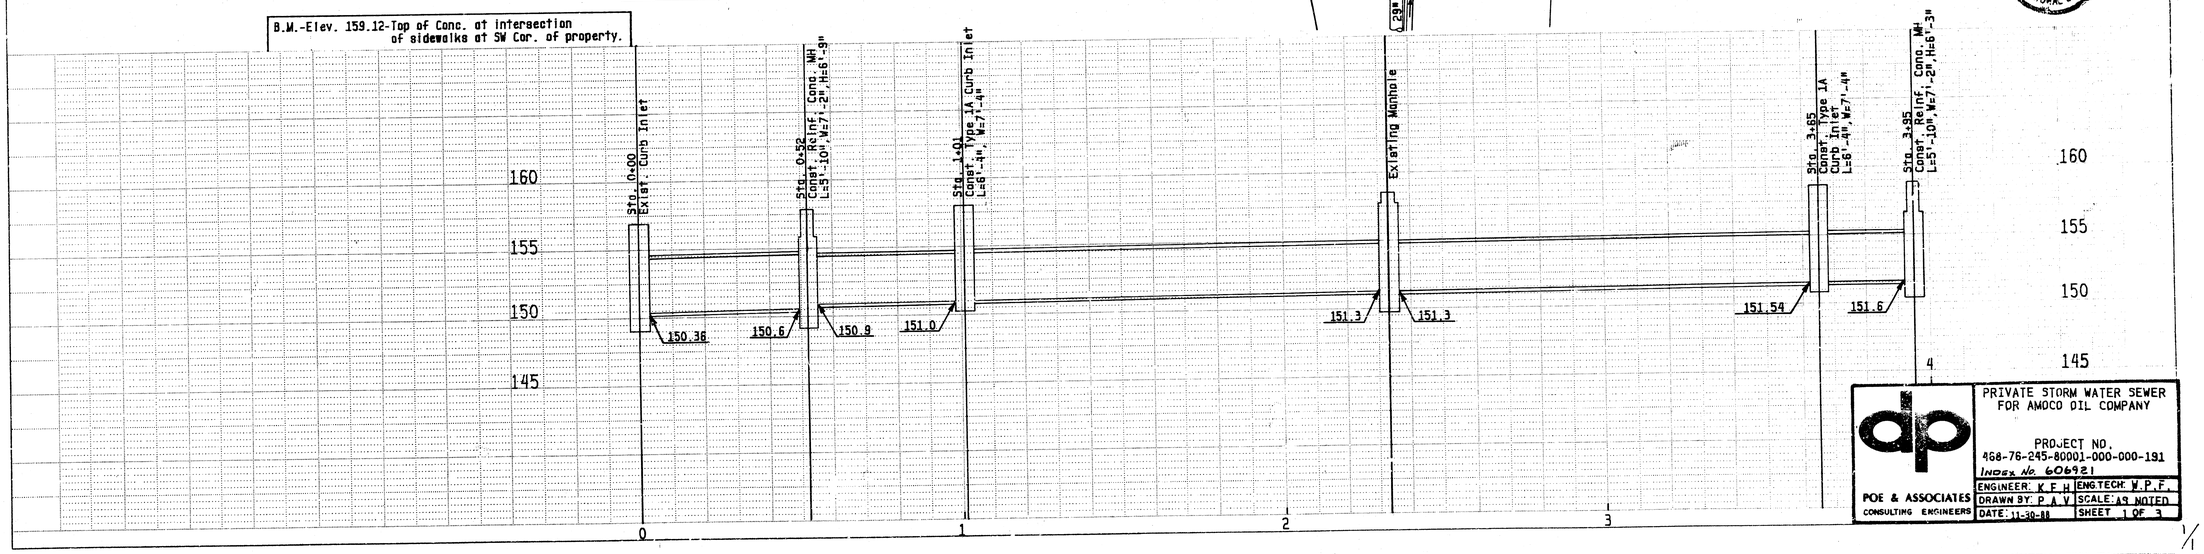

PLAN — NOTE BOOK NO. — SURVEYED — PLOTTED — ALIGNMENT CHECKED — RT. OF WAY CHECKED — BY — DATE

PROFILE — NOTE BOOK NO. — SURVEYED — PLOTTED — GRADES CHECKED — B.M.'s NOTED — STRUCTURE NOTATNS CHKD — BY — DATE

POE & ASSOCIATES CONSULTING ENGINEERS	PRIVATE STORM WATER SEWER FOR AMOCO OIL COMPANY PROJECT NO. 468-76-245-80001-000-000-191 INDEX NO. 606921
ENGINEER: K.F.H.	ENG.TECH: W.P.F.
DRAWN BY: P.A.V.	SCALE: AS NOTED
DATE: 11-30-88	SHEET 1 OF 3

FILMED FROM THE BEST AVAILABLE COPY