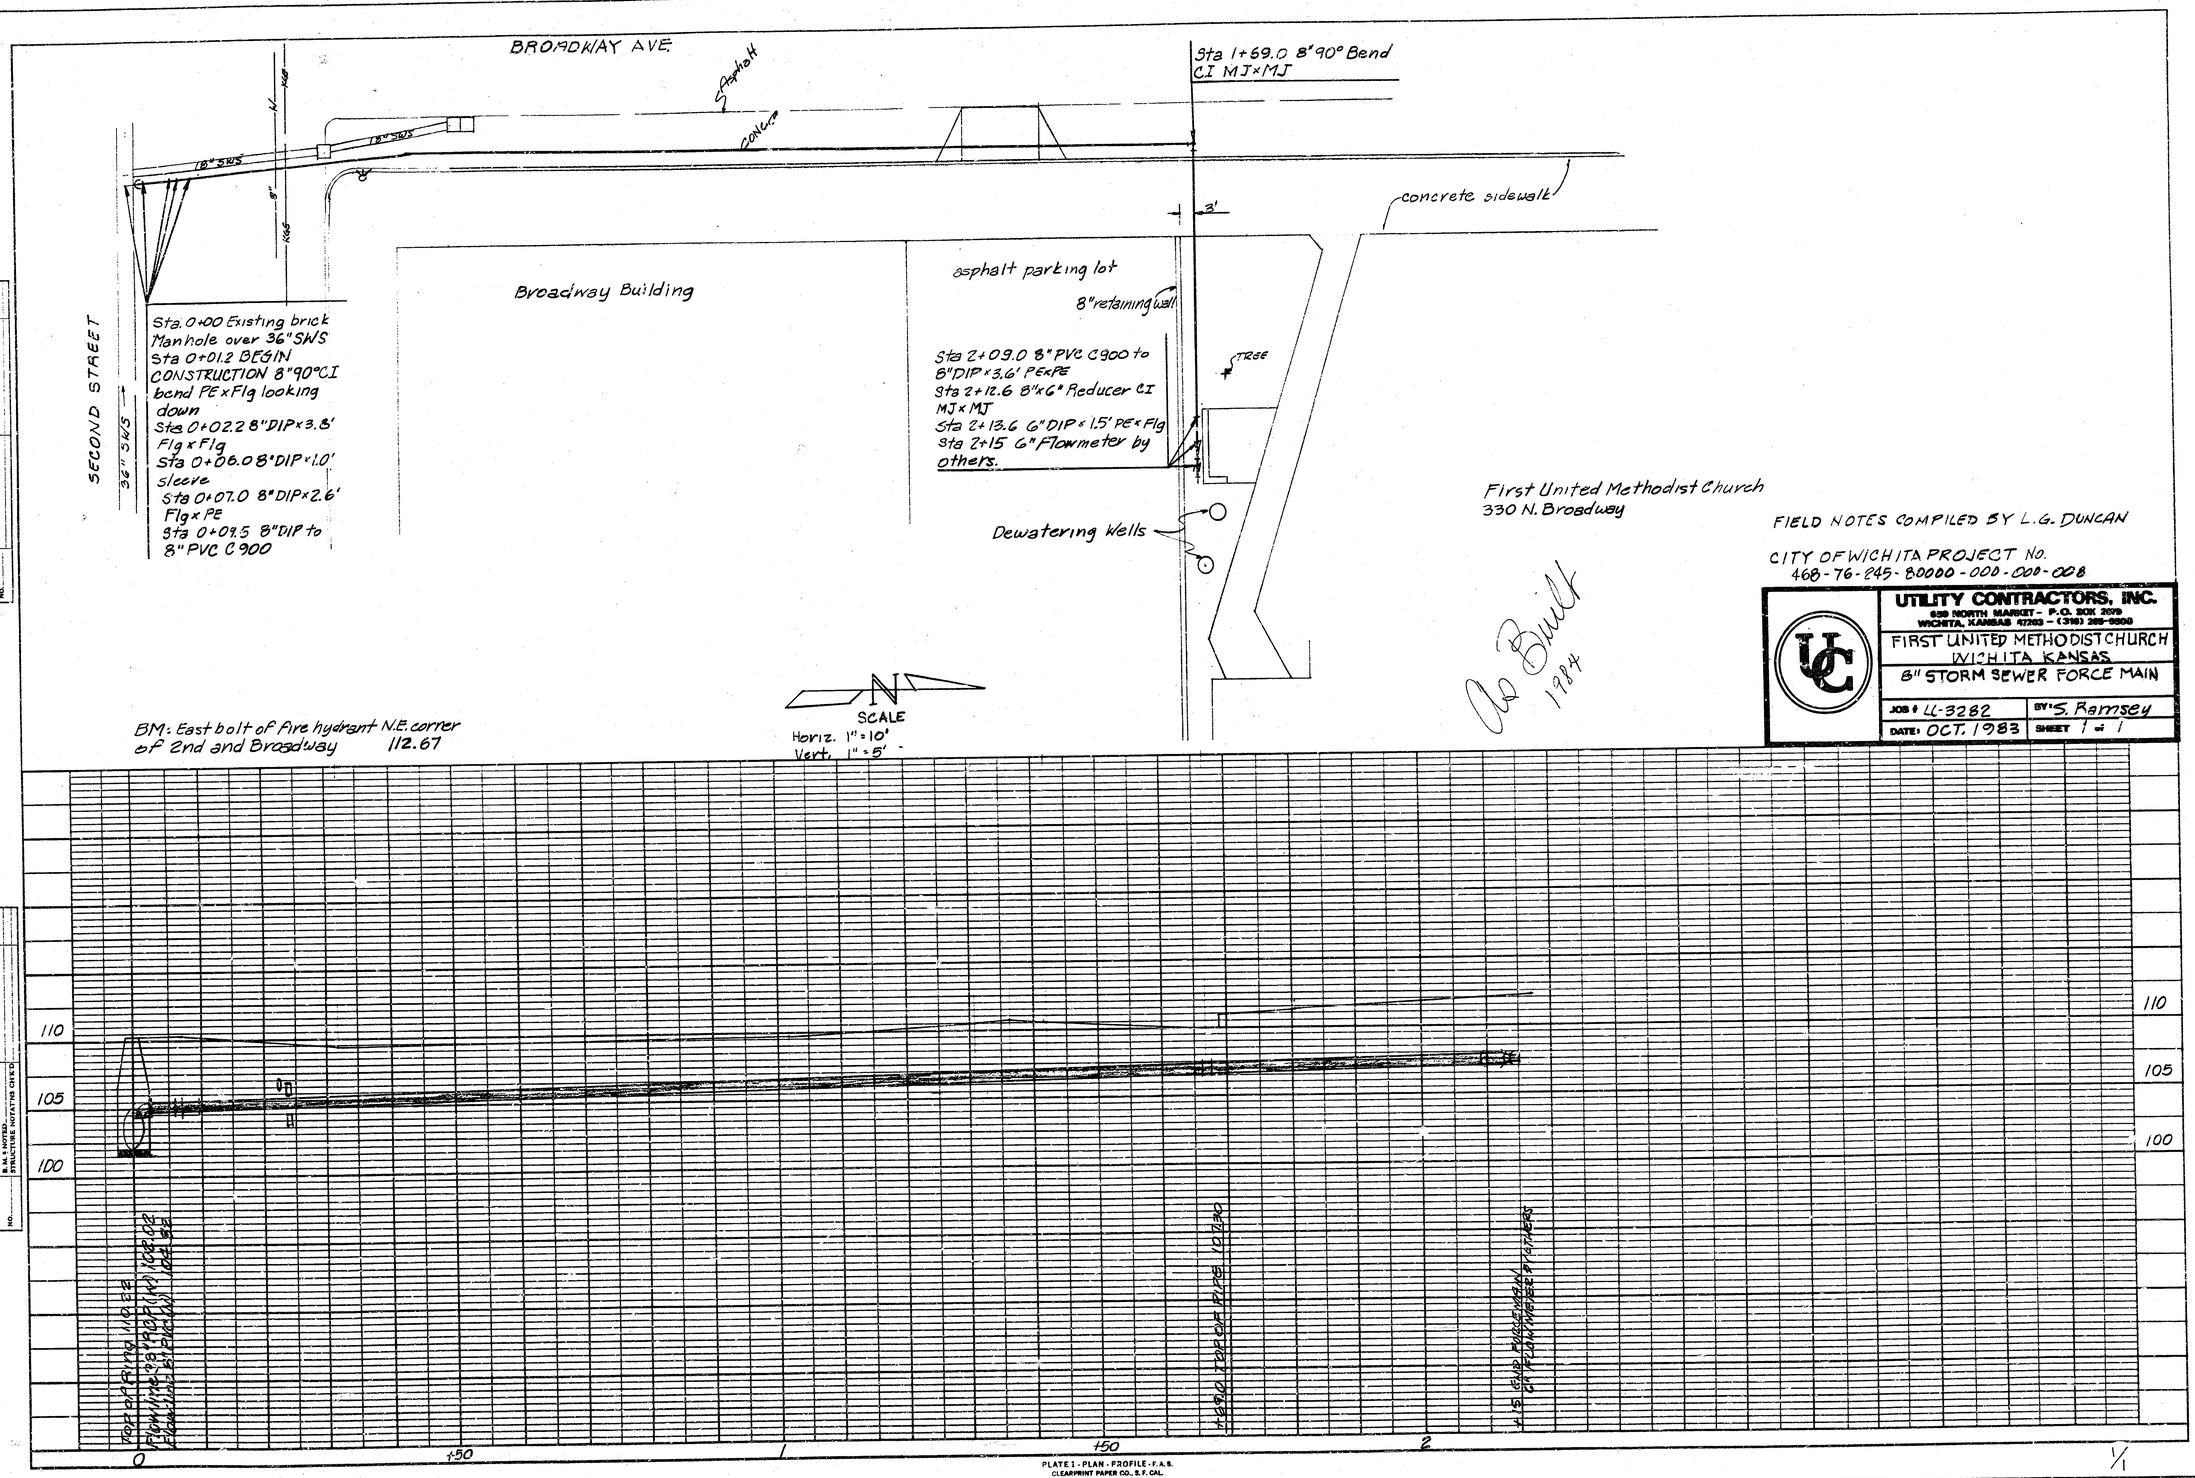

FIELD NOTES COMPILED BY L.G. DUNCAN

CITY OF WICHITA PROJECT No.
468-76-245-80000-000-000-008

UTILITY CONTRACTORS, INC.
650 NORTH MARKET - P.O. BOX 2079
WICHITA, KANSAS 47203 - (316) 265-9500

FIRST UNITED METHODIST CHURCH
WICHITA KANSAS
8" STORM SEWER FORCE MAIN

JOB # U-3282	BY: S. Ramsey
DATE: OCT. 1983	SHEET 1 of 1

PLAN — NOTE BOOK NO. — SURVEYED — PLOTTED — ALIGNMENT CHECKED — RT. OF WAY CHECKED — BY — DATE

PROFILE — NOTE BOOK NO. — SURVEYED — PLOTTED — GRADES CHECKED — B.M.'S NOTED — STRUCTURE NOTATNS CH'K'D — BY — DATE

FILMED FROM THE BEST