
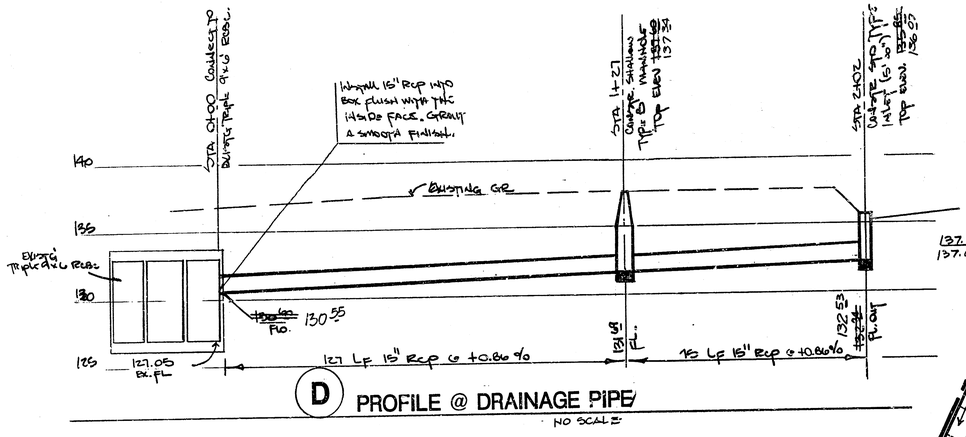



D PROFILE @ DRAINAGE PIPE

NO SCALE

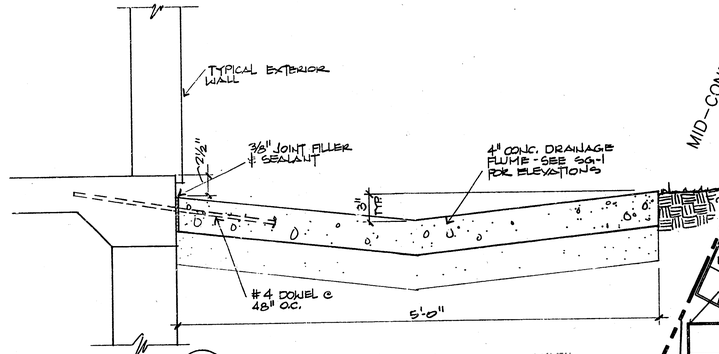

C SECTION THRU DRAINAGE FLUME

1½" = 1'-0"

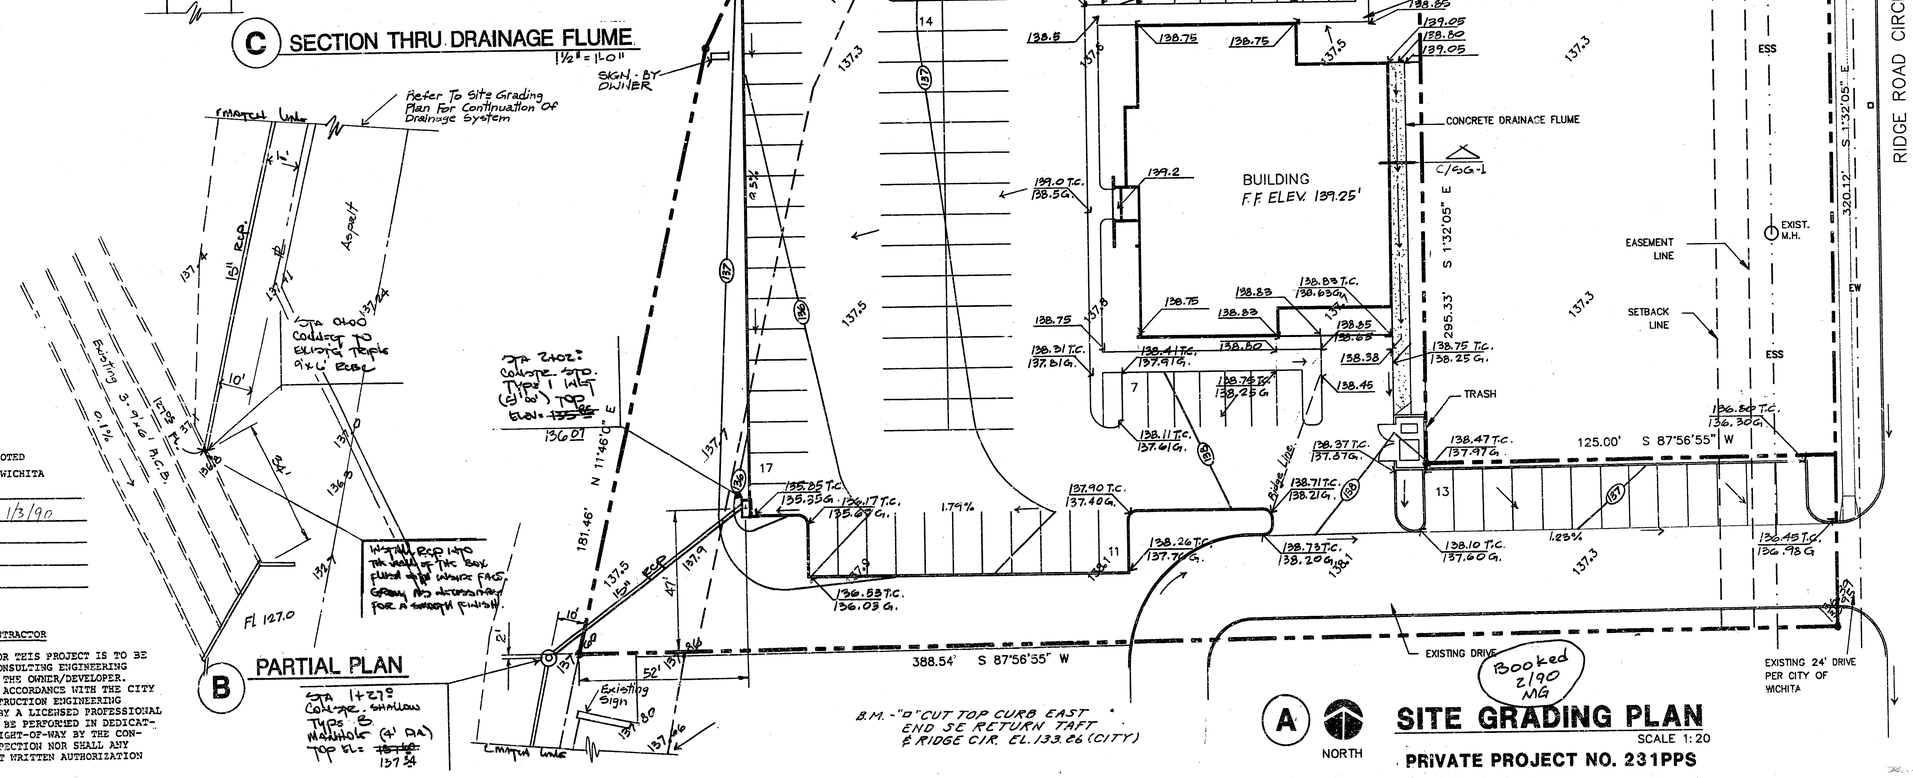

A NORTH

SITE GRADING PLAN

SCALE 1:20

PRIVATE PROJECT NO. 231PPS

B PARTIAL PLAN

STA 1+27 Connect Shallow Type B Manhole (4' DIA) TOP EL= 137.54

APPROVED AS NOTED
By CITY ENGINEER OF WICHITA

Sanitary Sewers _____
Storm Sewers VRH 1/3/90
Driveway Approaches _____
Water Mains _____
Paving _____

NOTE TO CONTRACTOR

INSPECTION AND TESTING FOR THIS PROJECT IS TO BE PROVIDED BY A LICENSED CONSULTING ENGINEERING FIRM UNDER CONTRACT WITH THE OWNER/DEVELOPER. SAID INSPECTION TO BE IN ACCORDANCE WITH THE CITY OF WICHITA STANDARD CONSTRUCTION ENGINEERING PRACTICES AND CERTIFIED BY A LICENSED PROFESSIONAL ENGINEER. NO WORK SHALL BE PERFORMED IN DEDICATED EASEMENTS OR PUBLIC RIGHT-OF-WAY BY THE CONTRACTOR WITHOUT SUCH INSPECTION NOR SHALL ANY WORK BE COMMENCED WITHOUT WRITTEN AUTHORIZATION BY THE CITY ENGINEER.

N. BRENT WOOTEN LICENSED 0470 M.A.N.S.A. PROFESSIONAL ENGINEER

LEGEND

137.5	EXISTING SPOT ELEVATION
138	NEW CONTOUR
137.65	NEW SPOT ELEVATION
138.71 T.C.	TOP OF CURB ELEVATION
138.21 G.	GUTTER ELEVATION

prints issued
FOR BIDDING 11-15-89

revisions
Revised as built (Baughman Co).
TCR 1-25-90

date drawn

JEFF KREHBIEL ASSOCIATES, aia
architecture - planning
1300 east lewis wichita, kansas 67211
(316) 267-8233

CARLOS O'KELLY'S
527 S. RIDGE RD. CIRCLE
WICHITA, KS.

sheet title
SITE GRADING

sheet
SG-1
of ONE sheets