LEGEND


▨	REMOVE & REPLACE ASPHALT PAVEMENT
— — G — —	EX. GAS LINE
— — W — —	EX. WATER LINE
— — SWS — —	EX. STORM WTR. SEWER

NOTES:

1. CONTRACTOR TO VERIFY LOCATION AND ELEVATION OF EXISTING STORM WATER SEWER LINE AND OTHER EXISTING UTILITY LINES PRIOR TO CONSTRUCTION OF NEW STORM WATER SEWER LINE.
2. CONTRACTOR TO CONTACT PROJECT ARCHITECT PRIOR TO INSTALLATION OF STUB FOR FUTURE STORM WATER SEWER LINE. REFER TO "CITY OF WICHITA" DETAILS AND SPEC. FOR PLUGGING OF STUB.
3. CONTRACTOR TO COORDINATE WITH "CITY OF WICHITA" TO REMOVE AND REPLACE EXISTING PAVEMENT WITHIN WINDSOR STREET RIGHT-OF-WAY.
4. ALL CONSTRUCTION AND MATERIALS TO BE IN ACCORDANCE WITH "CITY OF WICHITA" STANDARDS AND SPECIFICATIONS.

NORTH

HORZ. 1" = 20'
VERT. 1" = 2'

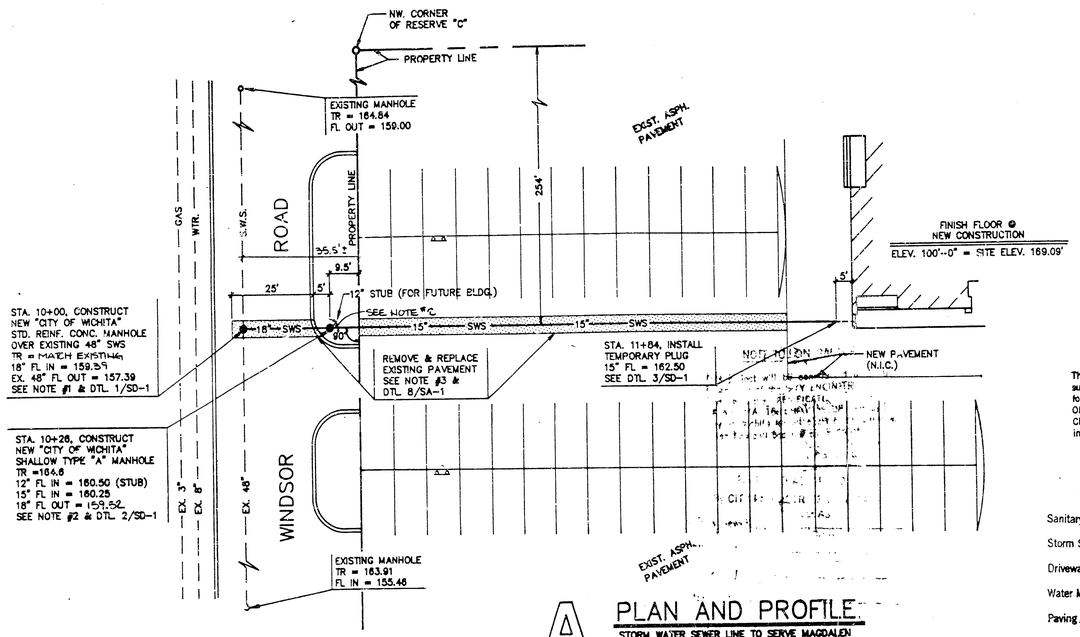

A PLAN AND PROFILE

STORM WATER SEWER LINE TO SERVE MAGDALEN SCHOOL FACILITY IN RESERVE "C" OF SOUTHEAST ADDITION TO THE VILLAGE, AN ADDITION TO WICHITA, SEDGWICK COUNTY, KANSAS
468-76-245-80001 000-000-104


NOTE TO CONTRACTOR

This project will be constructed under the supervision of the CITY ENGINEER and conforming to the SPECIFICATIONS of the CITY OF WICHITA. The CONTRACTOR will pay the City of Wichita for all costs of plan review, inspection and booking per contract.

APPROVED AS NOTED
By CITY ENGINEER OF WICHITA

Sanitary Sewers _____
Storm Sewers VRH 9/22/87
Driveway Approaches _____
Water Mains _____
Paving _____


BOOK 6D
6188
MCG

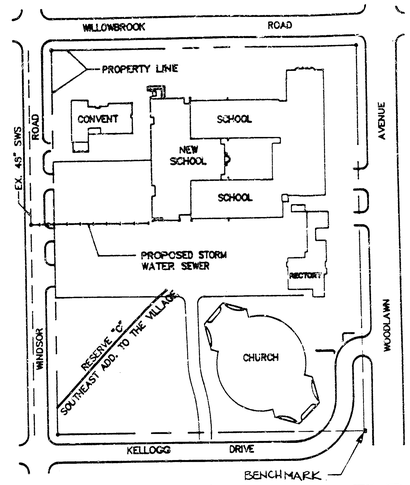

B VICINITY MAP

1" = 100'

BENCH MARK:
ELEVATION = 163.83
"□" CUT IN SIDEWALK @ S.E. CORNER OF RESERVE "C", SOUTHEAST ADDITION TO THE VILLAGE, AN ADDITION TO WICHITA, SEDGWICK COUNTY, KANSAS.

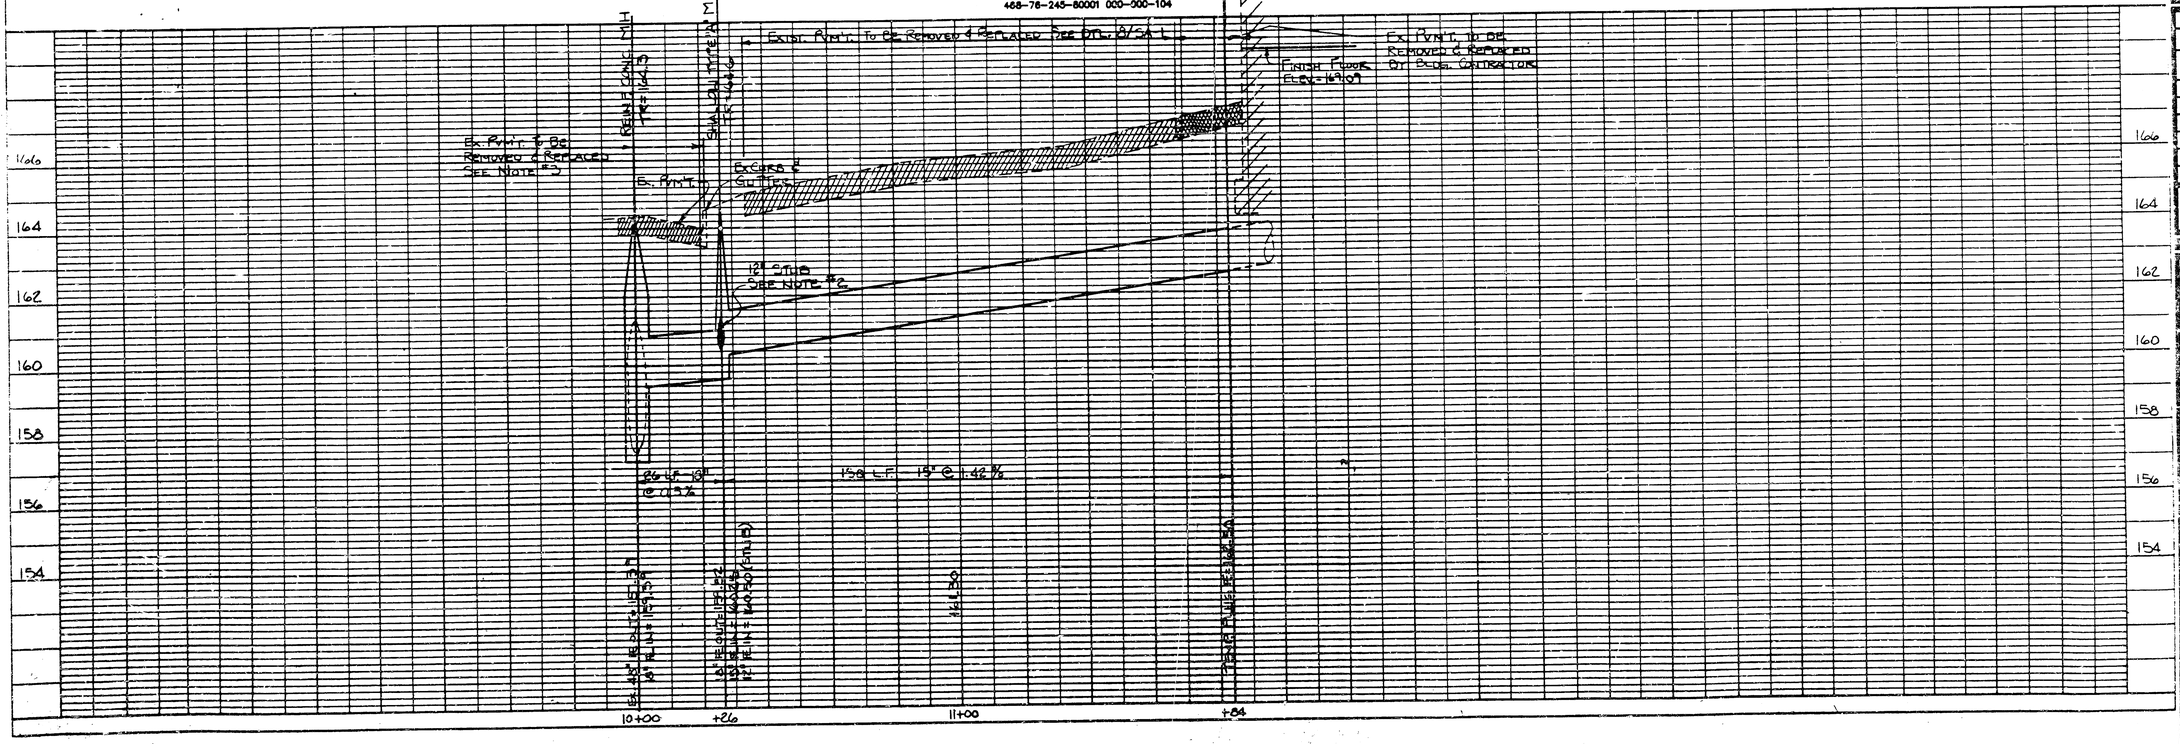

REVISIONS

DATE	ITEM

LAW / KINGDON, INC.
ARCHITECTS & ENGINEERS
348 RIVERVIEW, WICHITA, KANSAS
Phone (316) 265-2626 Dayphone (316) 686-

BEN J. KINGDON 1098 STATE OF KANSAS — REGISTERED ARCHITECT

ROBERT D. FRILSON LICENSED 6919 KANSAS PROFESSIONAL ENGINEER

DRAWN	CHECKED
DPJ	RDF

RELATED DRAWINGS

SHELL	
DETAILS	
STRUCTURE	
MECHANICAL	
ELECTRICAL	
OTHER	

SEQUENCE NUMBER
7 OF 14 SHTS

ADDITION AND RENOVATION
THE CHURCH OF THE MAGDALEN
SCHOOL FACILITY WICHITA, KANSAS
PROJECT NUMBER 7619

KEY PLAN

468-76-245-80001-000-000

STORM WATER SEWER
PLAN AND PROFILE
SHEET TITLE

SHEET NUMBER
SU-1
OF

FILMED FROM THE BEST AVAILABLE COPY....