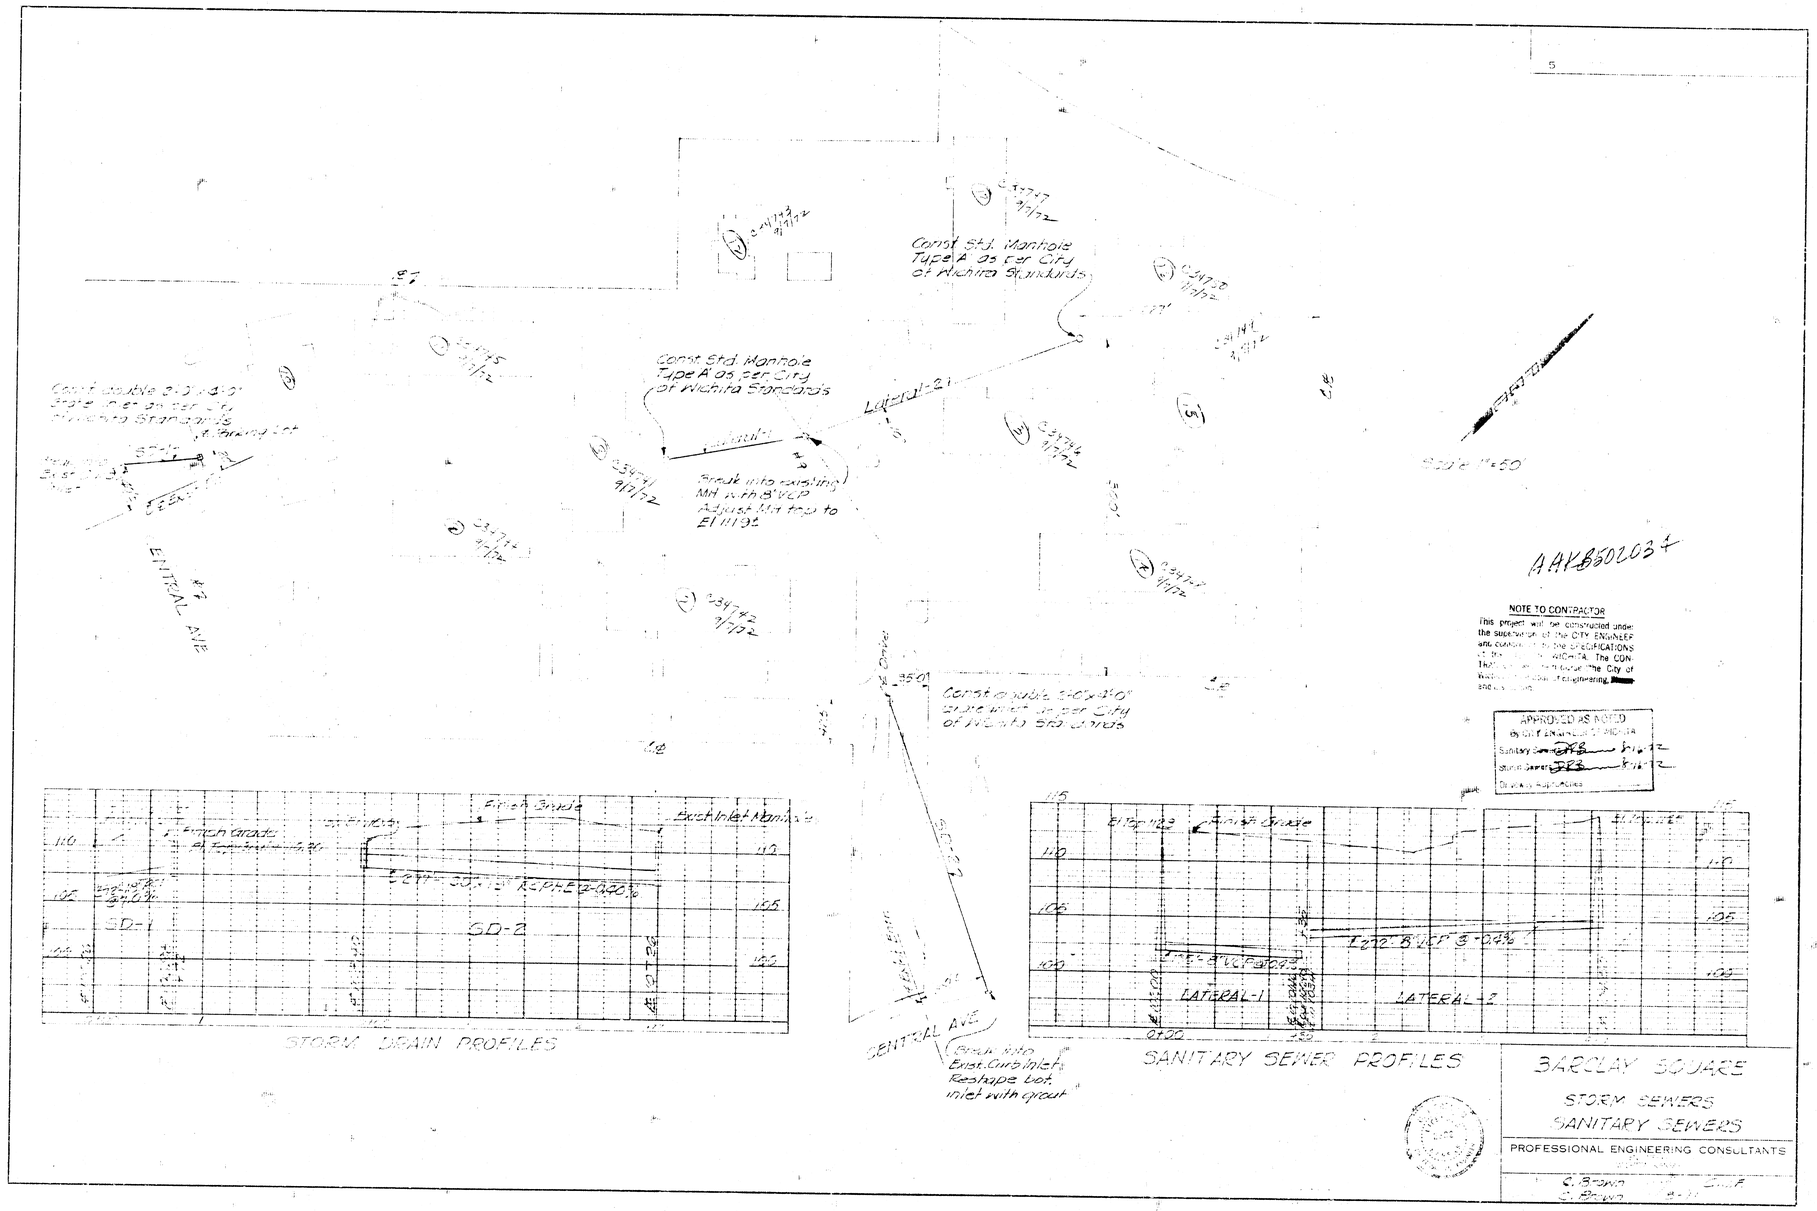
Const Std. Manhole Type A as per City of Wichita Standards
Const Std. Manhole Type A as per City of Wichita Standards
Scale 1"=60'
CENTRAL AVE
Const double 30"x30" Single inlet as per City of Wichita Std details
Break into Exist. Curb Inlet Reshape bot. inlet with grout
Finish Grade
Exist Inlet
SD-1
SD-2
STORM DRAIN PROFILES
LATERAL-1
LATERAL-2
SANITARY SEWER PROFILES
AAKB502037
NOTE TO CONTRACTOR
This project will be constructed under the supervision of the CITY ENGINEER who conforms to the SPECIFICATIONS of the CITY OF WICHITA. The CONTRACTOR shall notify the City of Wichita Department of Engineering
APPROVED AS NOTED
BARCLAY SQUARE
STORM SEWERS
SANITARY SEWERS
PROFESSIONAL ENGINEERING CONSULTANTS