BENCHMARKS:

City Disc Located in Island at Northeast Corner of Maize Road and Central.

Elevation = 146.00 (City Datum)

"T" Cut in Top of Curb on West Side of Maize Road Between Lots 2 & 3, Block 1, Toh-N-Hah Village.

Elevation = 151.29 (City Datum)

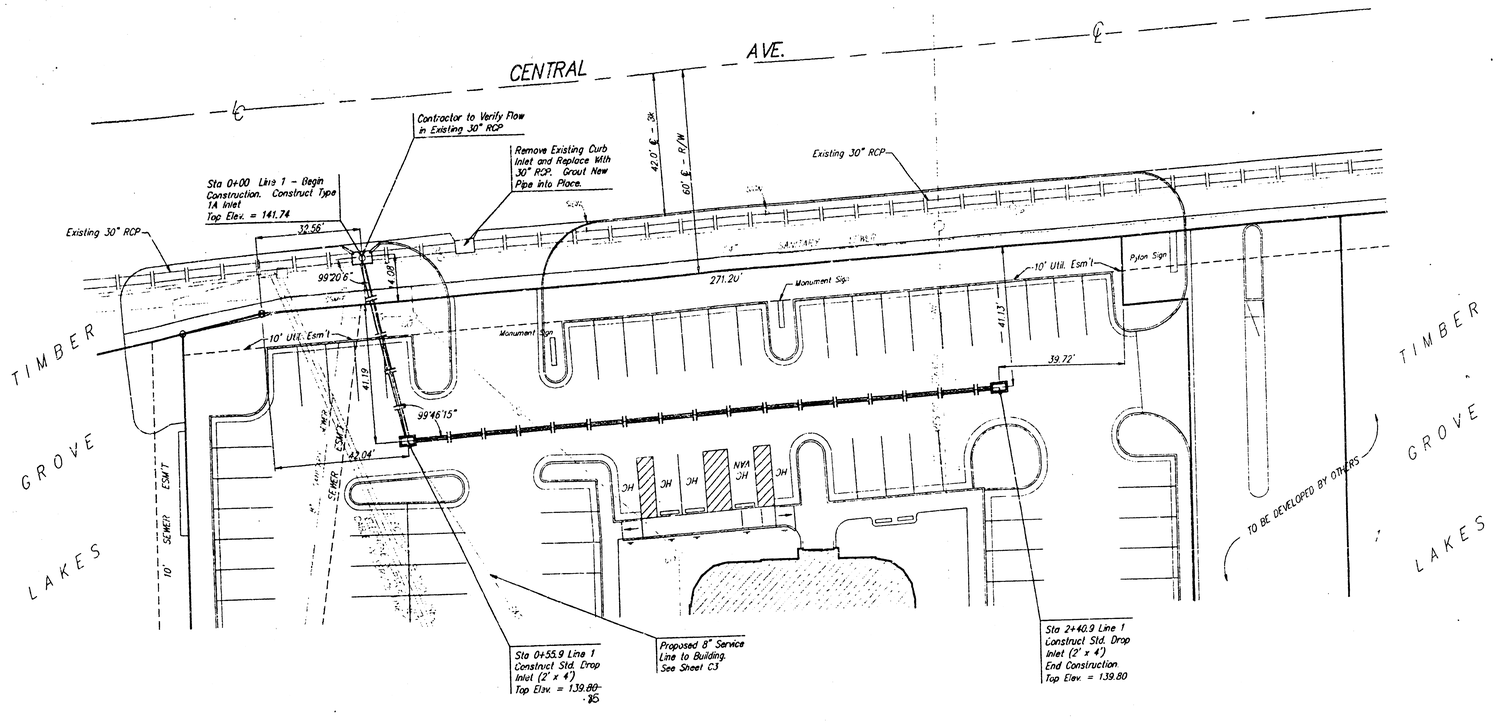

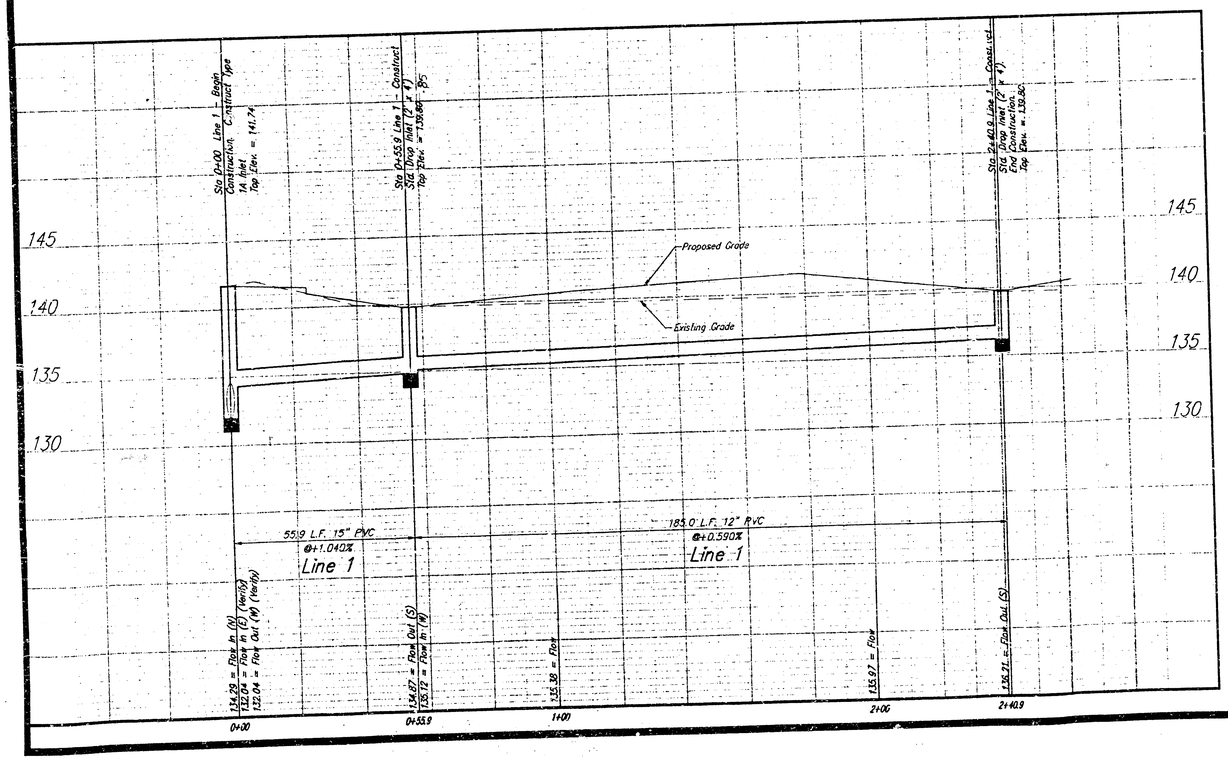

TRUE NORTH

C4 STORM SEWER IMPROVEMENTS

HORIZONTAL: 1" = 20'-0"
VERTICAL: 1" = 5'-0"

CITY OF WICHITA, KANSAS
PRIVATE PROJECT NO. – 471 PPS (607861)
CITY ENGINEER – MICHAEL LINDEBAK

As Built 10-28-94

BOOKED 3-23-95 MEG

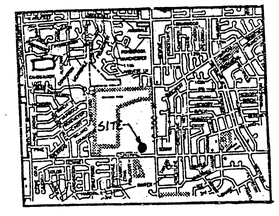

TRUE NORTH

LOCATION MAP

APPROVED AS NOTED
BY CITY ENGINEER OF WICHITA

Sanitary Sewers _____
Storm Sewers VRH 6/22/94
Driveway Approaches _____
Water Mains _____
Paving _____

NOTE TO CONTRACTORS

Inspection and testing for this project is to be provided by a Licensed Consulting Engineering Firm under contract with the Owner/Developer. Said inspection to be in accordance with the City of Wichita standard construction engineering practices and certified by a Licensed Professional Engineer. No work shall be performed in dedicated easements or public right-of-way by the Contractor without such inspection nor shall any work be commenced without written authorization by the City Engineer. All Construction and Materials shall comply with the City of Wichita Specifications and Standards (on file and available in the City Engineer's Office).

NO.	DATE	REVISIONS	BY

© DATE OF THIS PRINTING

BAUGHMAN COMPANY, P.A.
ENGINEERING & SURVEYING
316-262-1271 • 310 EAST DOUGLAS • WICHITA, KANSAS 67201

CONTRACTOR SHALL VERIFY ALL CONDITIONS AND DIMENSIONS AT THE JOB SITE AND NOTIFY THE ARCHITECTS OF ANY DIMENSIONAL ERRORS, OMISSIONS OR DISCREPANCIES BEFORE BEGINNING OR FABRICATING ANY WORK. DO NOT SCALE DRAWINGS

BRENT WOOTTON LICENSED KANSAS PROFESSIONAL ENGINEER 10470

DAVID SCOTT WINDLE, AIA
10015 Technology Blvd West Suite 151 Dallas Texas 75220 4439
214/351-5490 Fax 214/501-0065
Architecture Interiors Food Service Design

WEST WICHITA, KS (CHANGELIST #9 INCLUDED)

chili's GRILL & BAR

JOB NUMBER 94034.00

SHEET NUMBER C4 OF SHEETS

DATE OF ORIGINAL ISSUE 22 JUNE 1994