


STORM SEWER PLAN

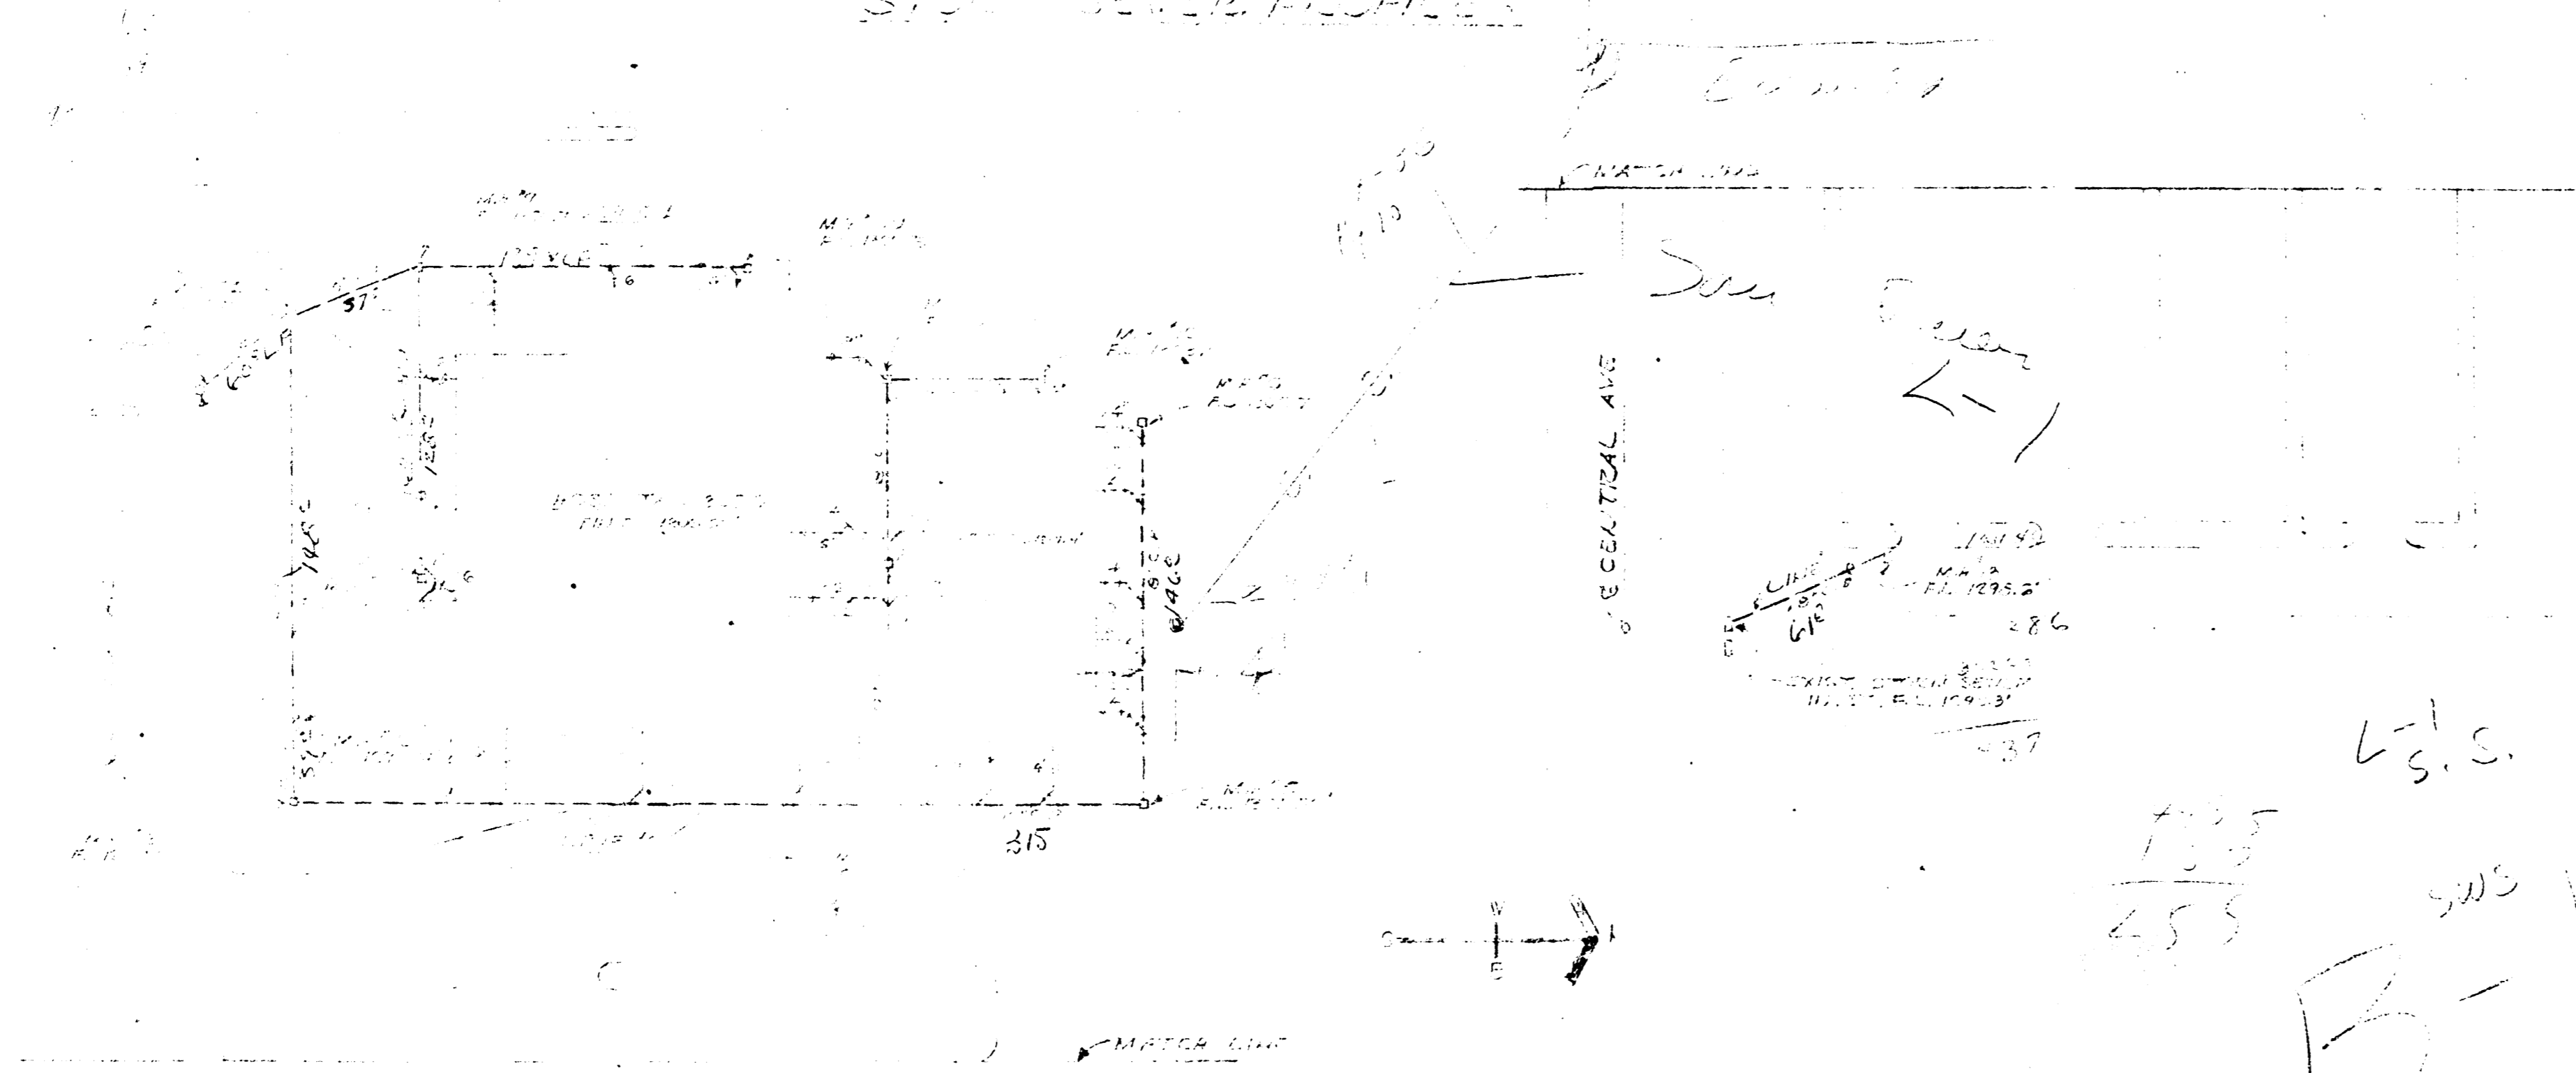

STORM SEWER PLAN
SCALE 1/8" = 1'-0"


Handwritten notes and signatures:
 L.S.S.
 12-1-65
 B-105
 SWS
 12-1-65

RAY D. EARNE ARCHITECTS & ENGINEERS
 FRED BURKORD & ASSOCIATES ARCHITECTS & ENGINEERS

A HOSPITAL BUILDING
 FOR THE CITY OF WICHITA
 HOSPITAL OF WICHITA
 WICHITA, KANSAS

JOB NO. 510
 DRAWN BY: [Signature]
 DATE: 12-1-65
 CHECKED BY: [Signature]
 SCALE: AS SHOWN

SHEET NO. 12 OF 20