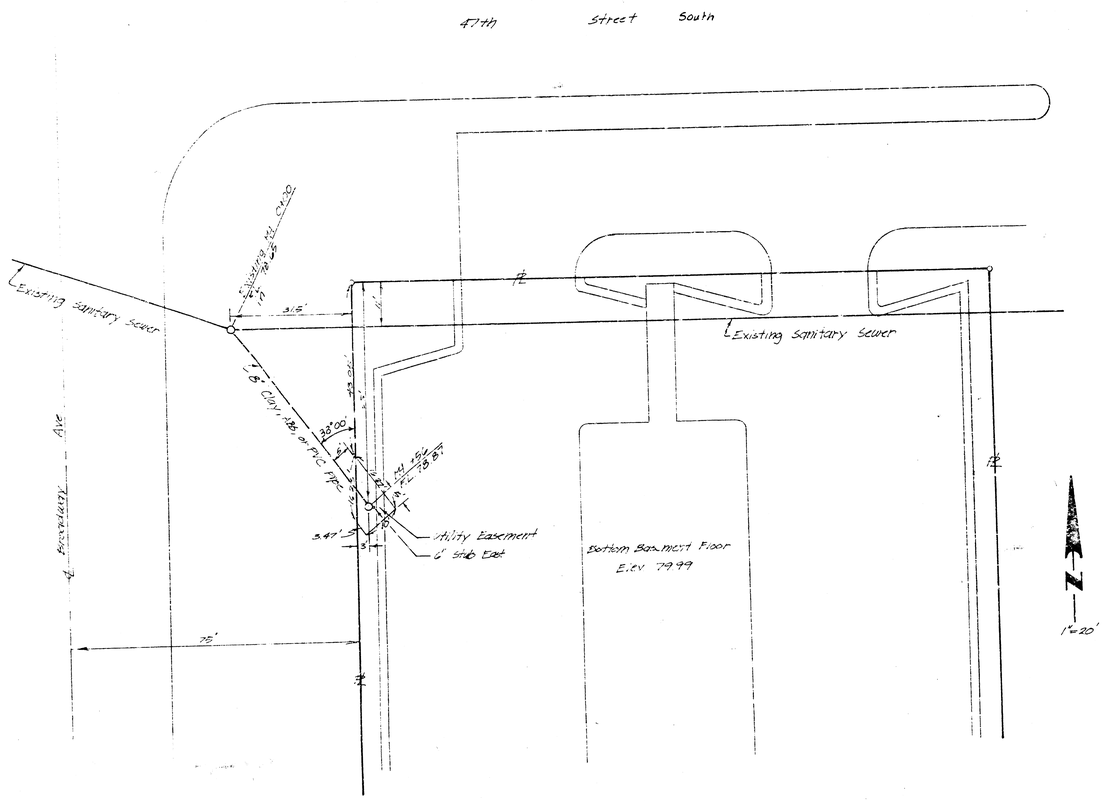



PROJECT NO. DBKW707028

6-20-77

APPROVED AS NOTED
By CITY ENGINEER
Sanitary Sewers
Storm Sewers
Driveway Approaches

NOTE TO CONTRACTOR

This project will be constructed under the supervision of the CITY ENGINEER and conforming to the SPECIFICATIONS of the City OF WICHITA. The CONTRACTOR will reimburse the City of Wichita for all cost of Engineering Services, inspection

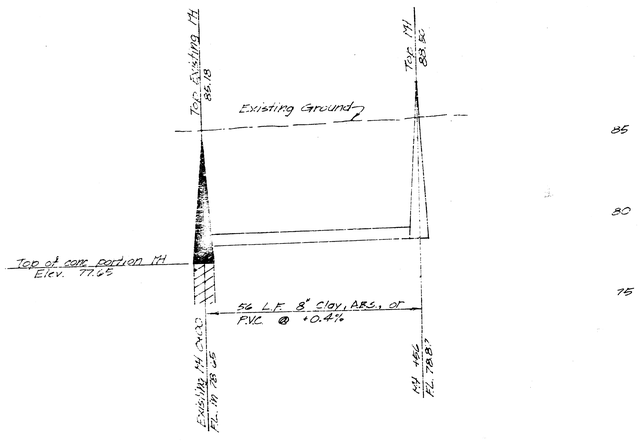

Sanitary Sewer

McDonald's Lease in Nolan's Gardens, Sedgwick County, Kansas.

K.D. Taylor, P.E.
May 27, 1977

KENNETH D. TAYLOR
REGISTERED
1038
KANSAS
PROFESSIONAL ENGINEER