 


SCALE 1"=50'	DES. BY	DW BY JP	CH BY	APP BY
		DATE 7/7/54	JOB NO.	
		DWG NO 54-15		