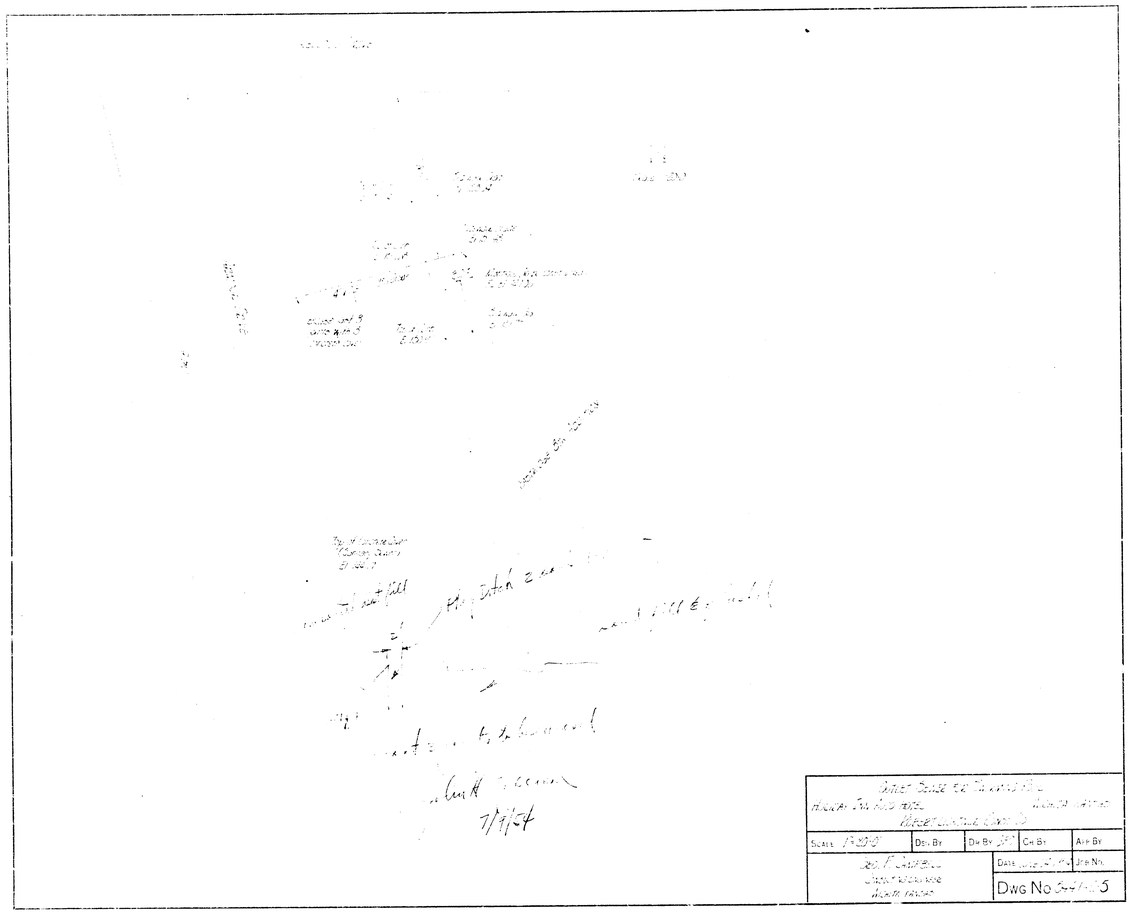

Scale	Des. By	Dr. By	Ch. By	Apr. By
		Date	Job No.	
		Dwg No		