


K-31

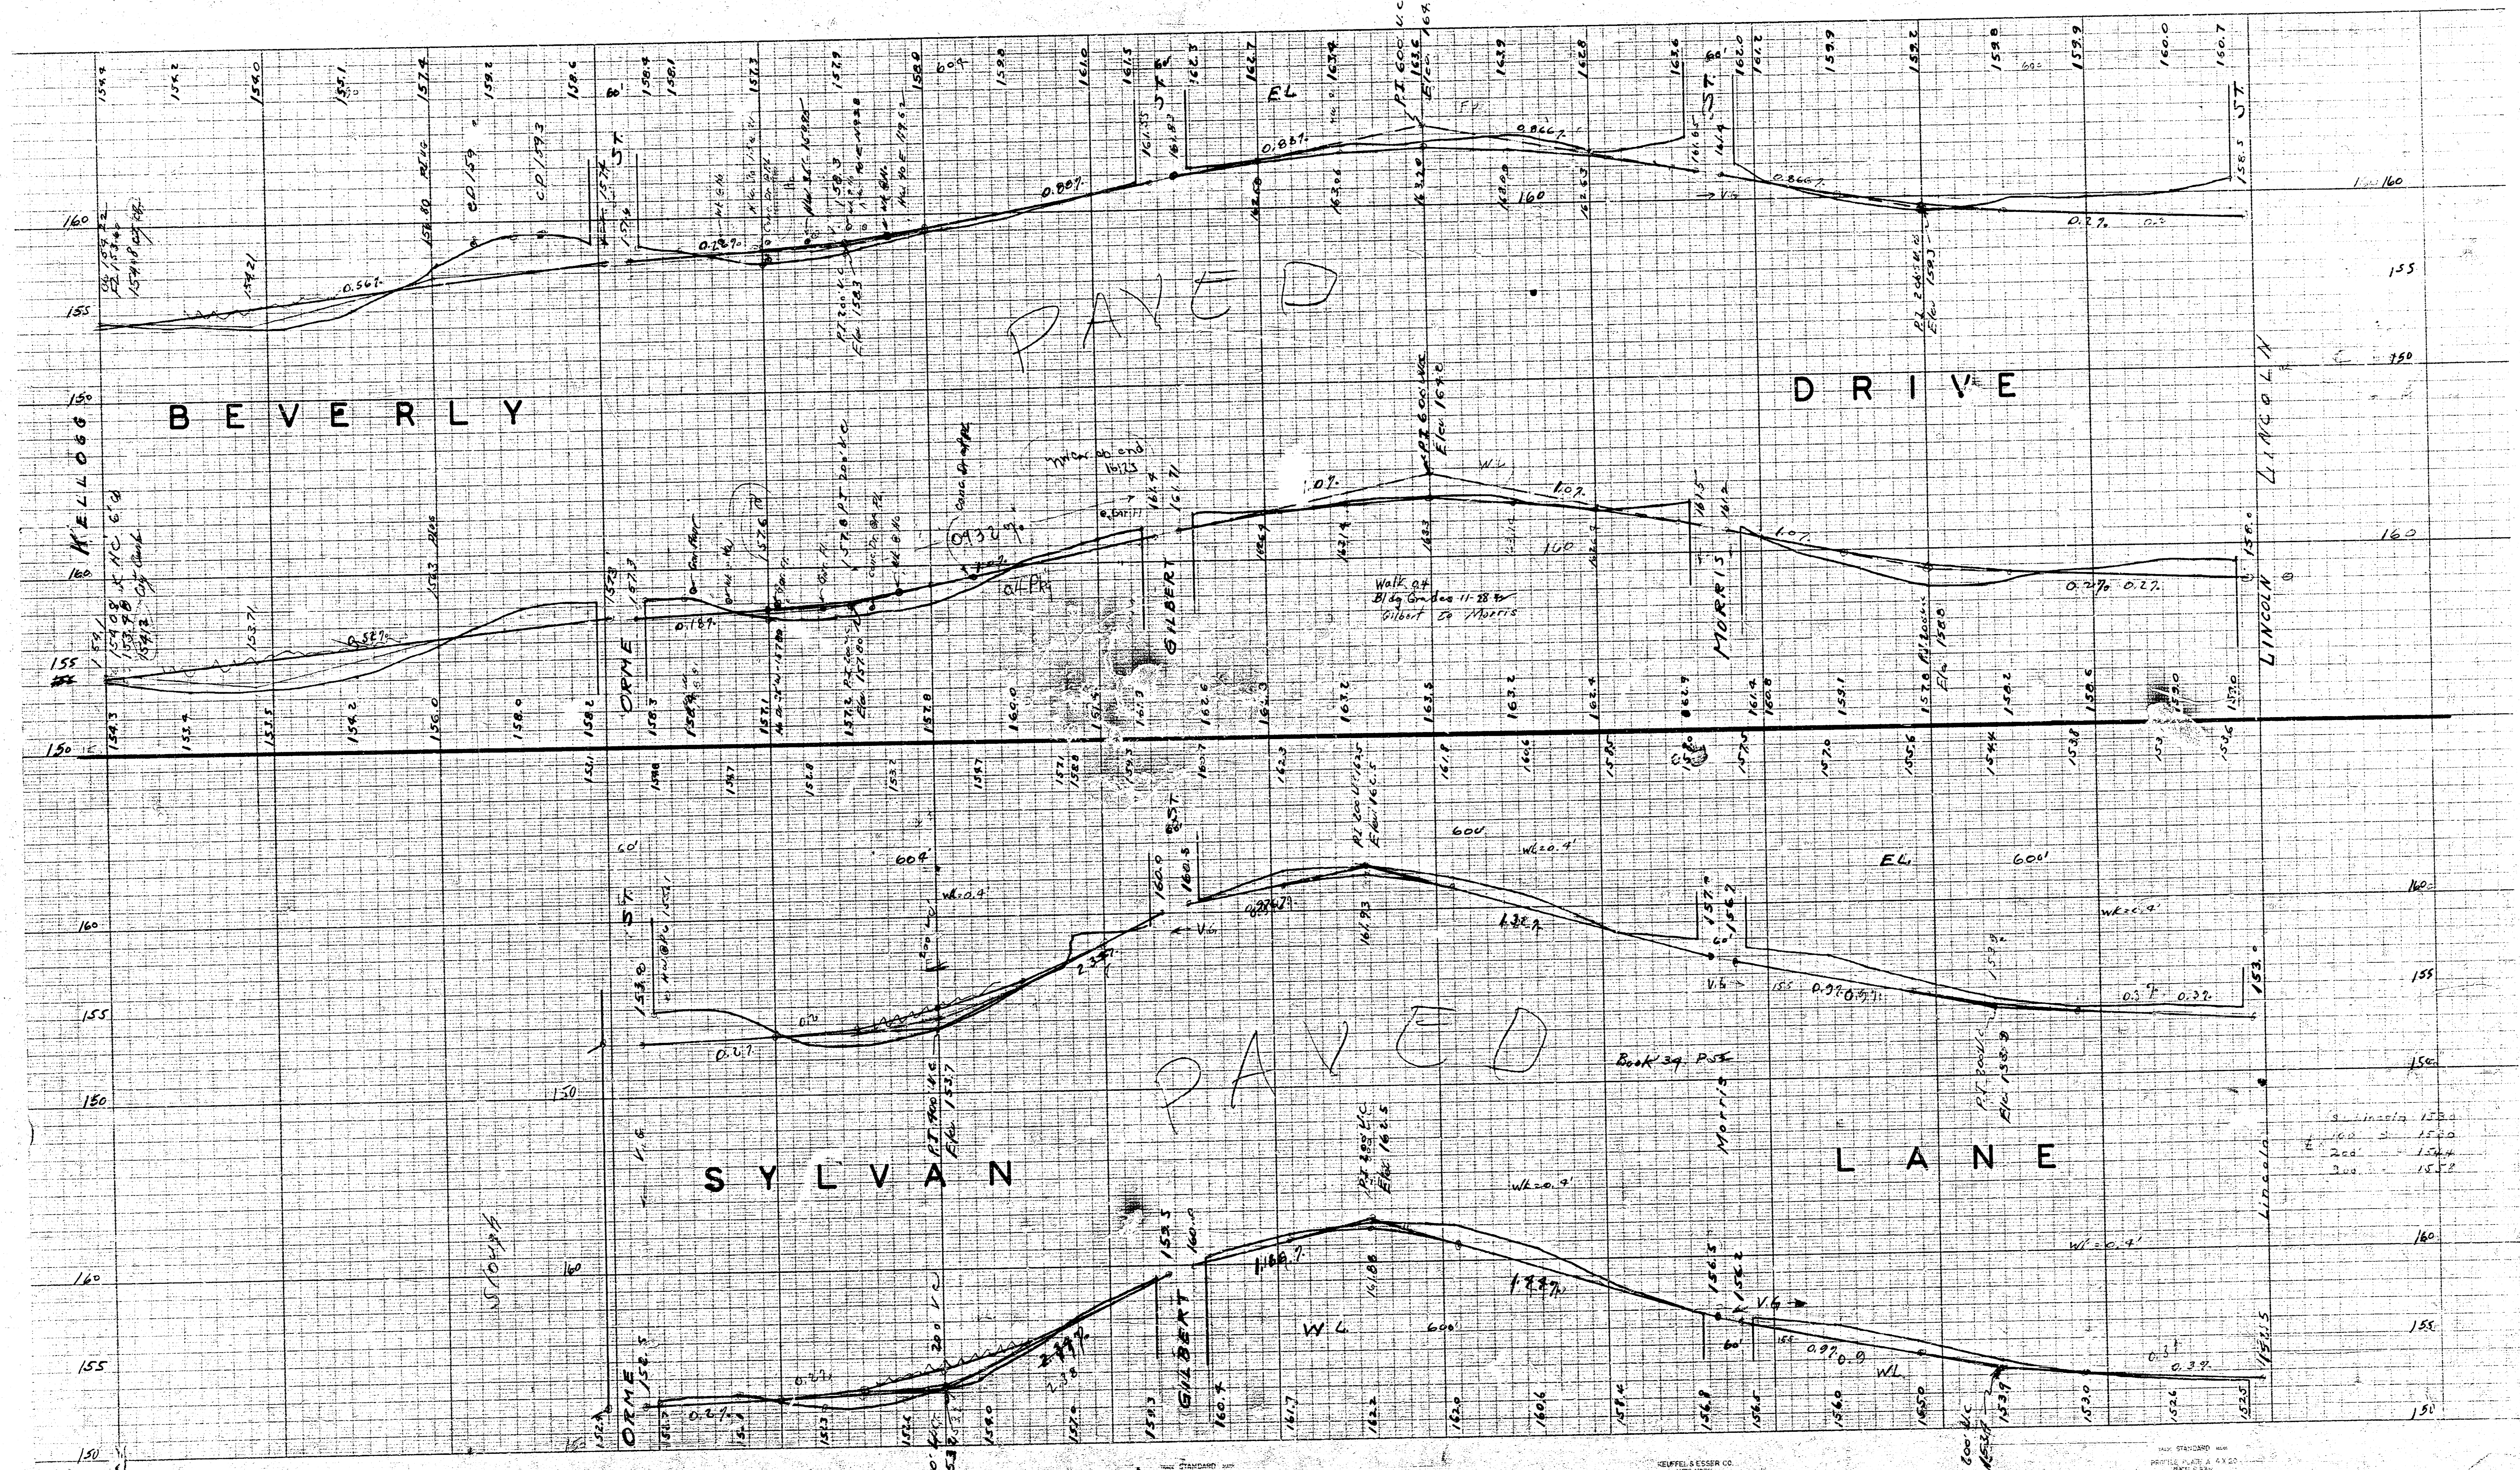

13-Y





