


15-5

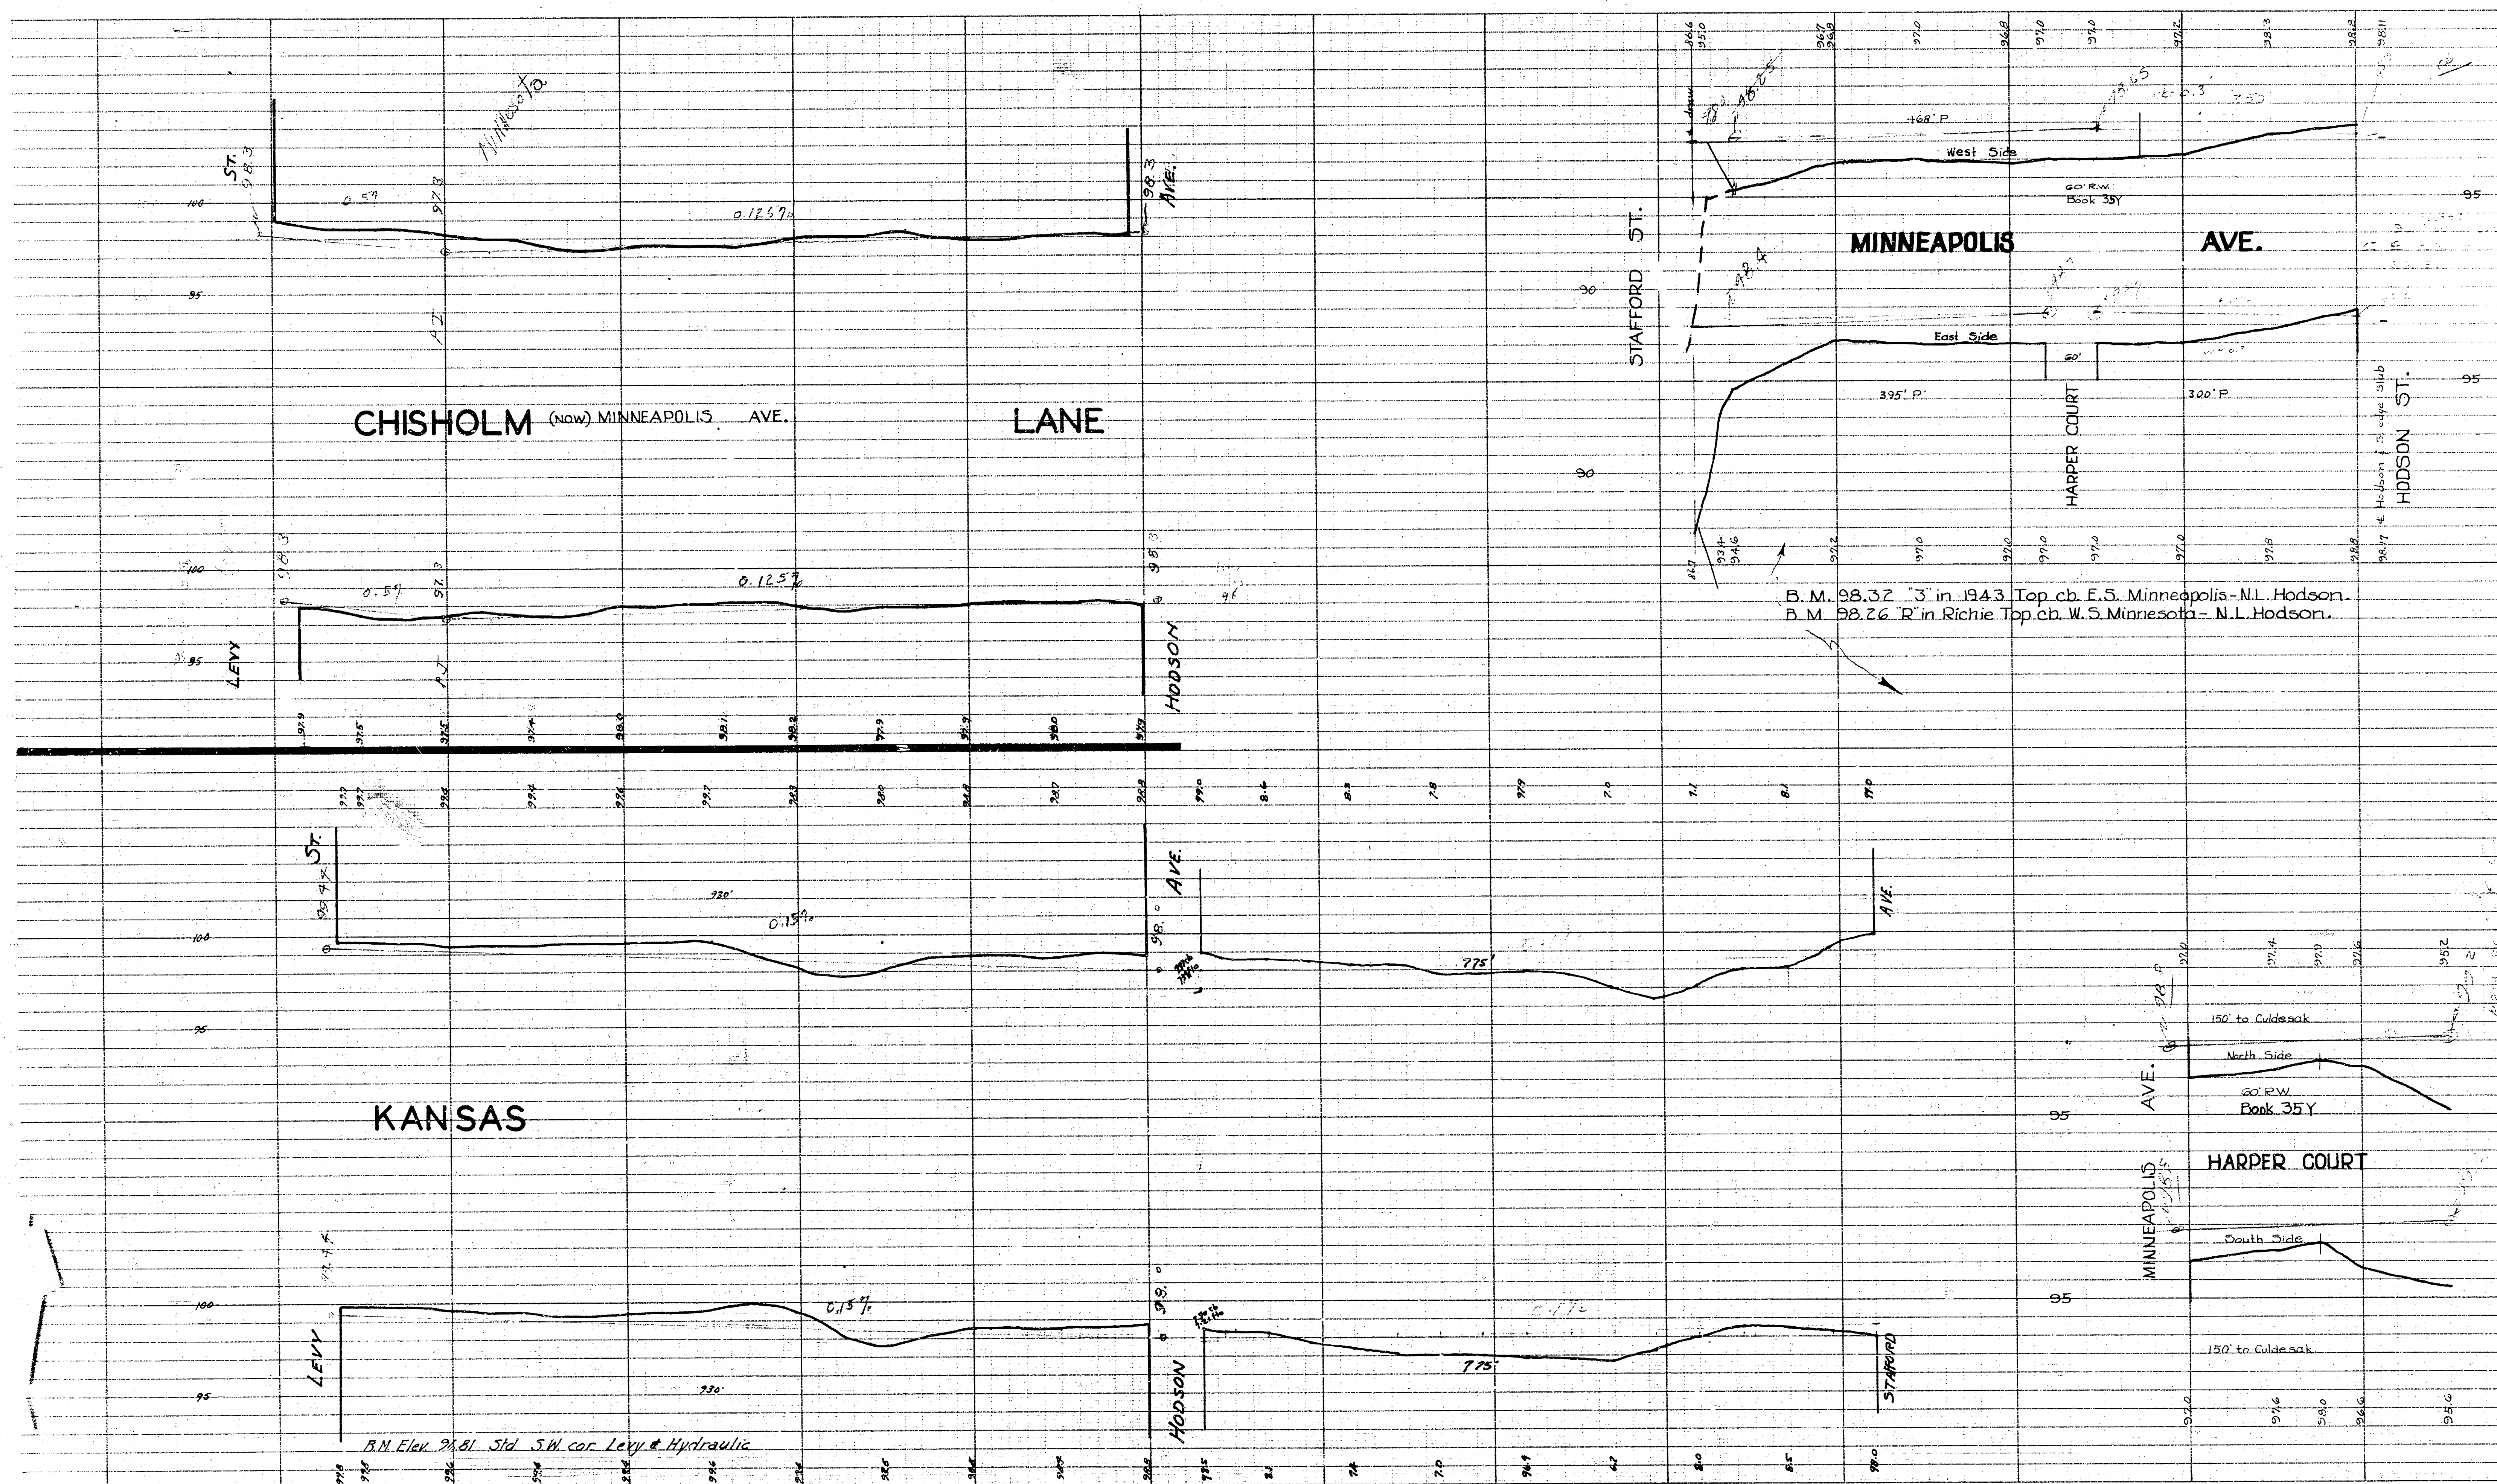

15-5

ST. PROFILE
3-13-24

3-13-24