


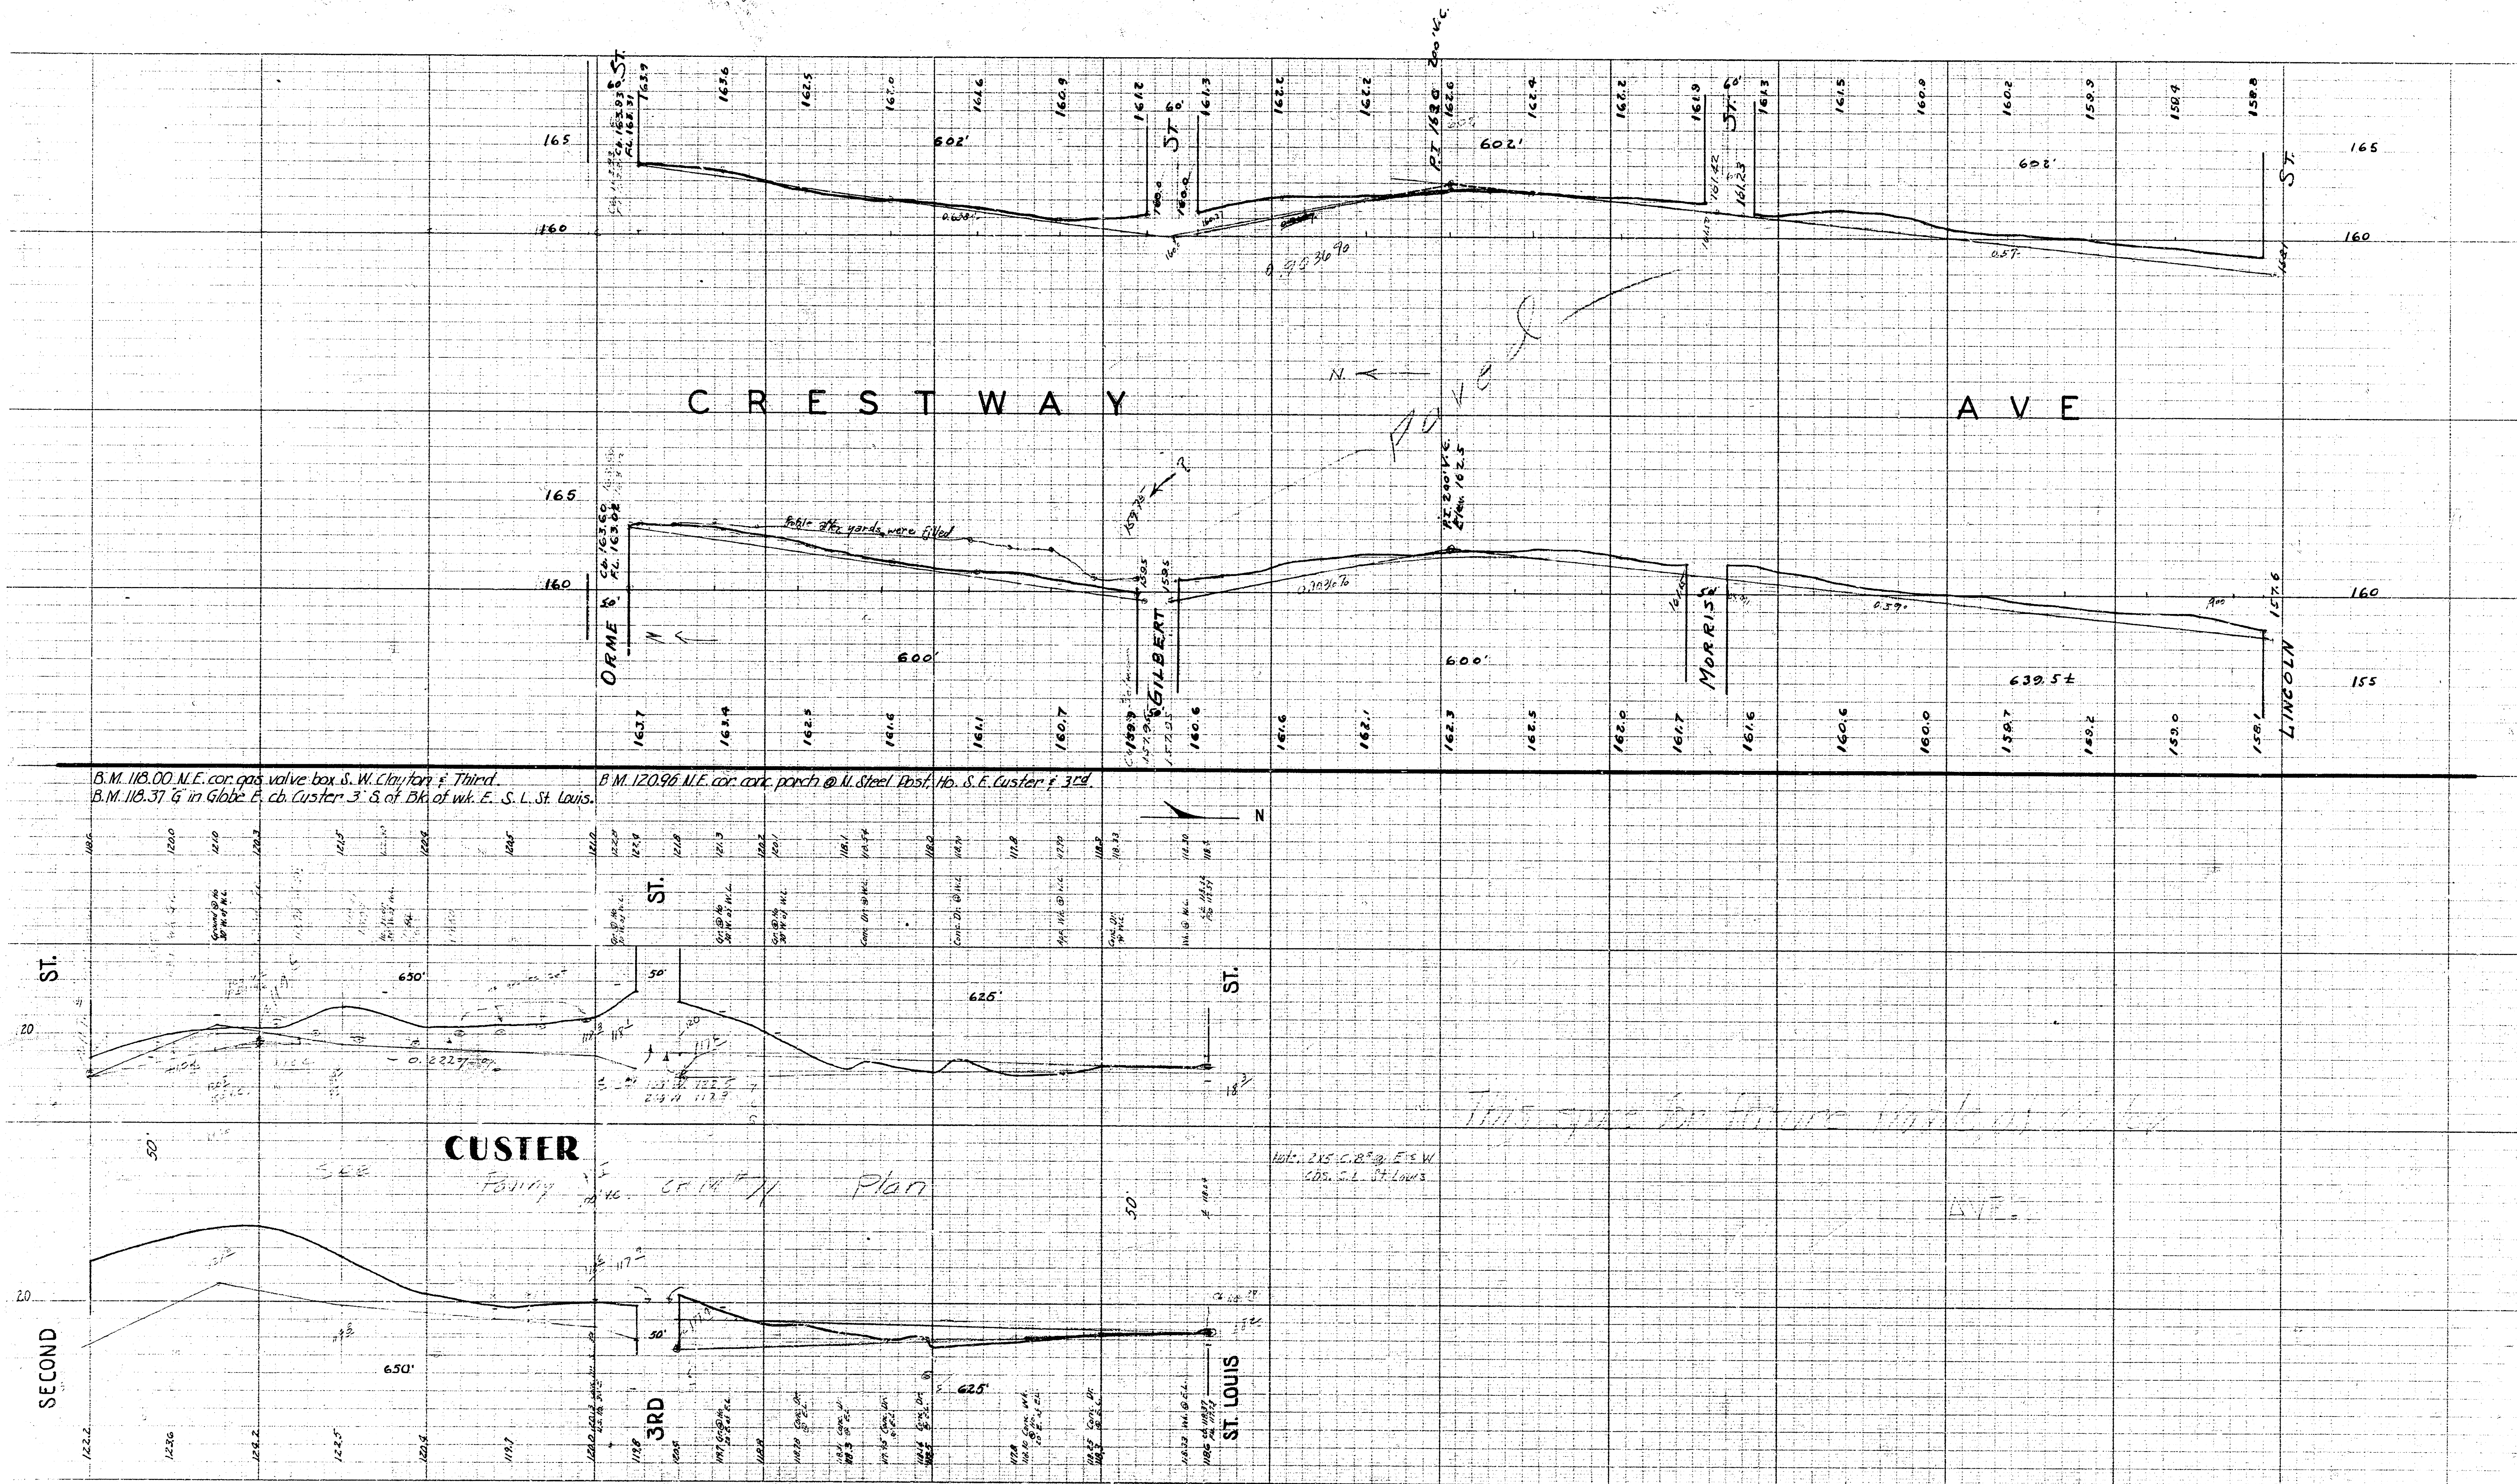

25-0

STANLEY & SINGER CO.
NEW YORK



