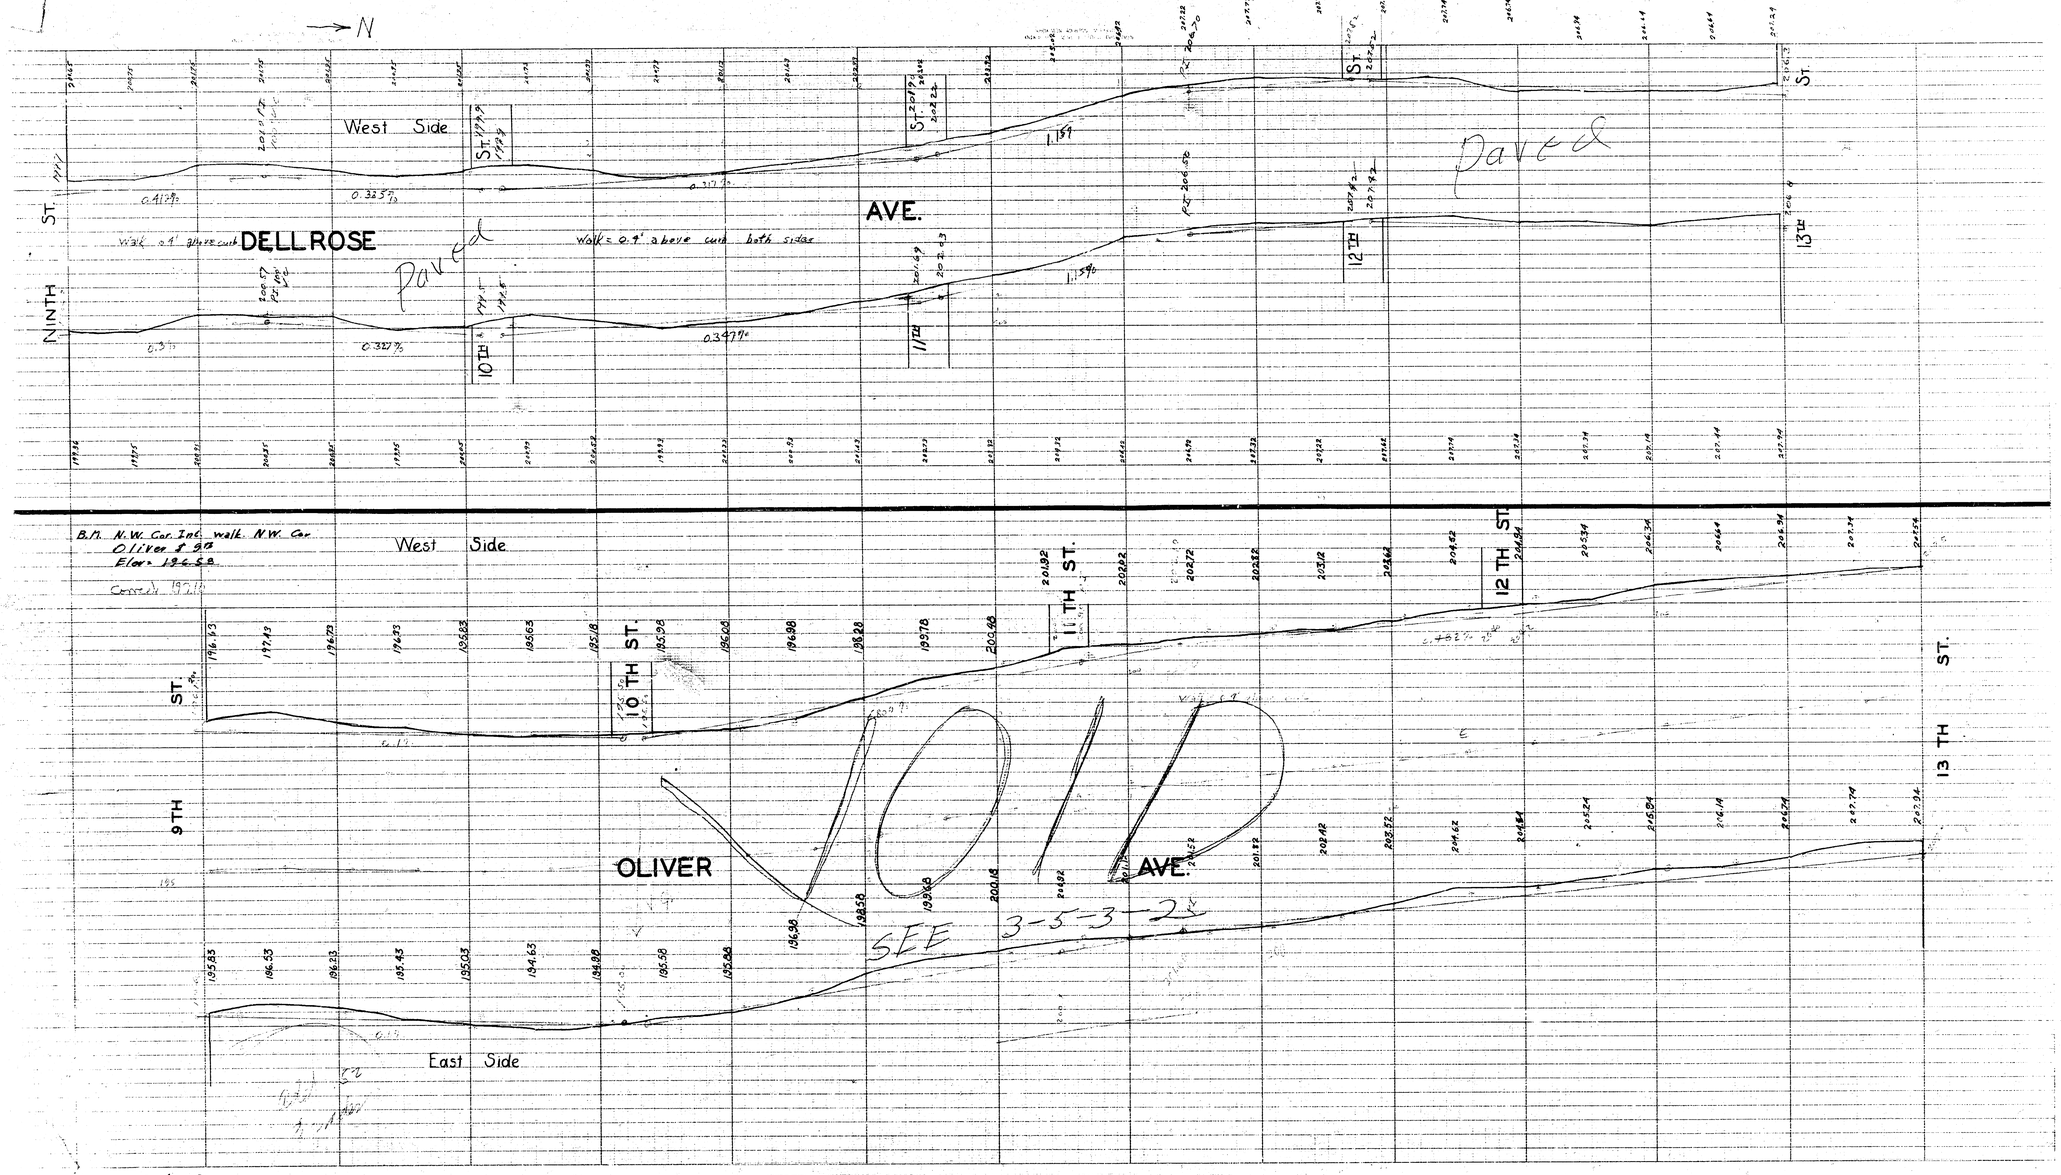
N
West Side
DELLROSE
AVE.
NINTH ST.
Walk 0.4' above curb
Walk = 0.4' above curb both sides
Paved
Paved
10TH
11TH
12TH
13TH
ST.
B.M. N.W. Cor. Inl. walk N.W. Cor.
Oliver & 9th
Elev = 196.58
Const. 1921
West Side
10 TH ST.
11 TH ST.
12 TH ST.
13 TH ST.
9TH ST.
OLIVER
AVE.
SEE 3-5-3-2
East Side

24-L