


5-61

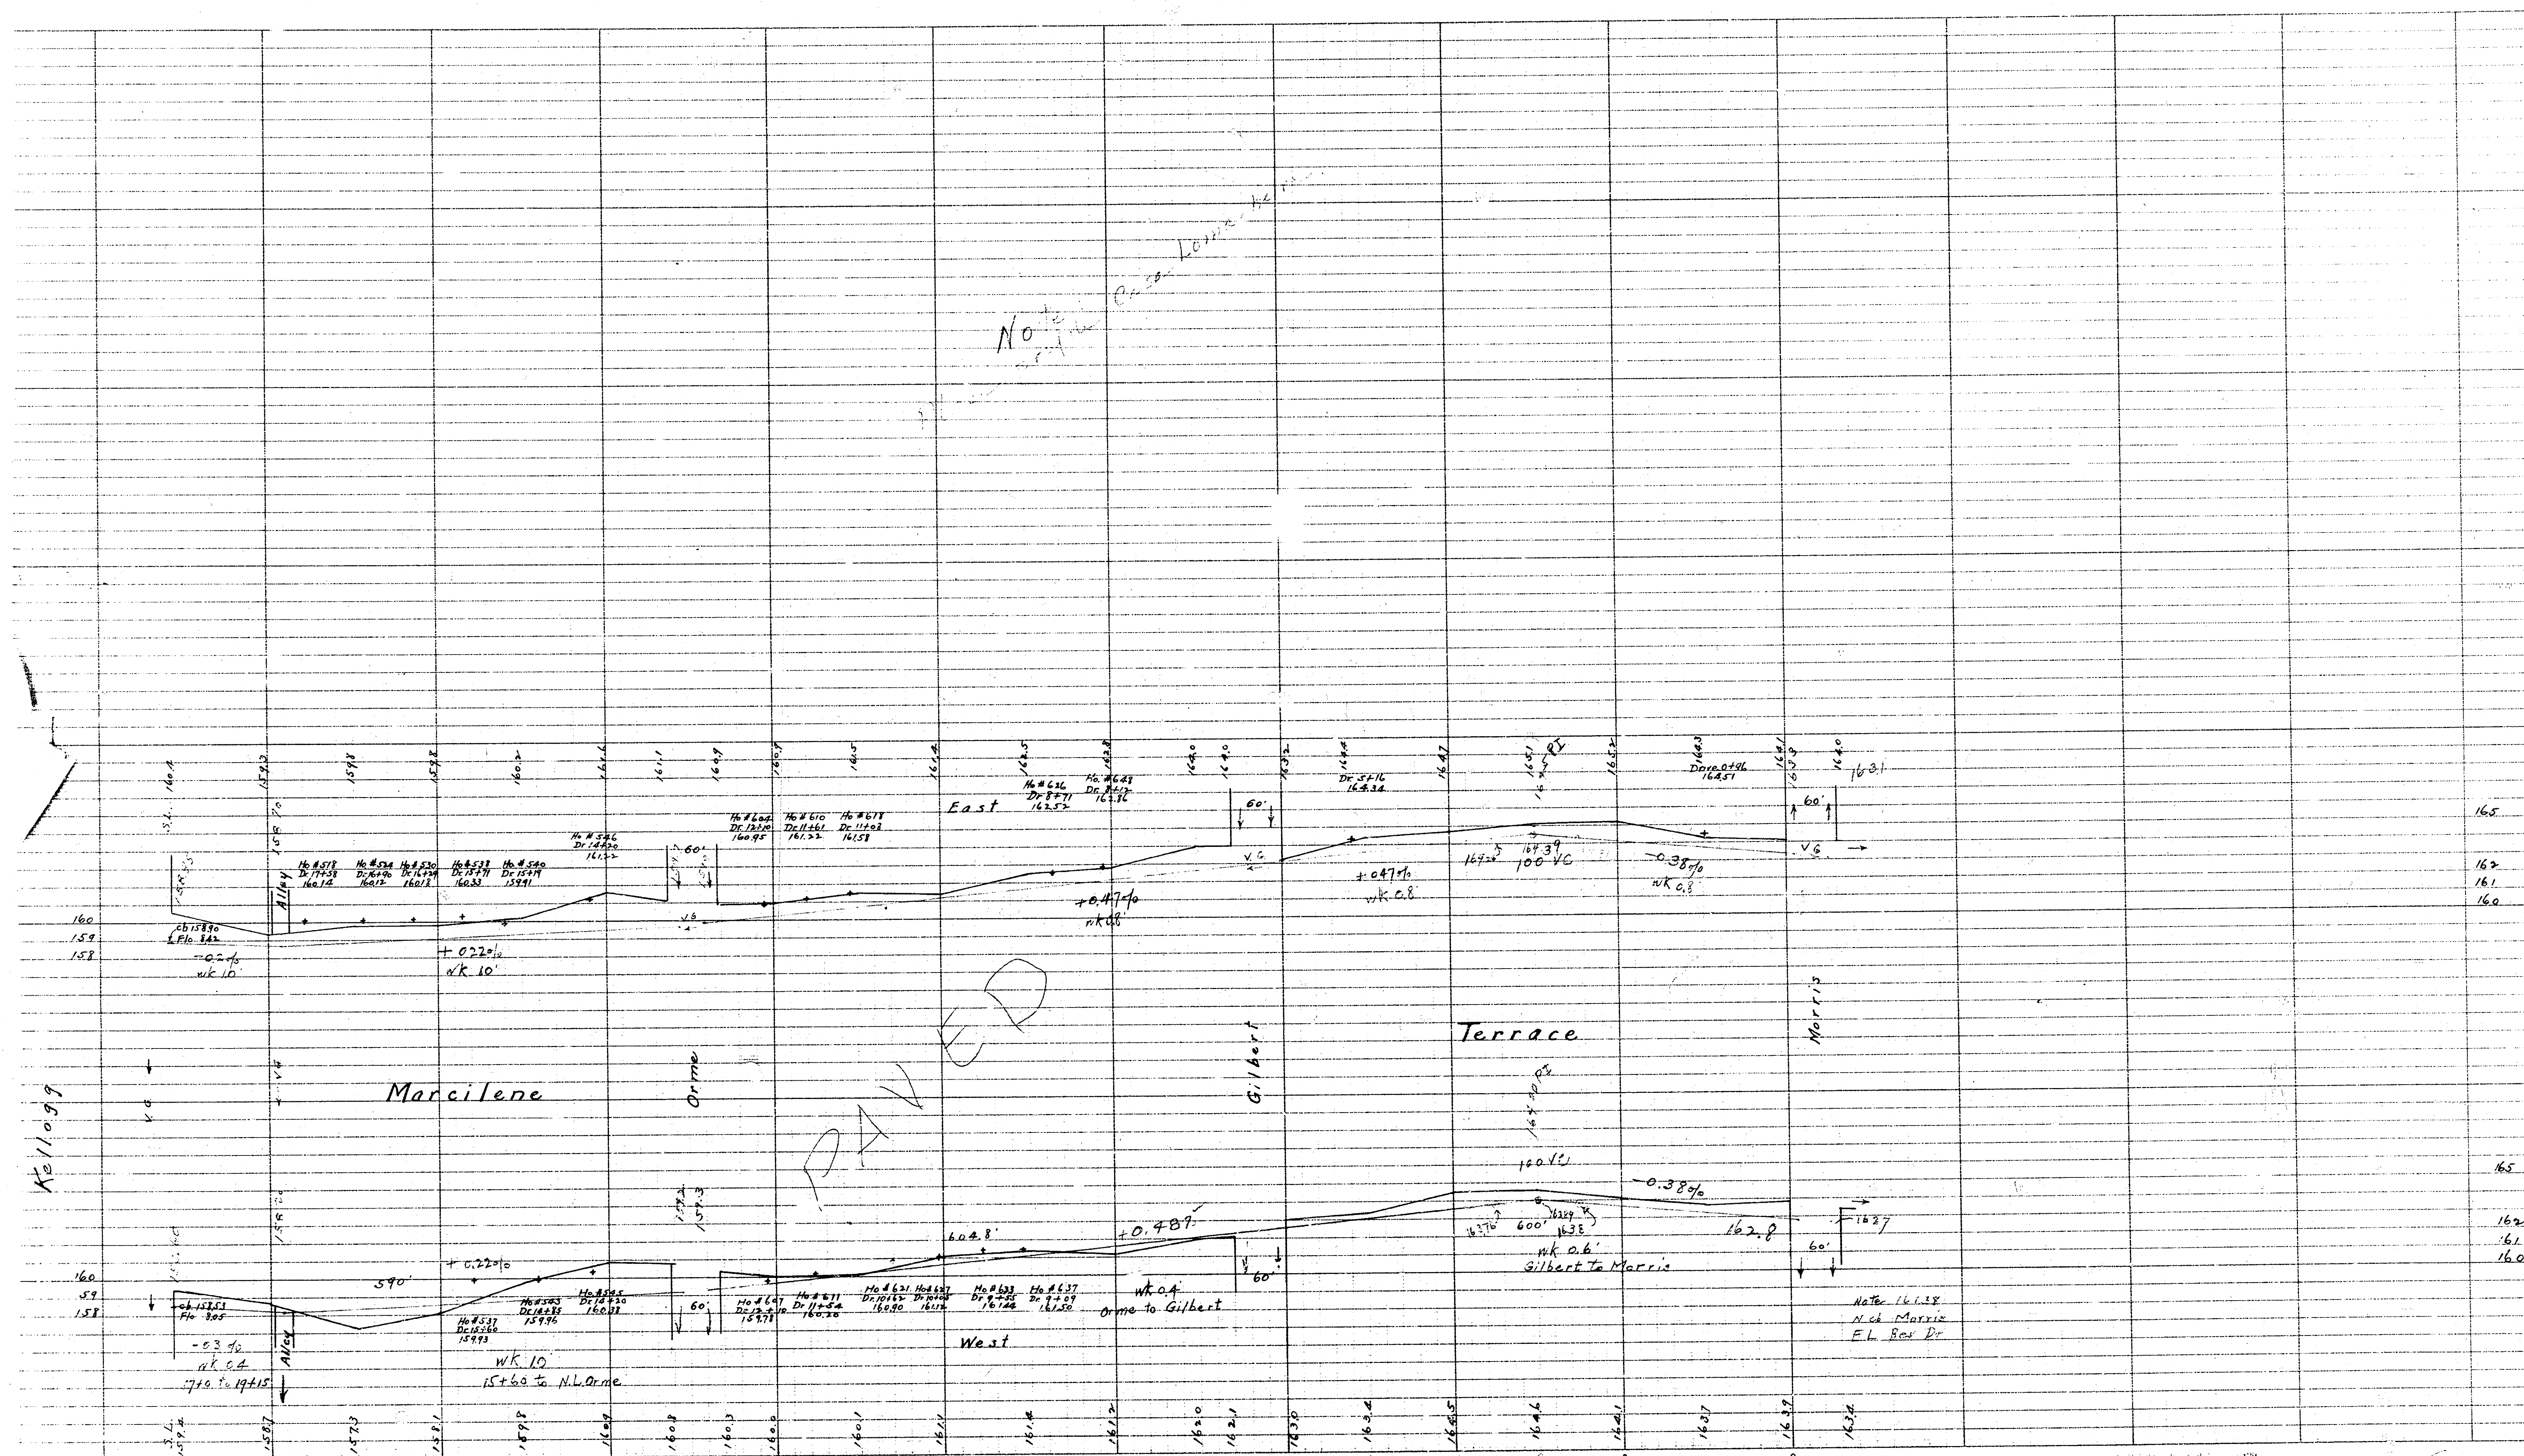

13-34

3-3-3