


23-N

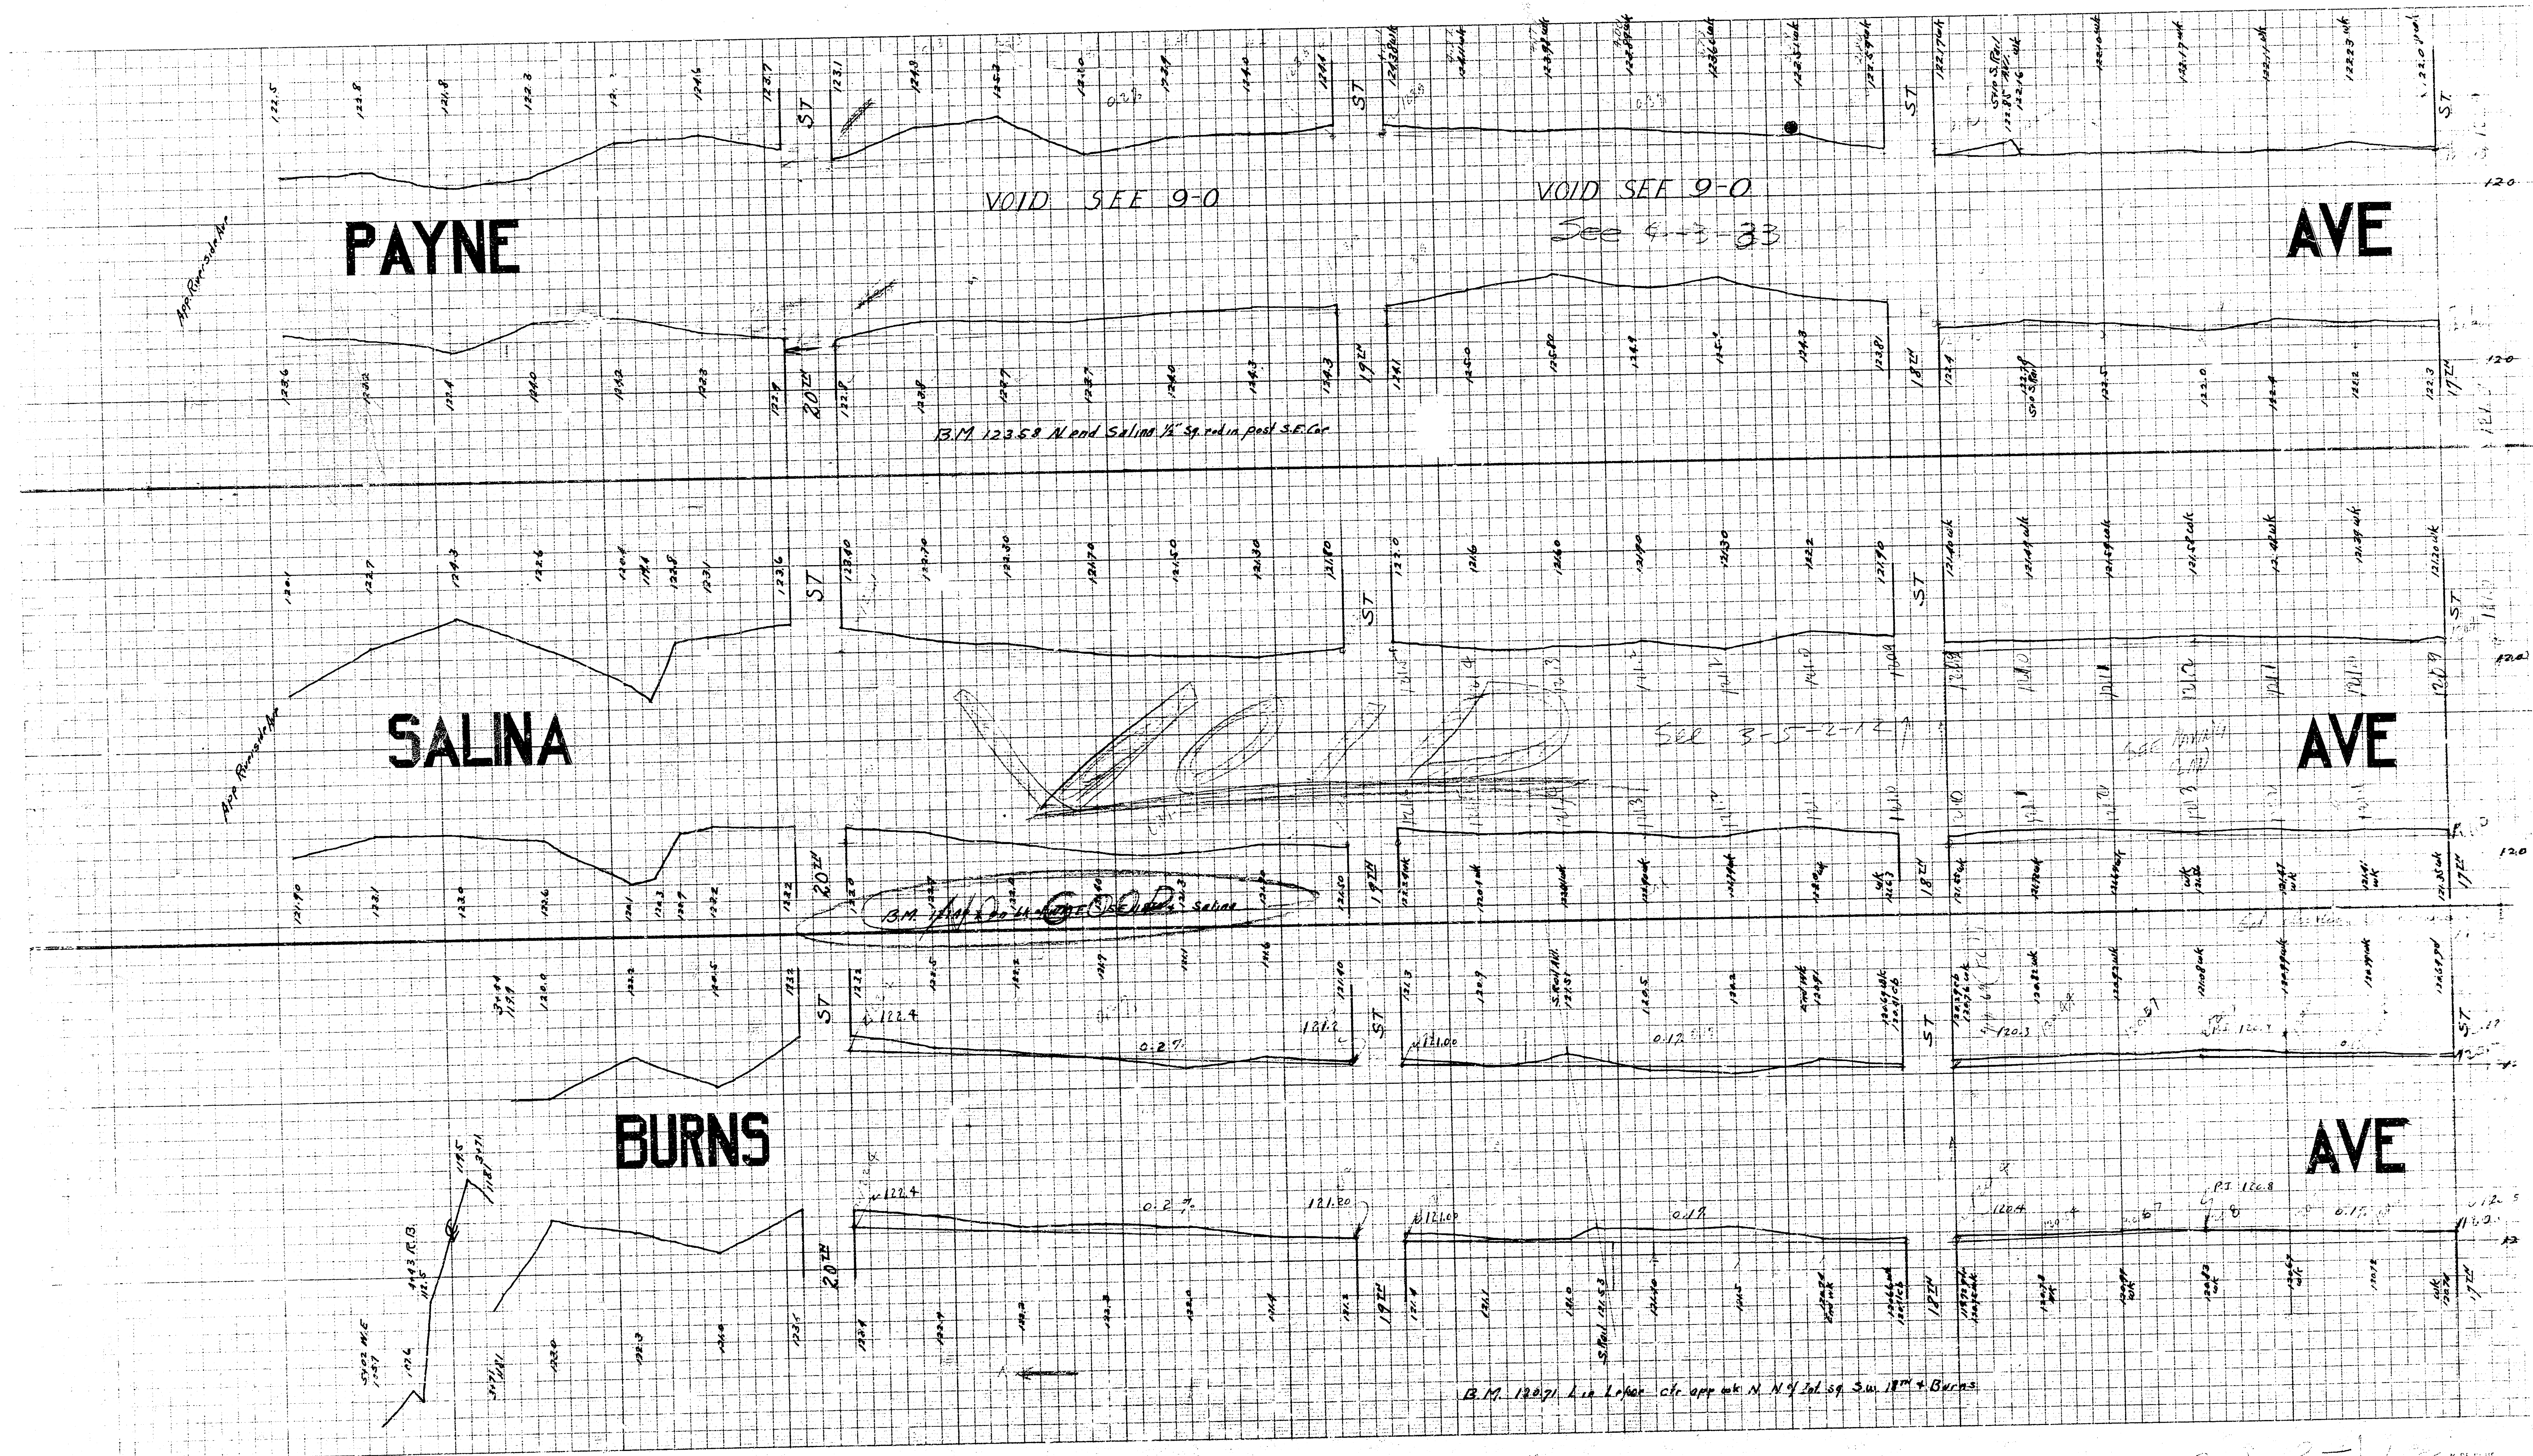

23-N

MADE IN USA

STANDARD PROFILE PLATE A 4 X 20
KUTTEL & ESSER CO NEW YORK

MADE IN USA

STANDARD PROFILE PLATE A 4 X 20
KUTTEL & ESSER CO NEW YORK

3-1-3-1

MADE IN USA