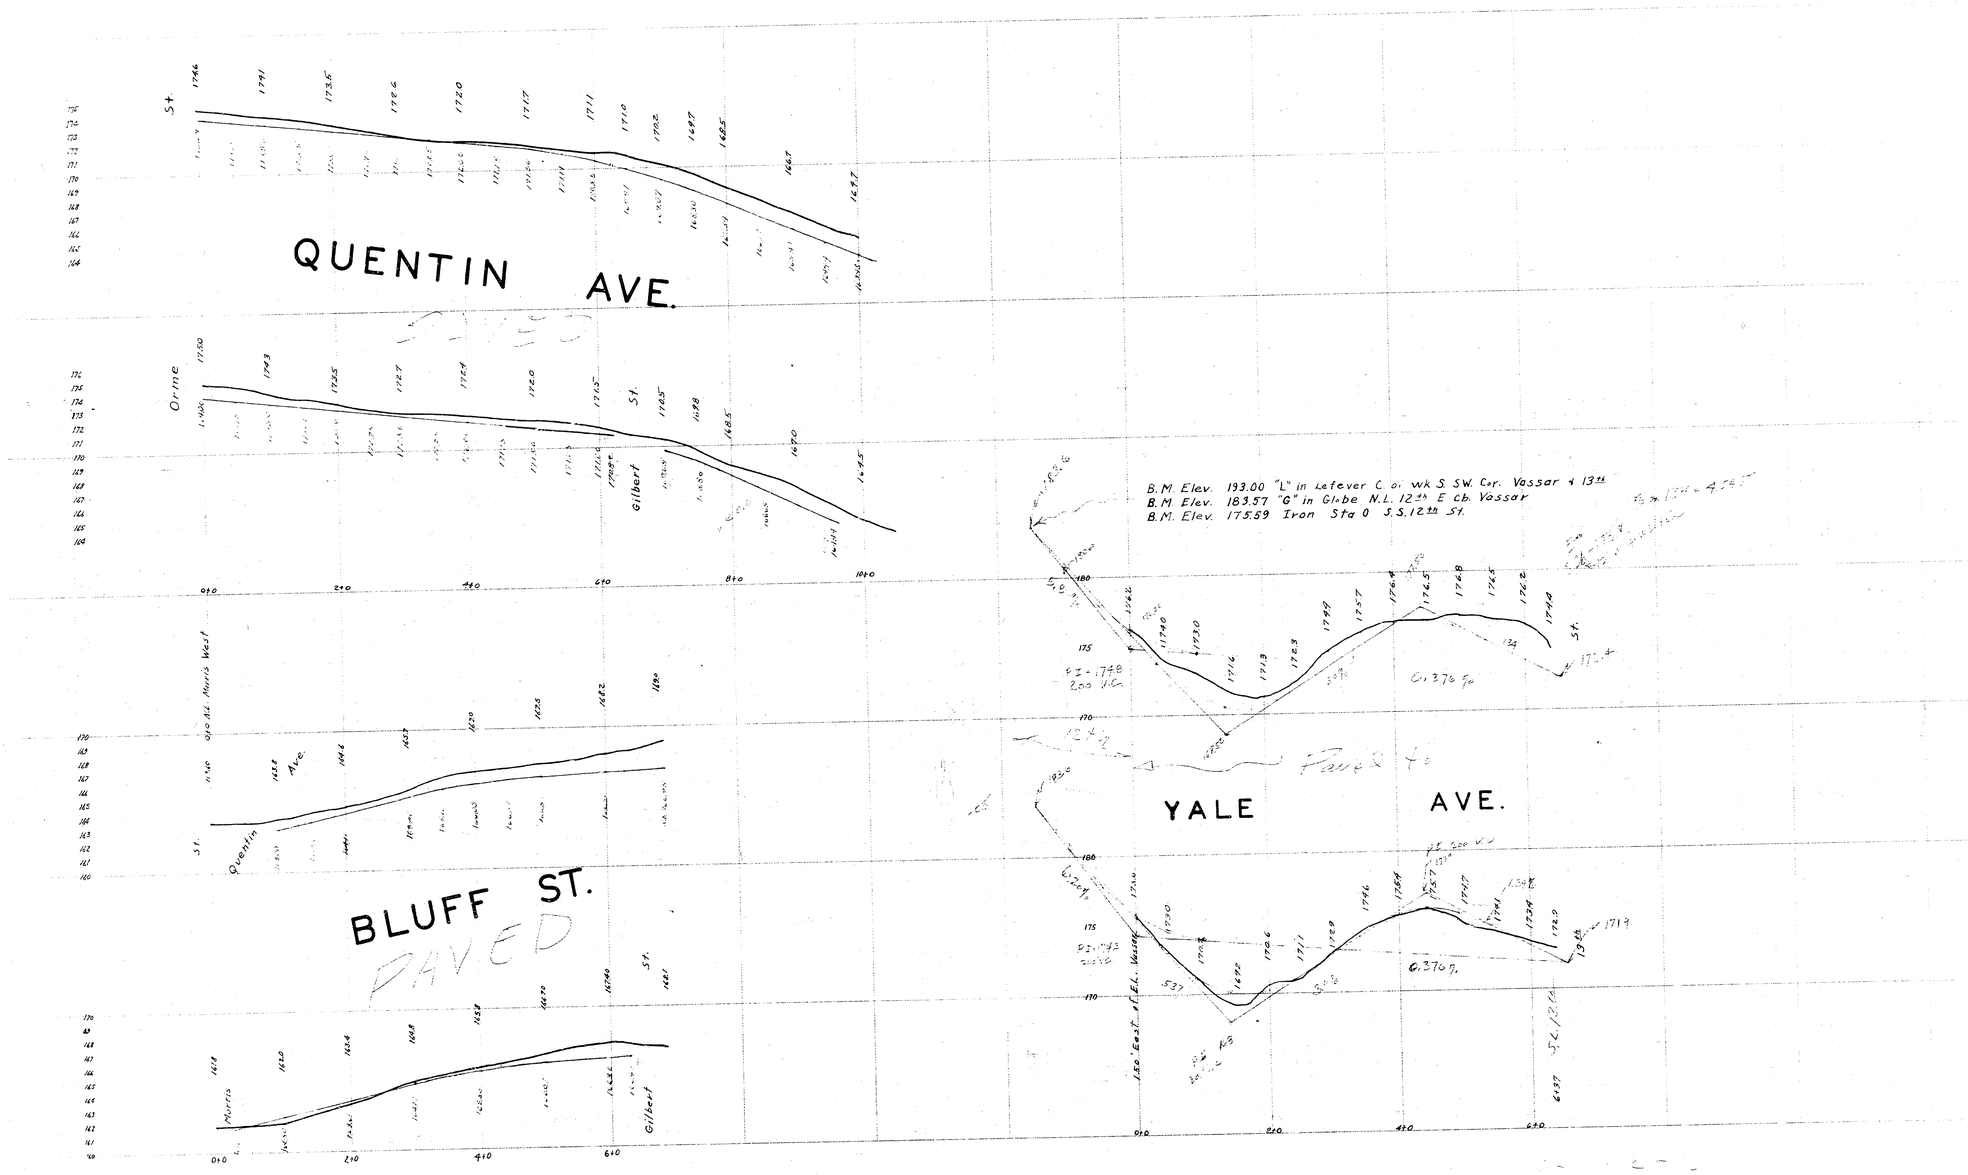
QUENTIN AVE.
Orme St.
Gilbert St.
B.M. Elev. 193.00 "L" in Lefever C. o. wk S. S.W. Cor. Vassar & 13th
B.M. Elev. 183.57 "G" in Globe N.L. 12th E cb. Vassar
B.M. Elev. 175.59 Iron Sta 0 S.S. 12th St.
YALE AVE.
BLUFF ST.
PAVED
Quentin Ave.
Morris
Gilbert