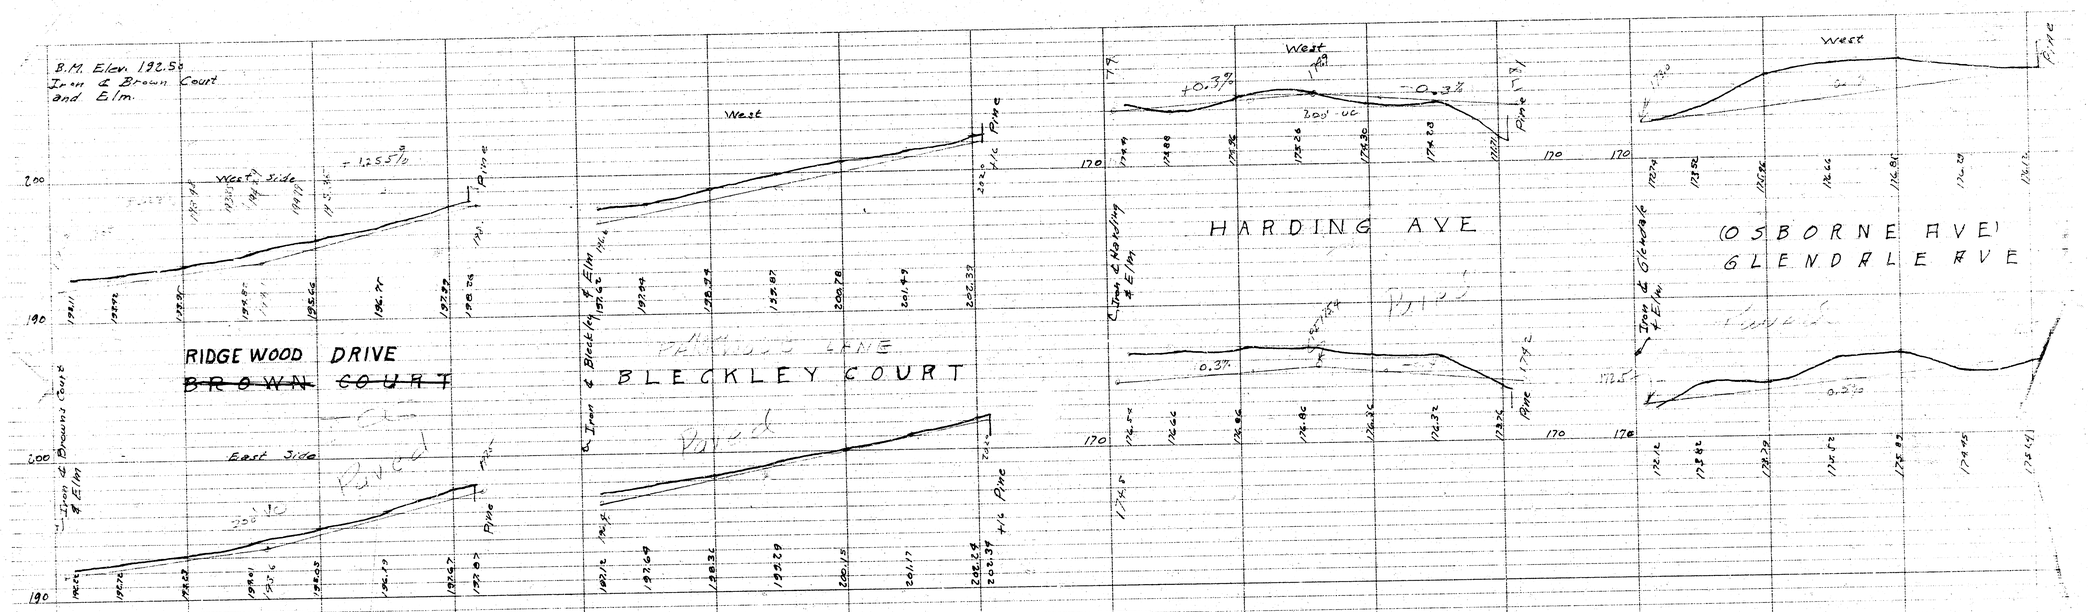
B.M. Elev. 192.59
Iron & Brown Court
and Elm.
RIDGE WOOD DRIVE
~~BROWN~~ ~~COURT~~
West Side
East Side
+1.25%
Pine
BLECKLEY COURT
West
HARDING AVE
+0.3%
-0.3%
0.3%
200' VC
OSBORNE AVE
GLENDALE AVE
Iron & Elm
Iron & Glendale
Iron & Brown Court & Elm
Iron & Bleckley & Elm
Iron & Harding & Elm
200
190
180
170