

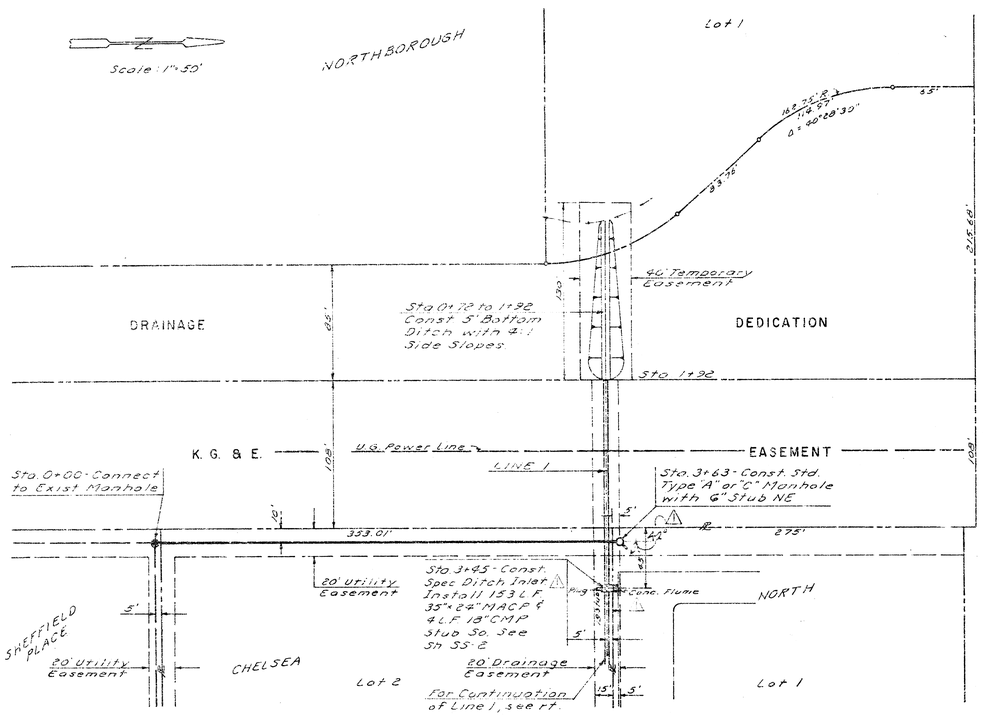


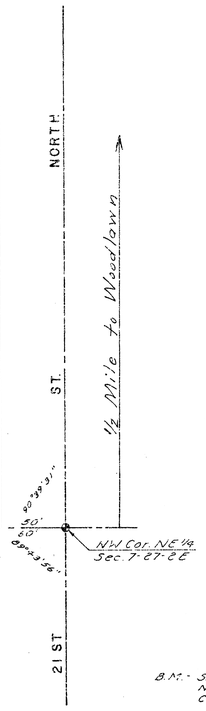


B.M. - S rim Bell Tele MH N. side elev on N¼ Cor. El. 1209.41

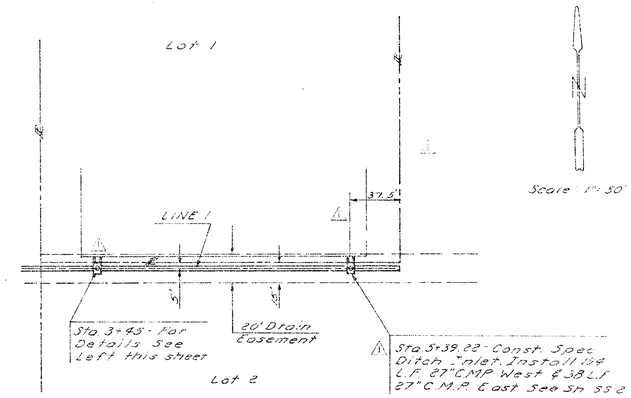

* **NOTE TO CONTRACTOR:** Beware of under-ground power line in K.G.&E. easement. K.G.&E. to be contacted prior to any excavation within their easement.


NOTE (1)

You are informed that such that a 12 kV underground line running north and south through this easement, before excavating you will contact Terry Young, Division Line Supervisor, at 1900 East Central, Phone 685-1415, and will have the underground line or be located. Any digging in the immediate vicinity of the line will be by hand & only then when a KGE representative is at the site.

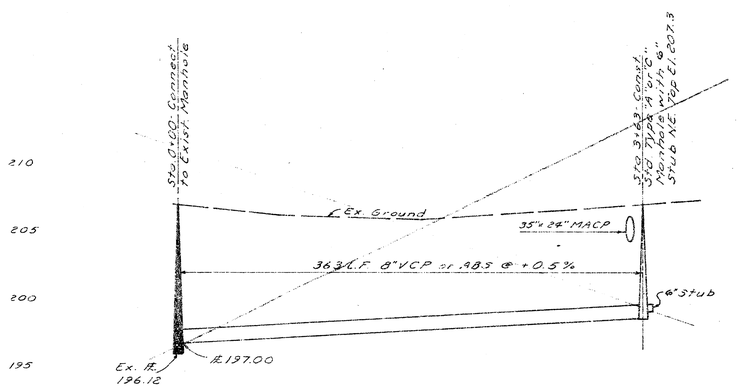



PROFILE - SANITARY SEWER


197.00 I.E. in 196.12 I.E. out	I.E. 197.50	I.E. 198.00	I.E. 198.50	I.E. in 198.88 I.E. out 198.82
0	1	2	3	

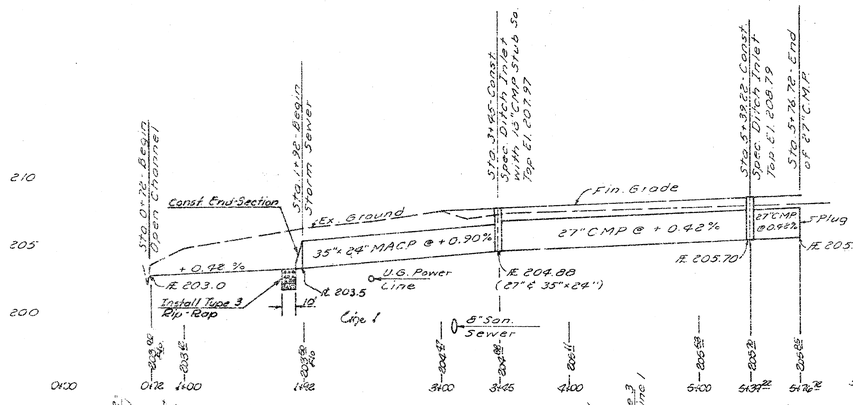

PROFILE - STORM SEWER

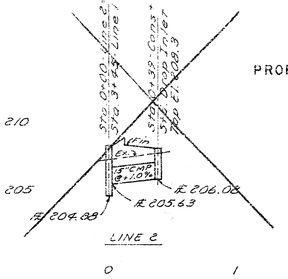

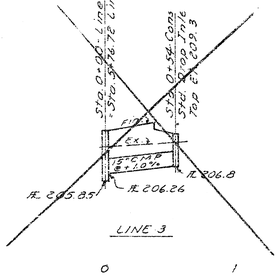

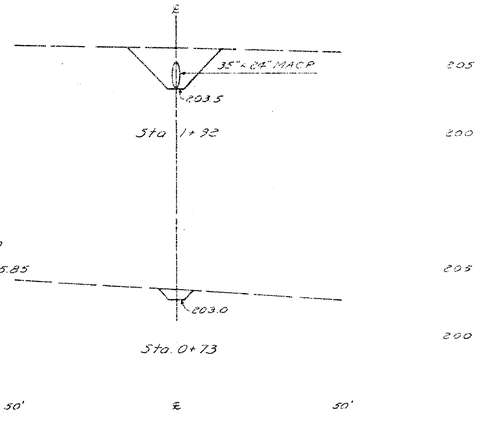

CHANNEL CROSS SECTIONS

Revised 4-13-81 (1)
Revised 11-12-80

S.W.S. No. 217

W. CHELSEA NORTH ADDN.


CITY OF WICHITA, KS.

R. W. BRUGGEMAN——DIR. ENGINEERING.


PROJECT NO.

468-76-245-81048-000-000-001


FILMED FROM THE BEST AVAILABLE COPY.....

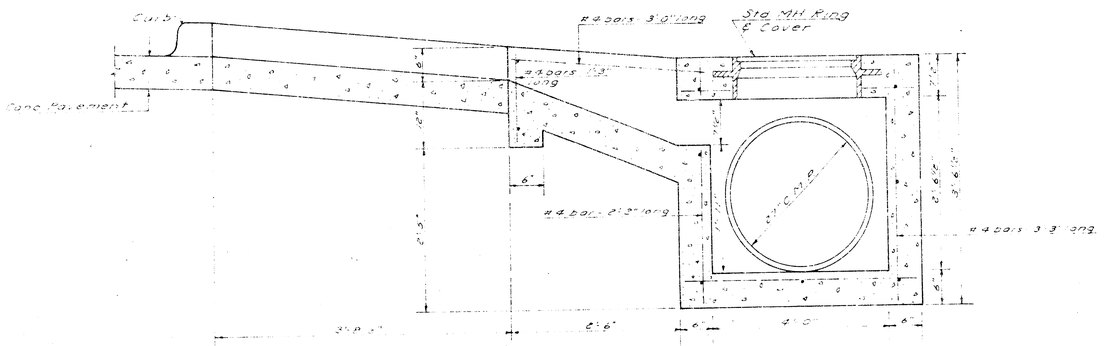

SECTION A-A

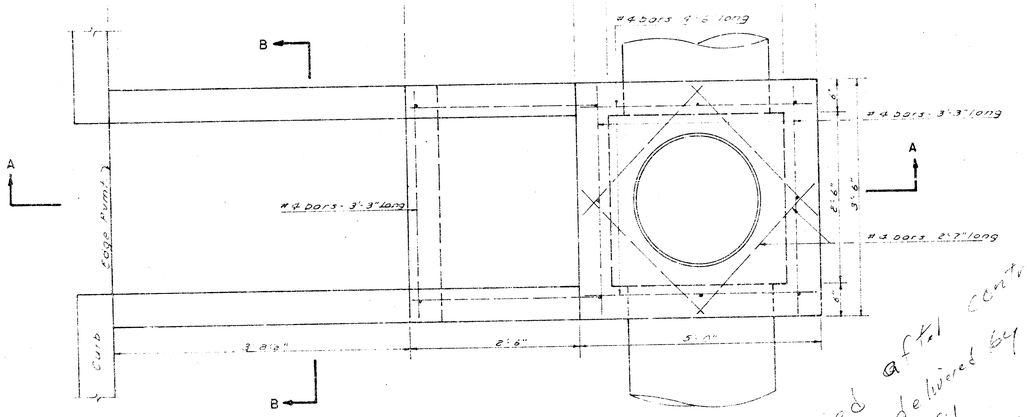

PLAN

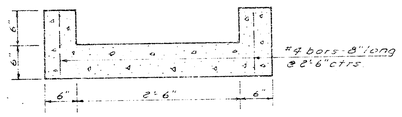

SECTION B-B

SPECIAL DITCH INLET DETAILS

Scale: 1"=1'0"

Revised after contract was let delivered by Baughman & Co 6-8-81

plans issued

revisions

date drawn

JEFF KREHBIEL ASSOCIATES, aia
architecture · planning

NORTHEAST FAMILY HEALTH CARE CENTER
THE EAST 6.5± STREET
WICHITA · KANSAS

sheet title
STORM INLET DTLS

sheet
SS2
of sheets

FILMED FROM THE BEST AVAILABLE COPY .....